

Lloyd's Register of British and Foreign Shipping.

(Report on Vessel No. 24313 Port Newcastle)

No. 300: SHIP FORGINGS OR CASTINGS.

I have to report that the undermentioned Iron or ~~Steel~~ Forgings or ~~Castings~~, manufactured by

Messrs The Palmers S B Co of Jarrow
for the Vessel No. , being built by "Charles Howard"
of Sunderland have been inspected by me as set forth below, and found
to be, so far as can be seen, Sound

mark on Forgings.

Lloyd's
No. 1575
86

John B Craig



Newcastle

7/6/90

	STERN FRAME.	RUDDER FRAME.	STEM.
Material*	/	Scrap iron	/
Made		Forged	
Dimensions		5 1/4 — 3	
Press on Inspection		Forged & Smithed	
Tests when Inspected {		May 28-31 June 3/90	

SKETCHES OF FRAMES SHEWING POSITION AND DESCRIPTION OF WELDS OF FORGINGS, OR PARTICULARS OF TESTS APPLIED TO CASTINGS.

See £3-3-0

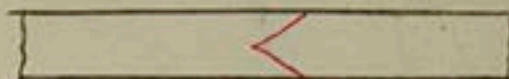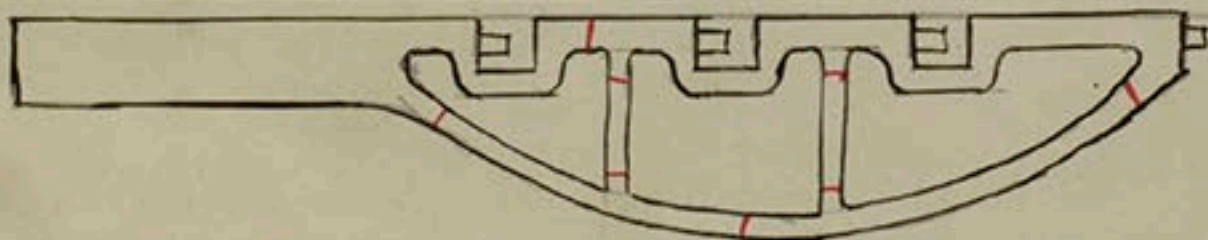

welds

* If of Iron, state whether scrap or puddled Iron.