



26/5/75

Rev 24/5/75

Sketch

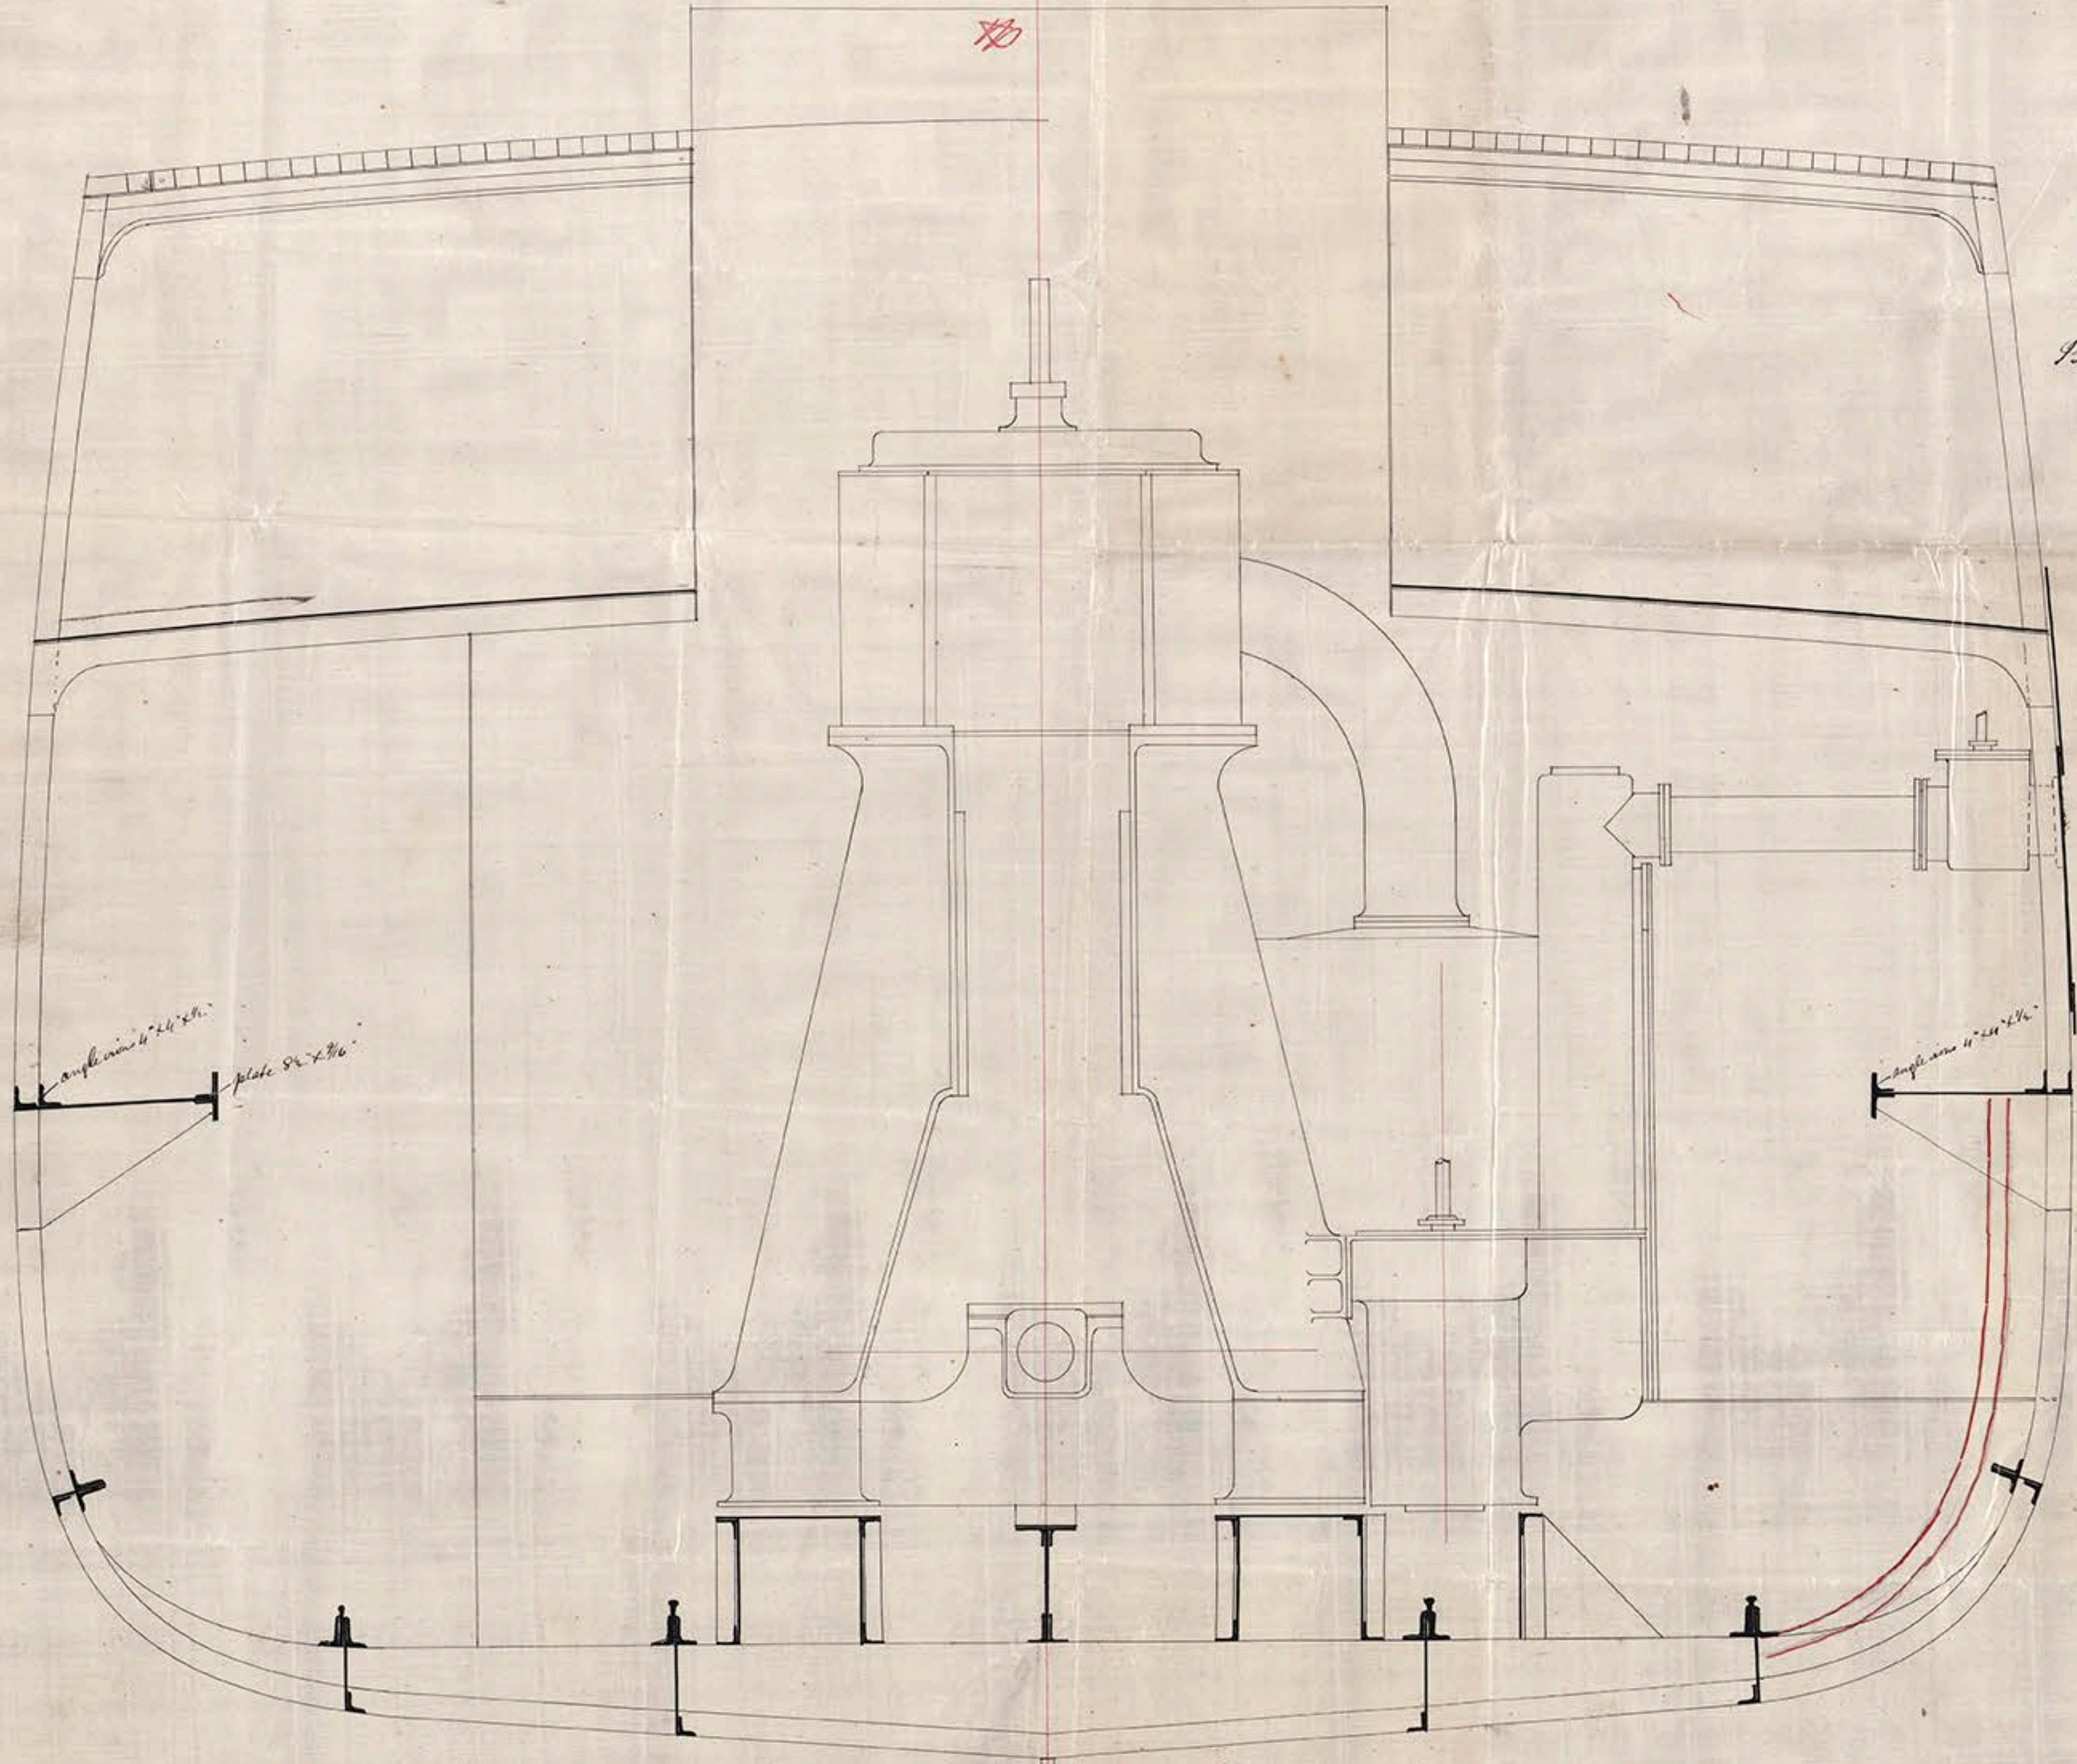

Engine & Boiler
Sketches of
H. 134 S.S.
Blackwood & Tinson
Castle Building Yards
Port Glasgow

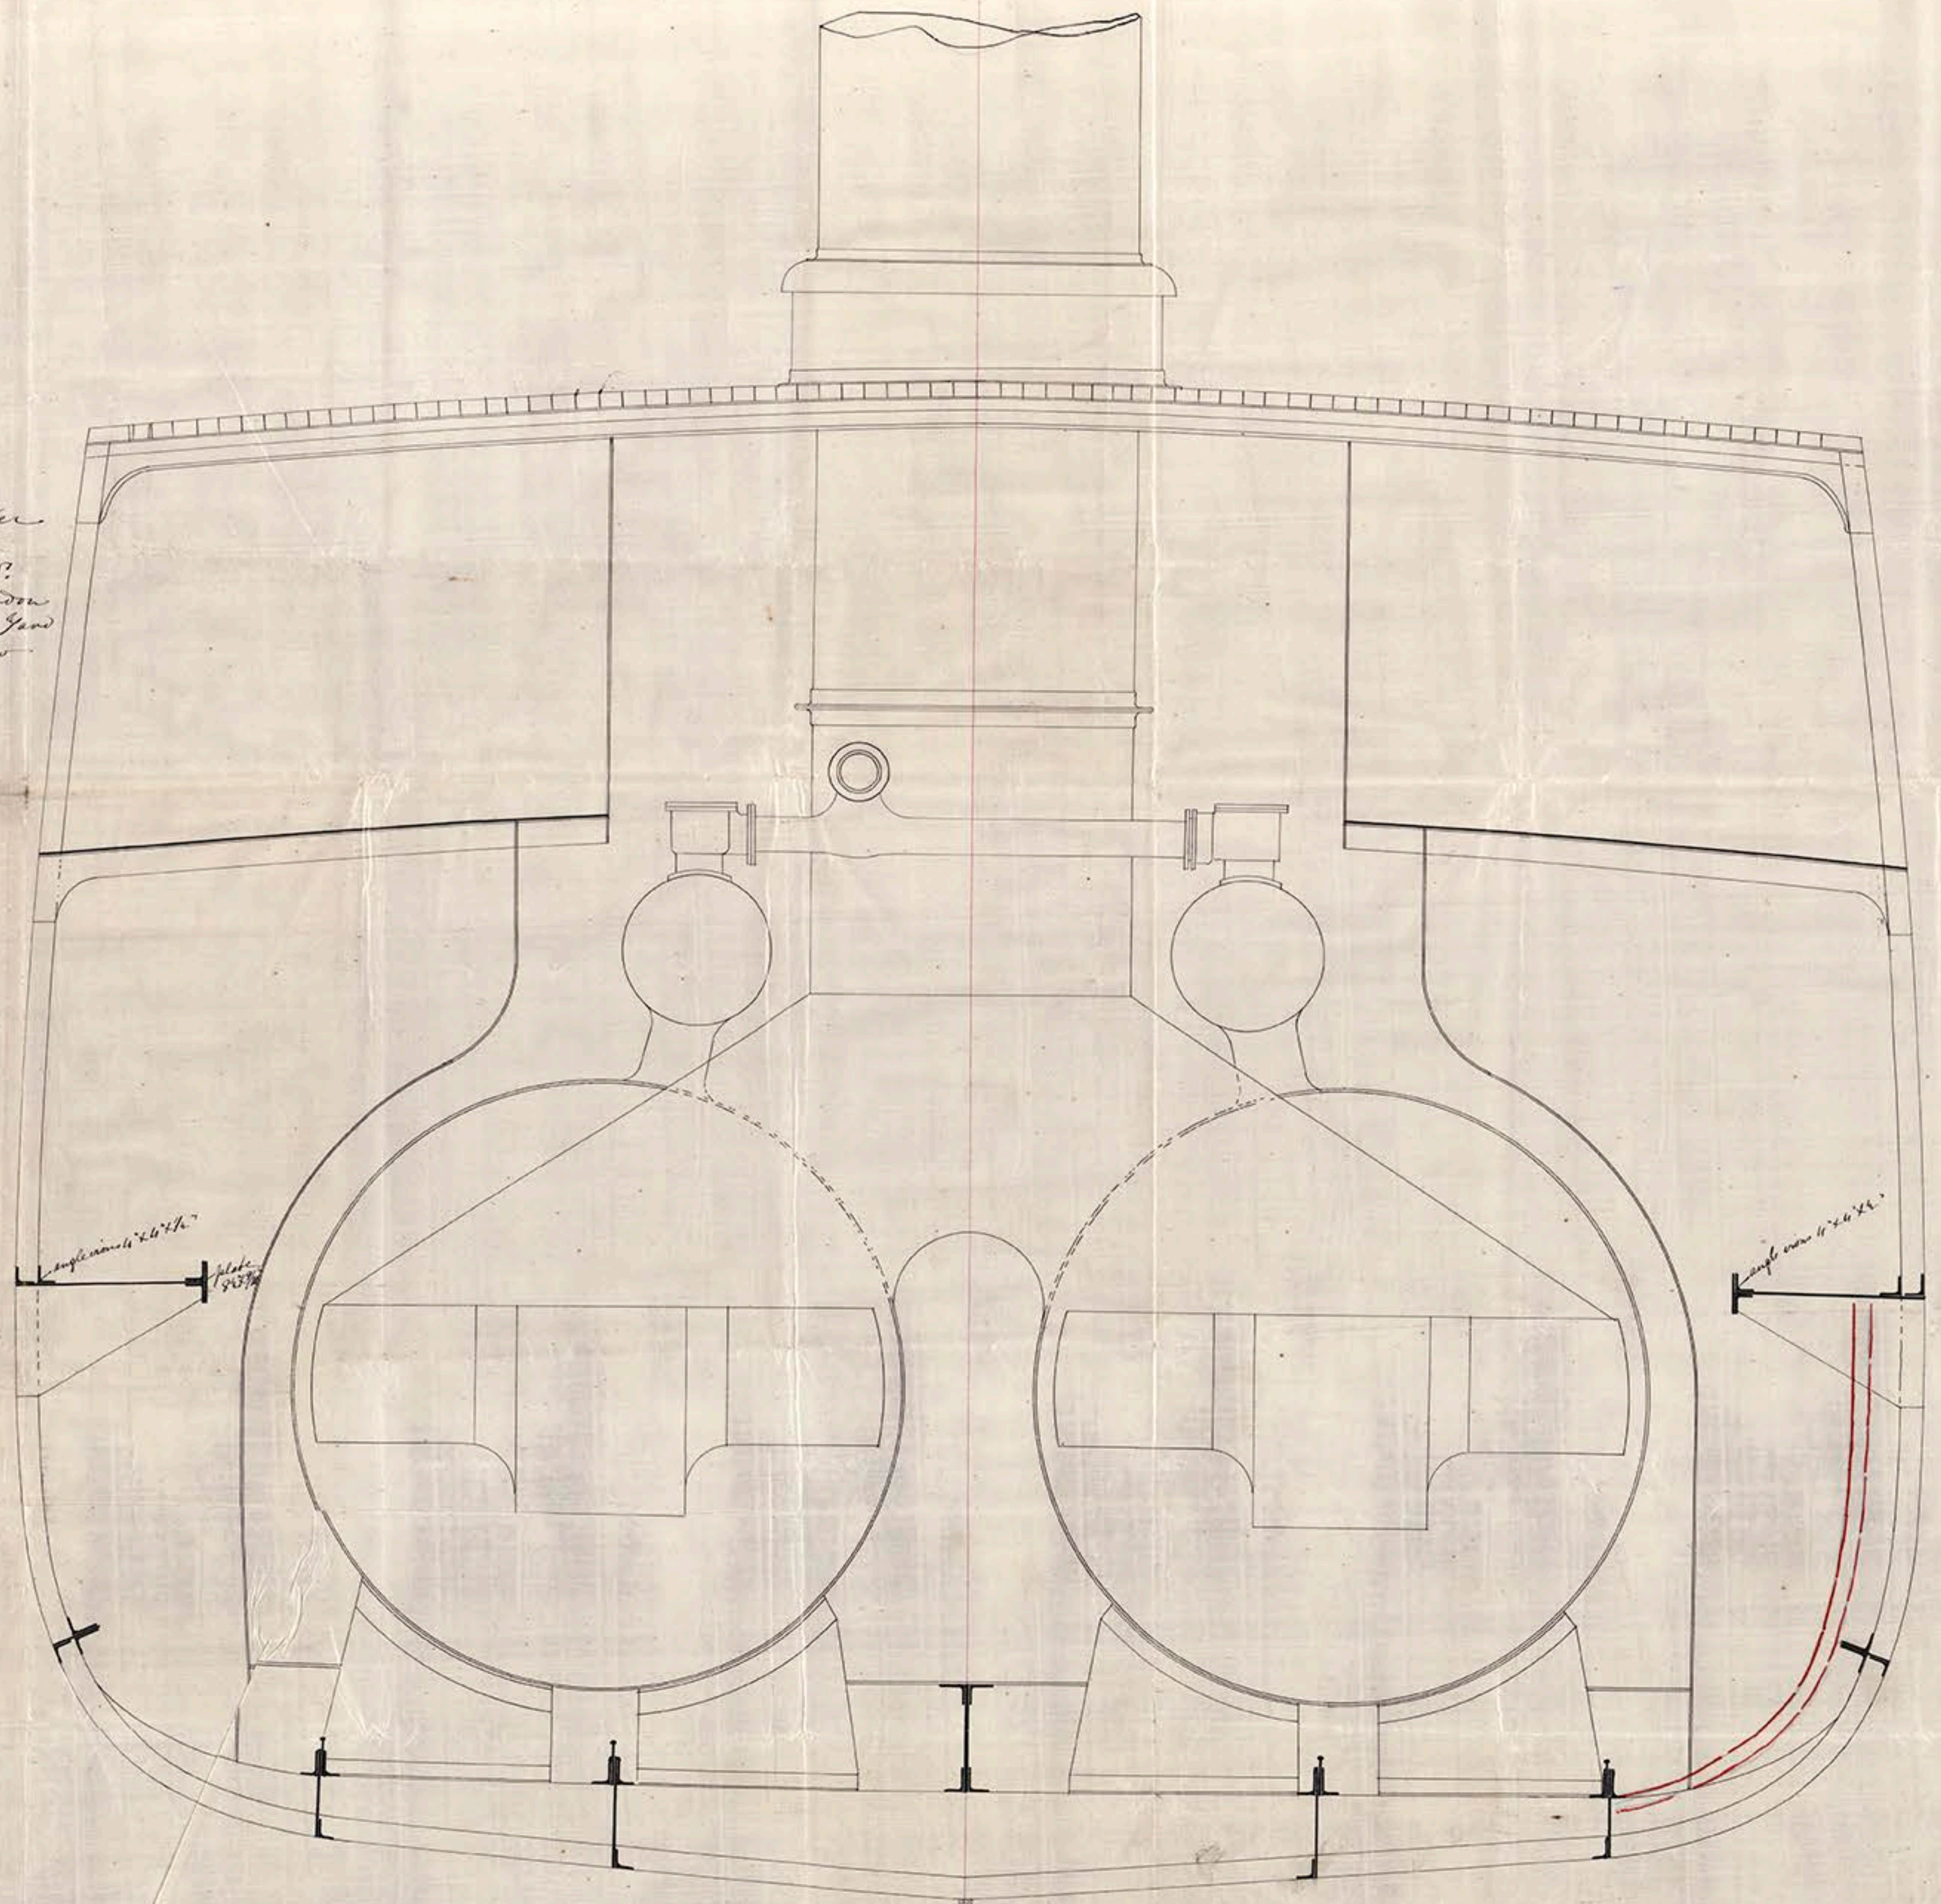

Scale 1/2" = one foot



© 2017 Lloyd's Register Foundation