

28 MAR 1929

Index No. 33213
(For London Office only.)

Lloyd's Register of Shipping.

SURVEYS FOR FREEBOARD. STEAM SHIPS.

GLASGOW REPORT No. 149021

PARTICULARS RELATING TO ALL STEAM SHIPS EITHER FLUSH DECKED, OR WITH TOP GALLANT FORECASTLES, SHORT POOPS AND BRIDGE HOUSES DISCONNECTED, OR WITH TOP GALLANT FORECASTLES HAVING LONG POOPS, OR RAISED QUARTER DECKS CONNECTED WITH BRIDGE HOUSES, OR OTHERWISE.

Wm. Beardmore & Co. No. 651

Port of Survey Glasgow
Date of Survey While building
Name of Surveyor J. W. Hocutt

Ship's Name.	Port of Registry and Nationality.	Official Number.	Gross Tonnage.	Date of Build.	Particulars of Classification.
MANUNDA				1929	100 A.I. with Freeboard.
Number in Register Book					

Registered dimensions from Ship's Register.	LENGTH.	BREADTH.	DEPTH.	UNDER DECK TONNAGE.
	430	60.25	26.1	4784.15
Length on LOADLINE.		Frame Depth 9 Rule 7 2 = 2 4 = 4 = .33	Ceiling 10 Sheer + .58 4 1/2 in. = .18 2 in. = .08 = .33	Peak Tanks 2 in. = .06 6 1/2 in. = .13 = .19
CORRECTED DIMENSIONS.	430	59.92	26.50	4768.15

Moulded Depth as measured..... 29' 6 1/2"
2 1/2" upper bulk 8' 11 1/4"
Addition for Keel below base line for draught record..... 3/4" inches.

NOTE. — If the depth is measured when vessel is afloat, the details of measurement should be reported.

CORRECTION FOR LENGTH.

Length of Ship on Loadline..... 430
Length in Table
Difference
Correction for 10ft., Table A. Table C.
× Difference divided by 10 (if required.)
If 1/10th length covered divide by 2

CORRECTION FOR IRON DECK.

Proportion covered, if less than 1/10th length covered
Thickness of usual wood deck, less stringer 3" on upper bulk

CORRECTION FOR ROUND OF BEAM.

Breadth at Gunwale amidships.....
Round of Beam 3" on 2" bulk 9" in upper 58"
Normal round.....
Difference + 2 =
Proportion of Deck uncovered (Para. 19)

NOTE. — The round of beam should be reported on the full breadth of vessel at the gunwale.

Co-efficient of fineness..... .697
Any modification necessary [Para. 4 (a) to (e)]*
Co-efficient as corrected68

Sheer { Stem 102 } 146 1/2 ÷ 2 = 73 1/4 ... Mean
at { Sternpost 44 1/4 }
Sheer at 1/2 of the length from { Stem 58 1/4 } 82 3/4 ÷ 2 = 41 1/8 ... Mean
{ Sternpost 24 1/2 }
Gradual mean Sheer 74
Standard mean Sheer [Table, Para. 18] 53 Correction
Difference 21 + 4 = 54
§ If limited as Para. 18 (f)

Rise in Sheer { At front of bridge house.....
from amidships { At after end of forecastle

Fall in Sheer {
Para. 18 (d) } + 2 =
Length uncovered ✓ Correction

ALLOWANCE FOR DECK ERECTIONS:—

Freeboard, Table C.....
Correction for Length, if required (Para. 12, 13, and 14)

Freeboard by Table A, corrected for sheer, and for length, if required (Para. 11, 12, 13, and 14)

Difference
Percentage as below.....

Correction for R. Q. Dk. if engine and boiler openings not covered by bridge house (Para. 11)
Allowance for Deck Erections

	Length.	Length allowed	Height.
Forecastle.....	82' 0"		8' 0"
Bridge House			
† Raised Qr. Dk.....			
Poop.....			
Total			
Length of Ship			
Corresponding percentage (Para. 11, 12, 13, or 14)			

FREEBOARD recommended amidships from centre of Disc to top of Statutory Deck Line, Wood (Steel) Deck:—

Fresh Water Line	above centre of Disc
Indian Summer Line	"	"	"	"	"	"	"	"	"
Winter Line	below	"	"	"	"	"	"	"	"
Winter North Atlantic Line	"	"	"	"	"	"	"	"	"

Winter Freeboard
Summer Freeboard
Indian Summer Freeboard
N. A. Winter Freeboard

Correction necessary because clearside amidships, measured in accordance with the Statute is not taken at the intersection of the wood or steel deck with side.

3" on upper deck 1 1/2" side on 2" bulk on 5th side
3" corner ribs on 2" bulk on Port side

Winter Freeboard from deck line
Summer " " " "
Indian Summer " " " "
N. A. Winter " " " "

brief C 21.4 mld. Draft
B. 77 Fresh Passenger Line
11845 tons
20m per inch 48.9

○ If the frames, ribs, planking, or ceiling are of unusual thickness the breadth of vessel to inside of ceiling should be reported if possible.
† In vessels obtaining an allowance for deck erections under Para. 11 where the sheer drops abaft amidships the height of the R.Q.D. is to be taken from the level of the top of the amidship beam.
§ In flush-decked vessels the total standard mean sheer means the sheer measured at the stem and sternpost. In vessels having poops and forecastles, it means the sheer measured at points distant one-eighth of the vessel's length from stem and sternpost.

* State dimensions of freeing port area on back of this form.
† The Surveyor should state whether the fall in sheer as reported is measured relatively to the line of keel or to the water line. If measured relatively to water line the vessel's draft at time of survey, and also the usual load draft forward and aft, should be reported.

Do all the Frames extend to the top height in the Poop? ☒ Raised Quarter Deck? ☒ Bridge House? ☒ Forecastle? ☒

To what height do the Reverse Frames extend? ☒

Has the Poop or Raised Quarter Deck an efficient Iron Bulkhead at the fore end? ☒

Give particulars of the means for closing the openings in Bulkhead ☒

Is the Poop or Raised Quarter Deck connected with the Bridge House? ☒ Has the Bridge House an efficient Bulkhead at the fore end? ☒

Give particulars of the means for closing the openings in Bulkhead ☒

What is the thickness of the Bridge Front plating? ☒ and Coaming plate? ☒

Give scantlings and spacing of the Stiffeners ☒

Are bracket plates fitted at each end of the Stiffeners? ☒ Are hor'l. brackets fitted connecting Bridge Bulk'd. with Bulwarks? ☒

Has the Bridge House an efficient Iron Bulkhead at the after end? ☒

How are the openings closed? ☒

Is the Forecastle at least as high as the main or top-gallant rail? ☒ Has the Forecastle an efficient Iron Bulk'd. at after end? ☒

Are the Engine and Boiler openings covered by a Bridge, Poop, Raised Quarter Deck, or enclosed by a Strong Iron or Steel Deckhouse? ☒ Casings inside of that deck house

If the openings are not so protected are the exposed parts of the Casings efficiently constructed? ☒

Give thickness of plating; scantlings and spacing of Stiffeners ☒

What is the height of the exposed Casings? ☒ Are suitable means provided for closing all openings in them in bad weather? ☒

Are the Weather Deck Hatchways efficiently constructed and at least equal to the requirements of Section 28 of the Rules for 1904-5? Give particulars below:—

Position and Size.		11' 6" on Deck 15' 9" x 12' 0"		11' 2" 24' 6" x 16' 0"		15' 15' 0" x 15' 0"		25' 0" x 15' 0"		17' 6" x 15' 0"	
Item.		Ship.	Rule.	Ship.	Rule.	Ship.	Rule.	Ship.	Rule.	Ship.	Rule.
COAMING.	Height above top of DECK	34"		30		30		30		30	
	Thickness {	Sides	.44	.44	.44	.44	.44	.44	.44	.44	.44
		Ends	.44	.44	.44	.44	.44	.44	.44	.44	.44
SHIFTING BEAMS OR WEB PLATES	Number	3		4		2		4		3	
	Section and Scantlings	12" x 30 3 x 3 x 40		14" 34		11 1/2" x 31 3 1/2" x 3 x 40		11 1/2" x 31 3 1/2" x 3 x 40		11 1/2" x 32 3 1/2" x 3 x 40	
	Material	Steel		Steel		Steel		Steel		Steel	
* FORE AND AFTERS.	Number										
	Section and Scantlings										
	Material										
HATCHES Thickness		2 1/2		3		3 1/2		2 1/2		2 1/2	
Remarks											

* The depth of Fore and Afters should be stated from the underside of the hatches in all cases.

(If the sill of the lowest side scuttle will be less than 6 inches above the Indian Summer Load Line if assigned under the tables, state vertical distance from top of deck at side amidships to lower edge of lowest side scuttle.)

The following information is to be given in all Cases of vessels dealt with under Paras. 11, 12 (under 15 feet Moulded depth) and under Shelter Deck Rules.

What is the thickness of the Bridge Sheerstrake?

Strake between Main and Bridge Sheerstrakes?


Delete the words { The Crew are, are not, berthed in the bridge house.
that do not apply { The arrangements to enable them to get backwards and forwards from their quarters are, are not satisfactory.

Length of Bulwarks in well

Area of Freeing Ports required by Para. 11 (e) each side of vessel = Sq. ft.

Ft. Tenths. Ft. Tenths. No. } Freeing Ports (each side of vessel) = Sq. ft.

Total deficiency or excess = Sq. ft.

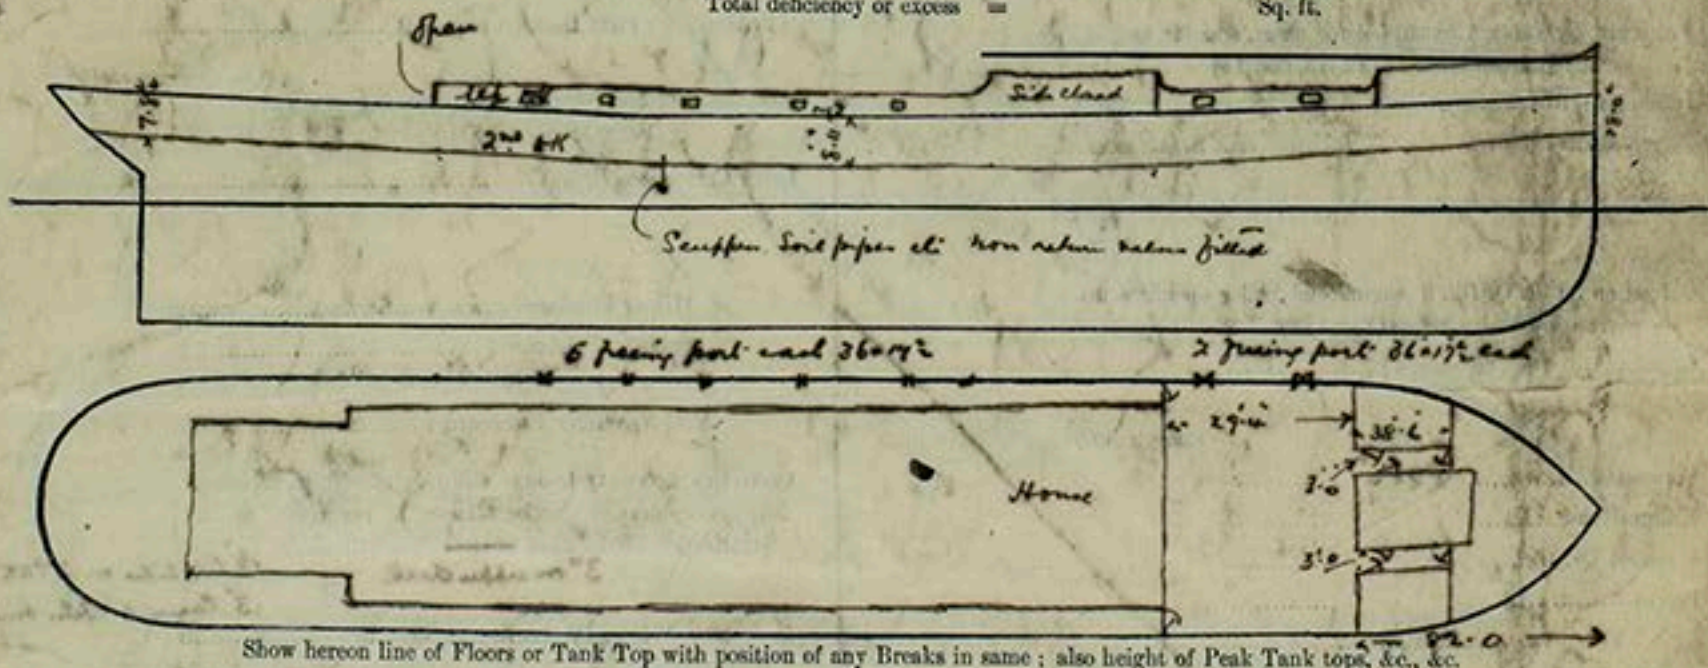

Show hereon line of Floors or Tank Top with position of any Breaks in same; also height of Peak Tank tops, &c., &c.

State any special features in the construction of the Vessel

Builder's name and yard number

Names of sister vessels

Owners

Address

Fee £

Received by me

for F.B. Report



© 2018
Lloyd's Register
Foundation