

Sci. Stm. "Gellivara" Huc. Report No. 21562


Dr. to Beams. Sketch showing proposed scantlings
of Side Plating & Stringers.

2.2.88.

S. S. N^o 103

Scale $\frac{1}{2}'' = 1$ foot.

Jan^y 28/88
N^o 6466.

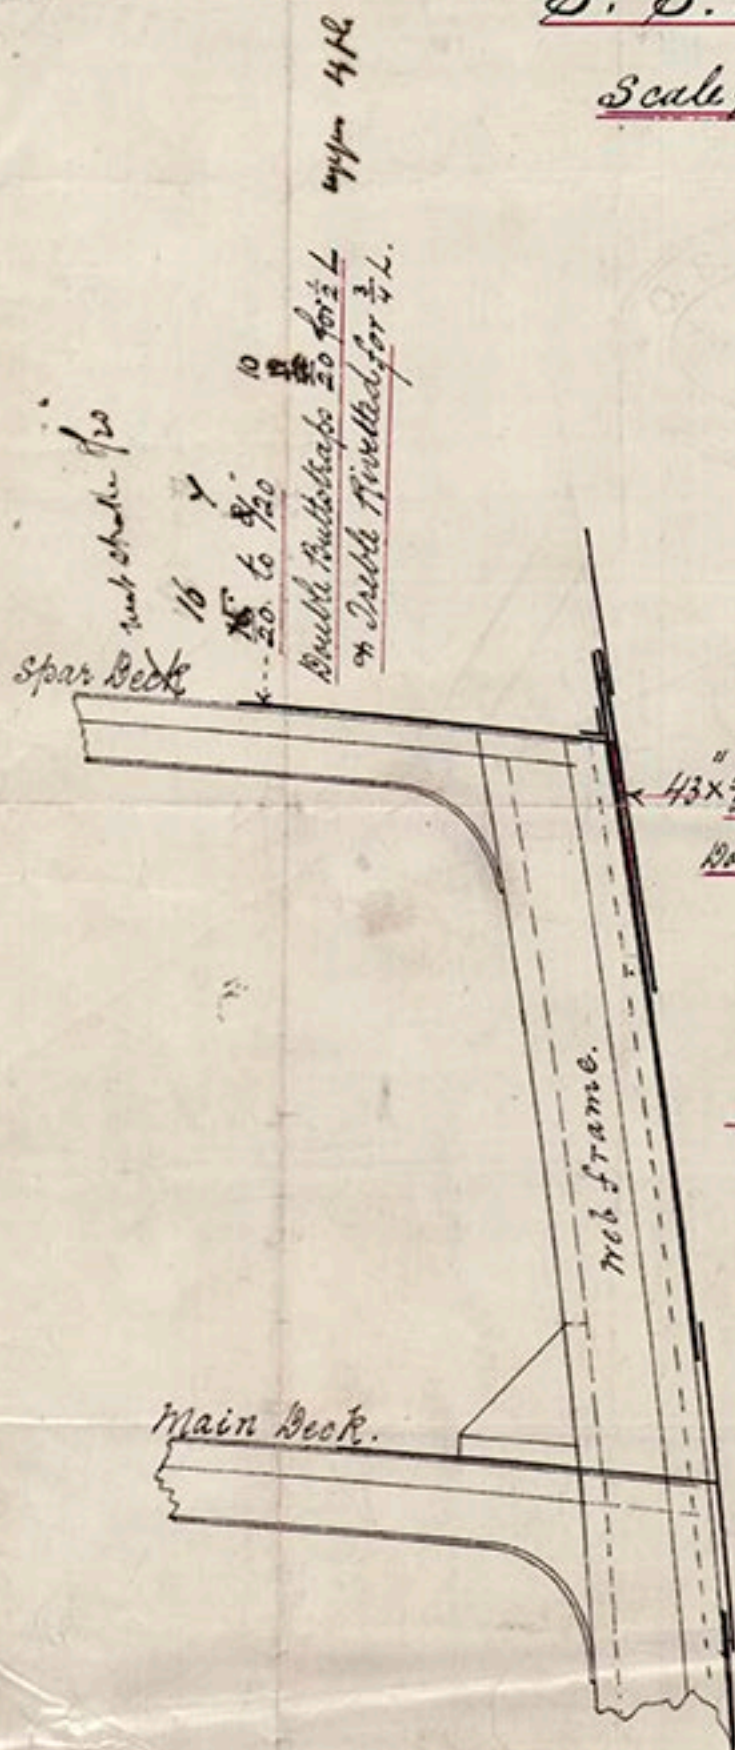

$3 \times \frac{12}{20}$ to $\frac{9}{20}$ is
Doubled with $\frac{2}{20}$ plates.

43 as per longitudinal plane
78
20 to 20

Double buttstraps for $\frac{1}{2} L$ } ~~over~~ over 4 pl
3 $\frac{1}{2}$ riveted for $\frac{3}{4} L$.





1/2








© 2018
Lloyd's Register
Foundation

LR-FAF-T83-P-5

RECEIVED
20 JAN 88
LONDON