



13/3/88


Sew. Str. "Gellivara" Rve. Report No. 21562  
FOREMAST

 

MAIN MAST

 

LOWER YARD

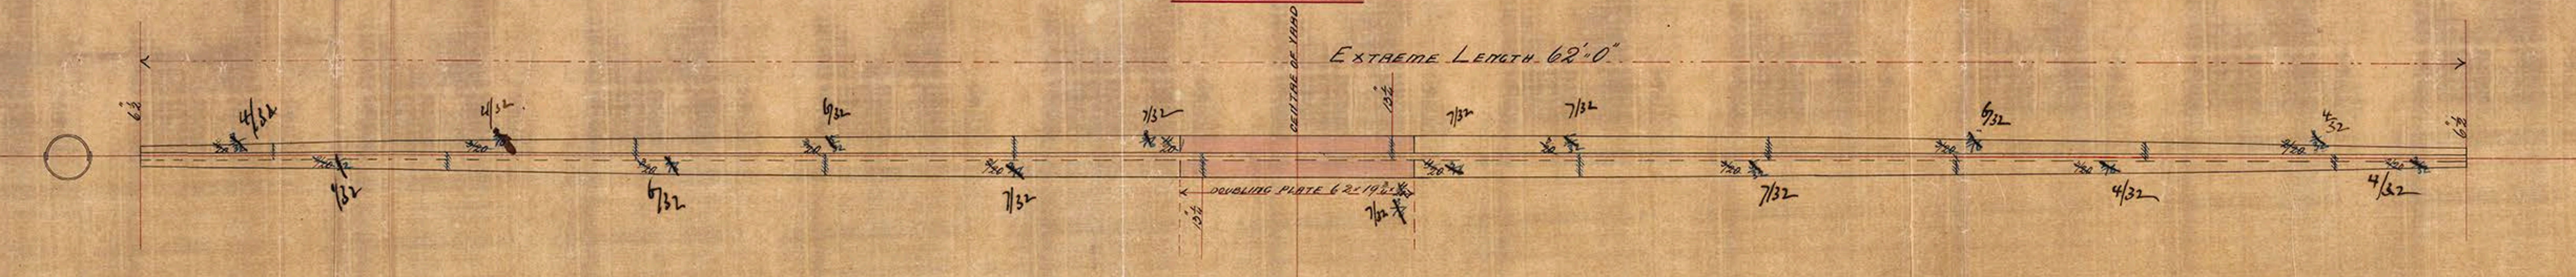

STEEL MASTS & YARD

No 103 SHIP

July 29<sup>th</sup> 1888  
 1786499