


407-98

S.S. N<sup>o</sup> 460

ENGINE AND BOILER ARRANGEMENT

SCALE 1/4" = 1 FOOT

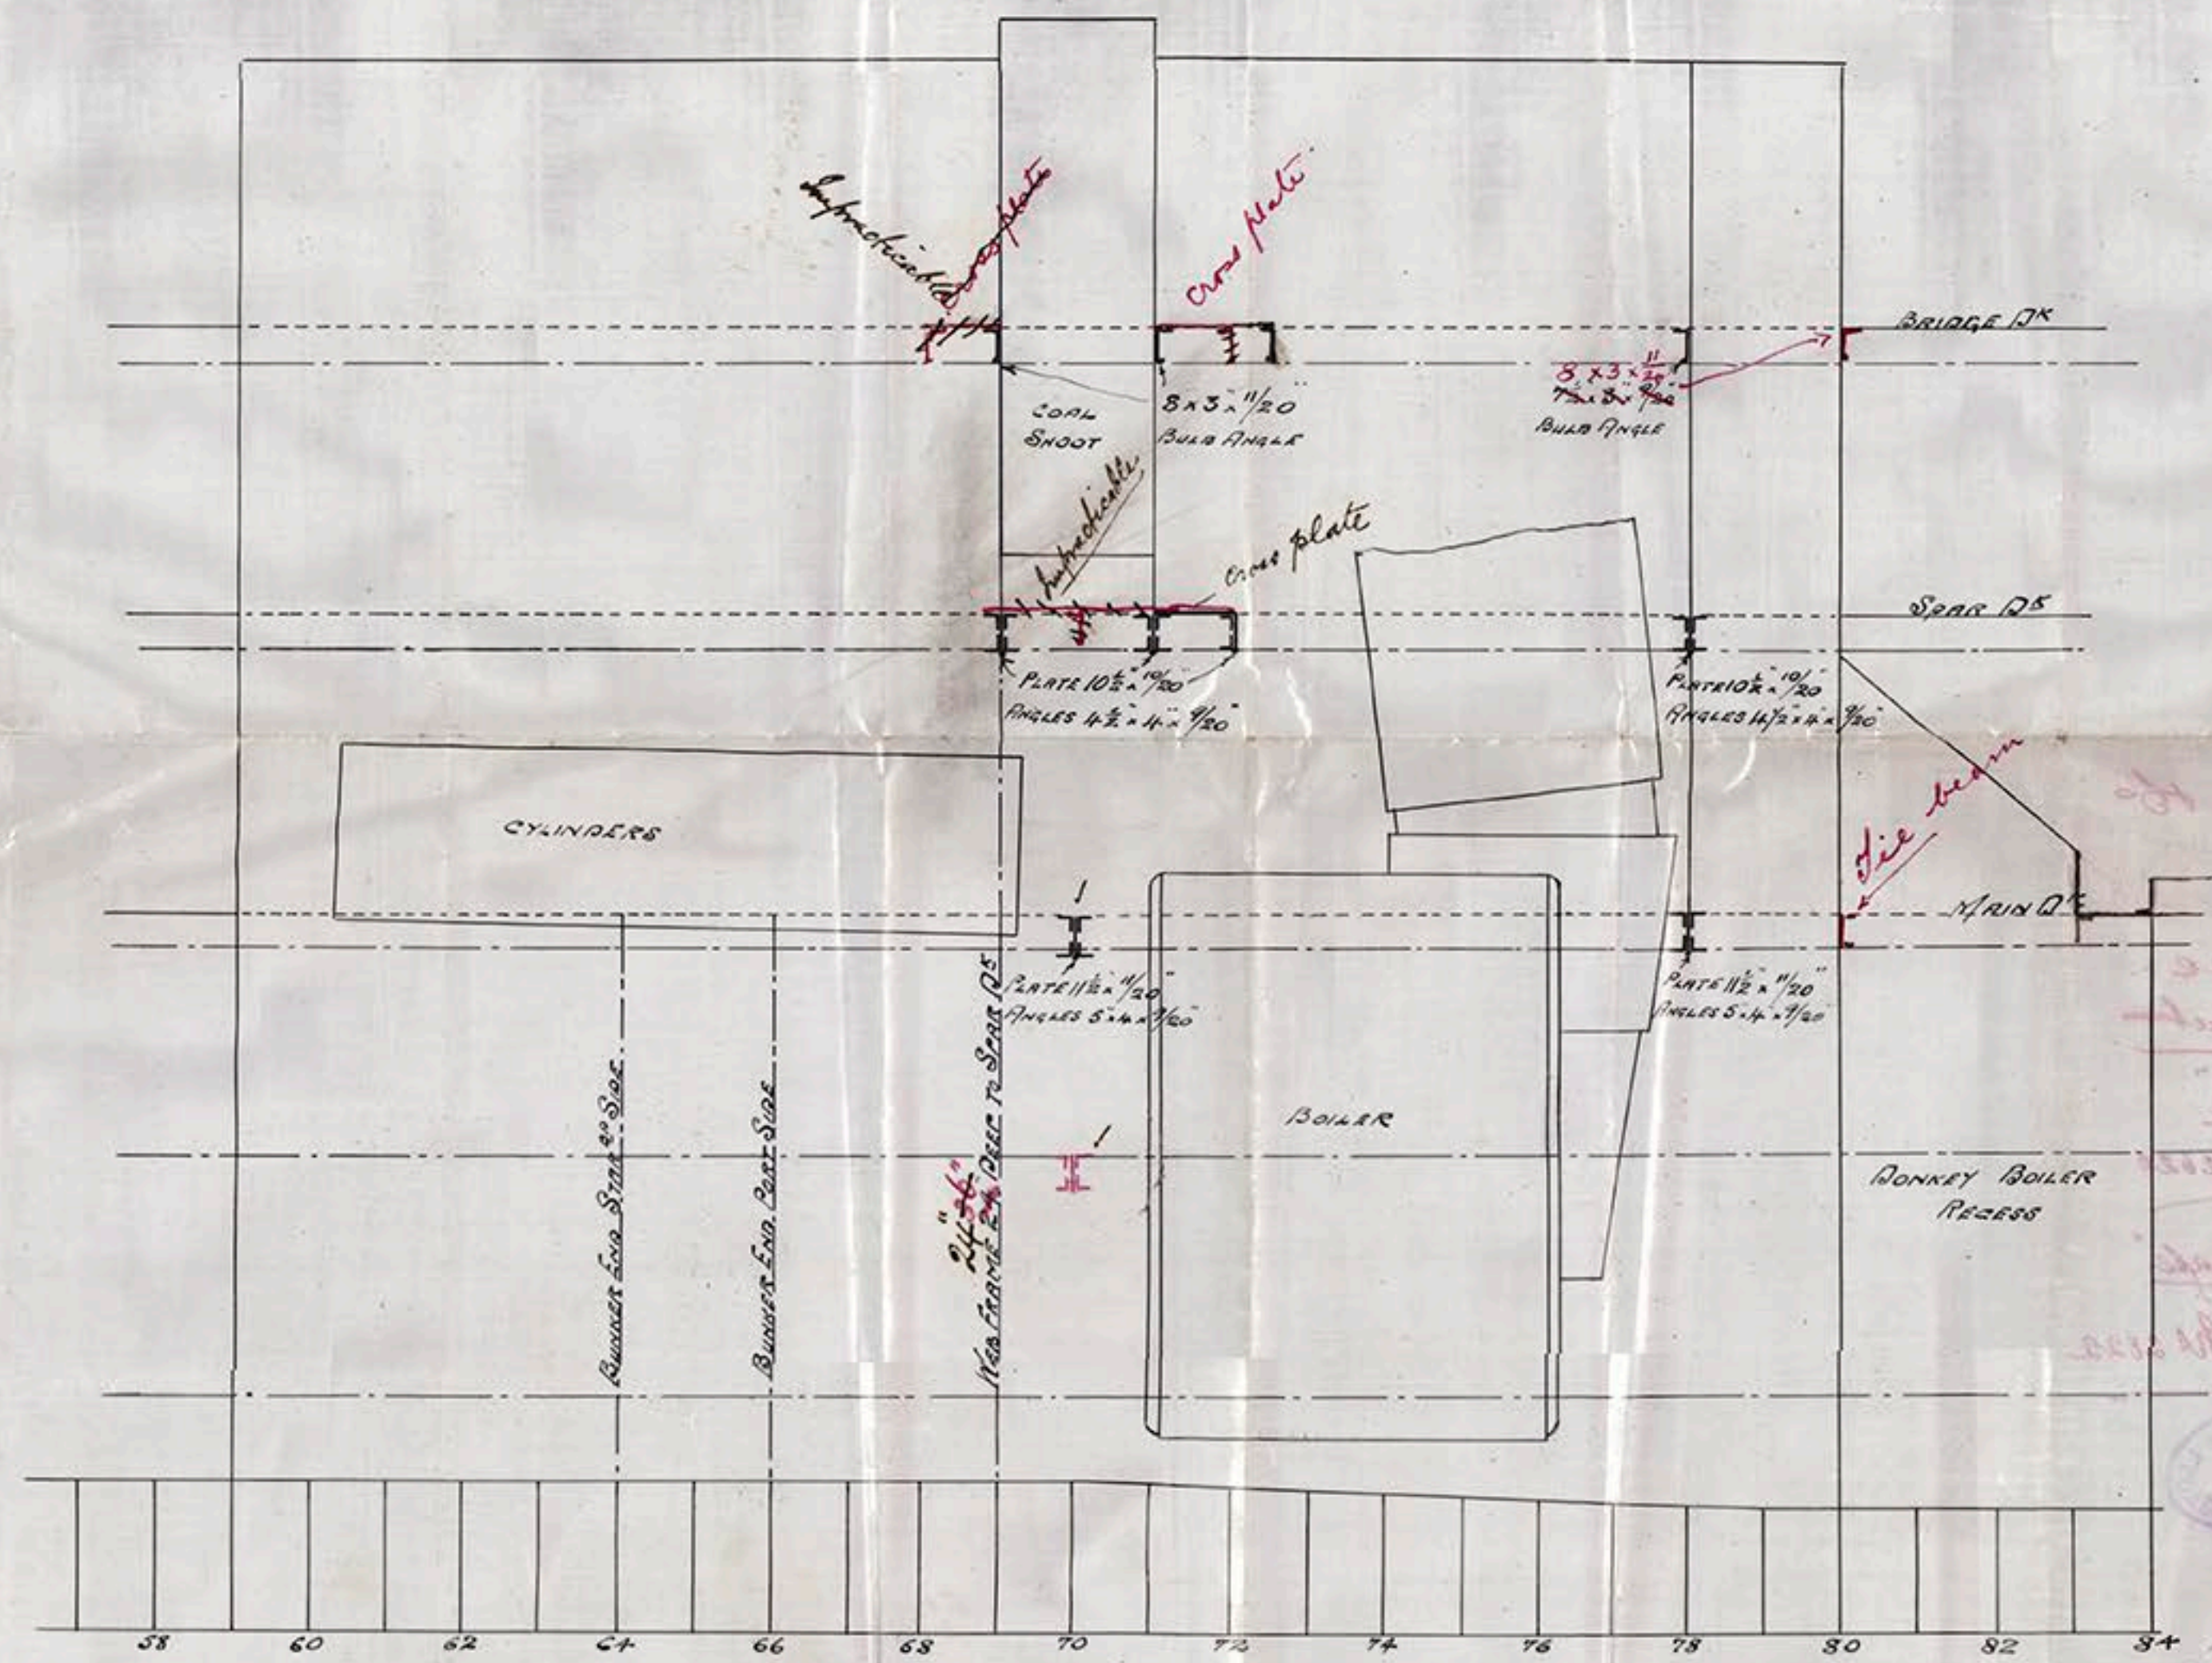

*Handwritten signature and date:*  
 J.H.L. 4/7/98



Sir R. Dixon & Co  
No 460



E. & B space.  
arrangement

"Mont Blanc"

Mdb Report No 2620

No 470. "Whangape"

Mdb Report No 2822

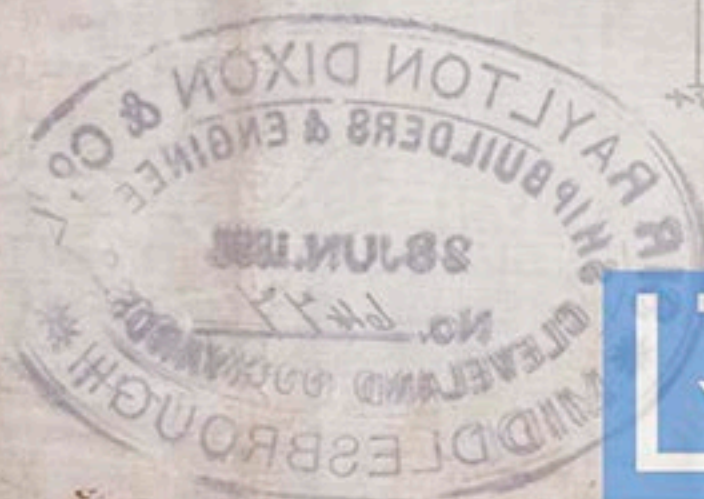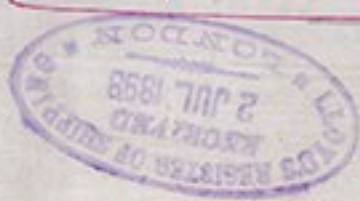

© 2018

Lloyd's Register  
Foundation