

№ 6536


SKETCH of TANK TOP UNDER BOILERS.

S.S. № 460.

Scale $\frac{1}{4}" = 1 \text{ foot.}$

SIR RAYLTON DIXON & COMPANY, L^{DS},
SHIPBUILDERS & ENGINEERS,
CLEVELAND DOCK YARDS,
MIDDLESBROUGH-ON-TEES.

Sept 1st / 98.

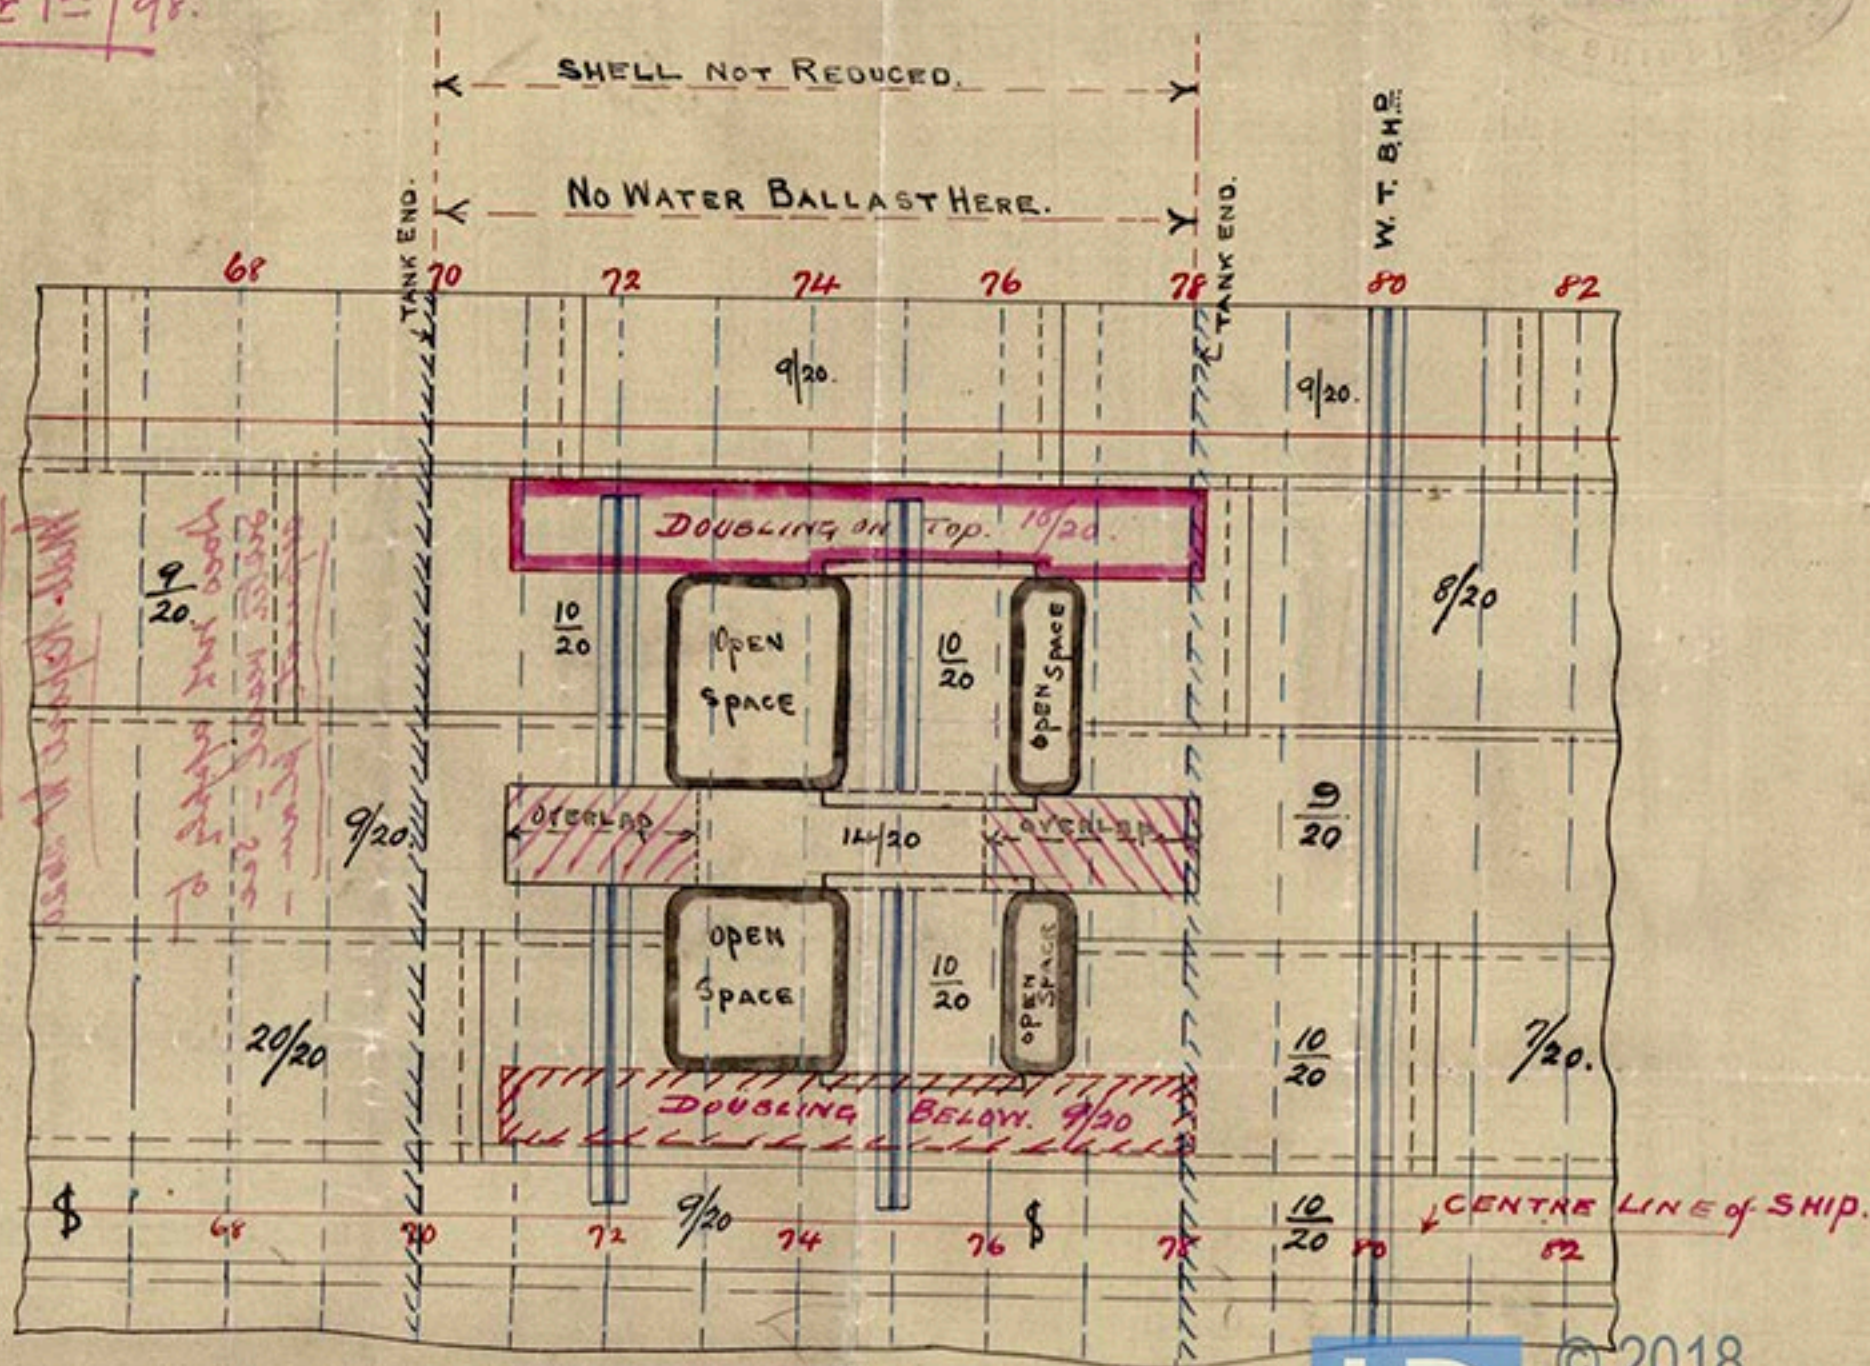

© 2018

Lloyd's Register
Foundation

No. 460

Mont Blanc

Multi-Report No. 2620

Does not apply to
Sicily, Wales - see
separate plan -

20/05/2020

MIDDLESBROUGH-ON-TEES.
CLEVELAND DOCK YARDS,
SHIPBUILDERS & ENGINEERS,
SIR RAYLTON DIXON & COMPANY, L^{DS}.



SKETCH of TANK TOP INOER BOILERS.

004.917.2.2

Leaf 1 = "H" leaf

Ind

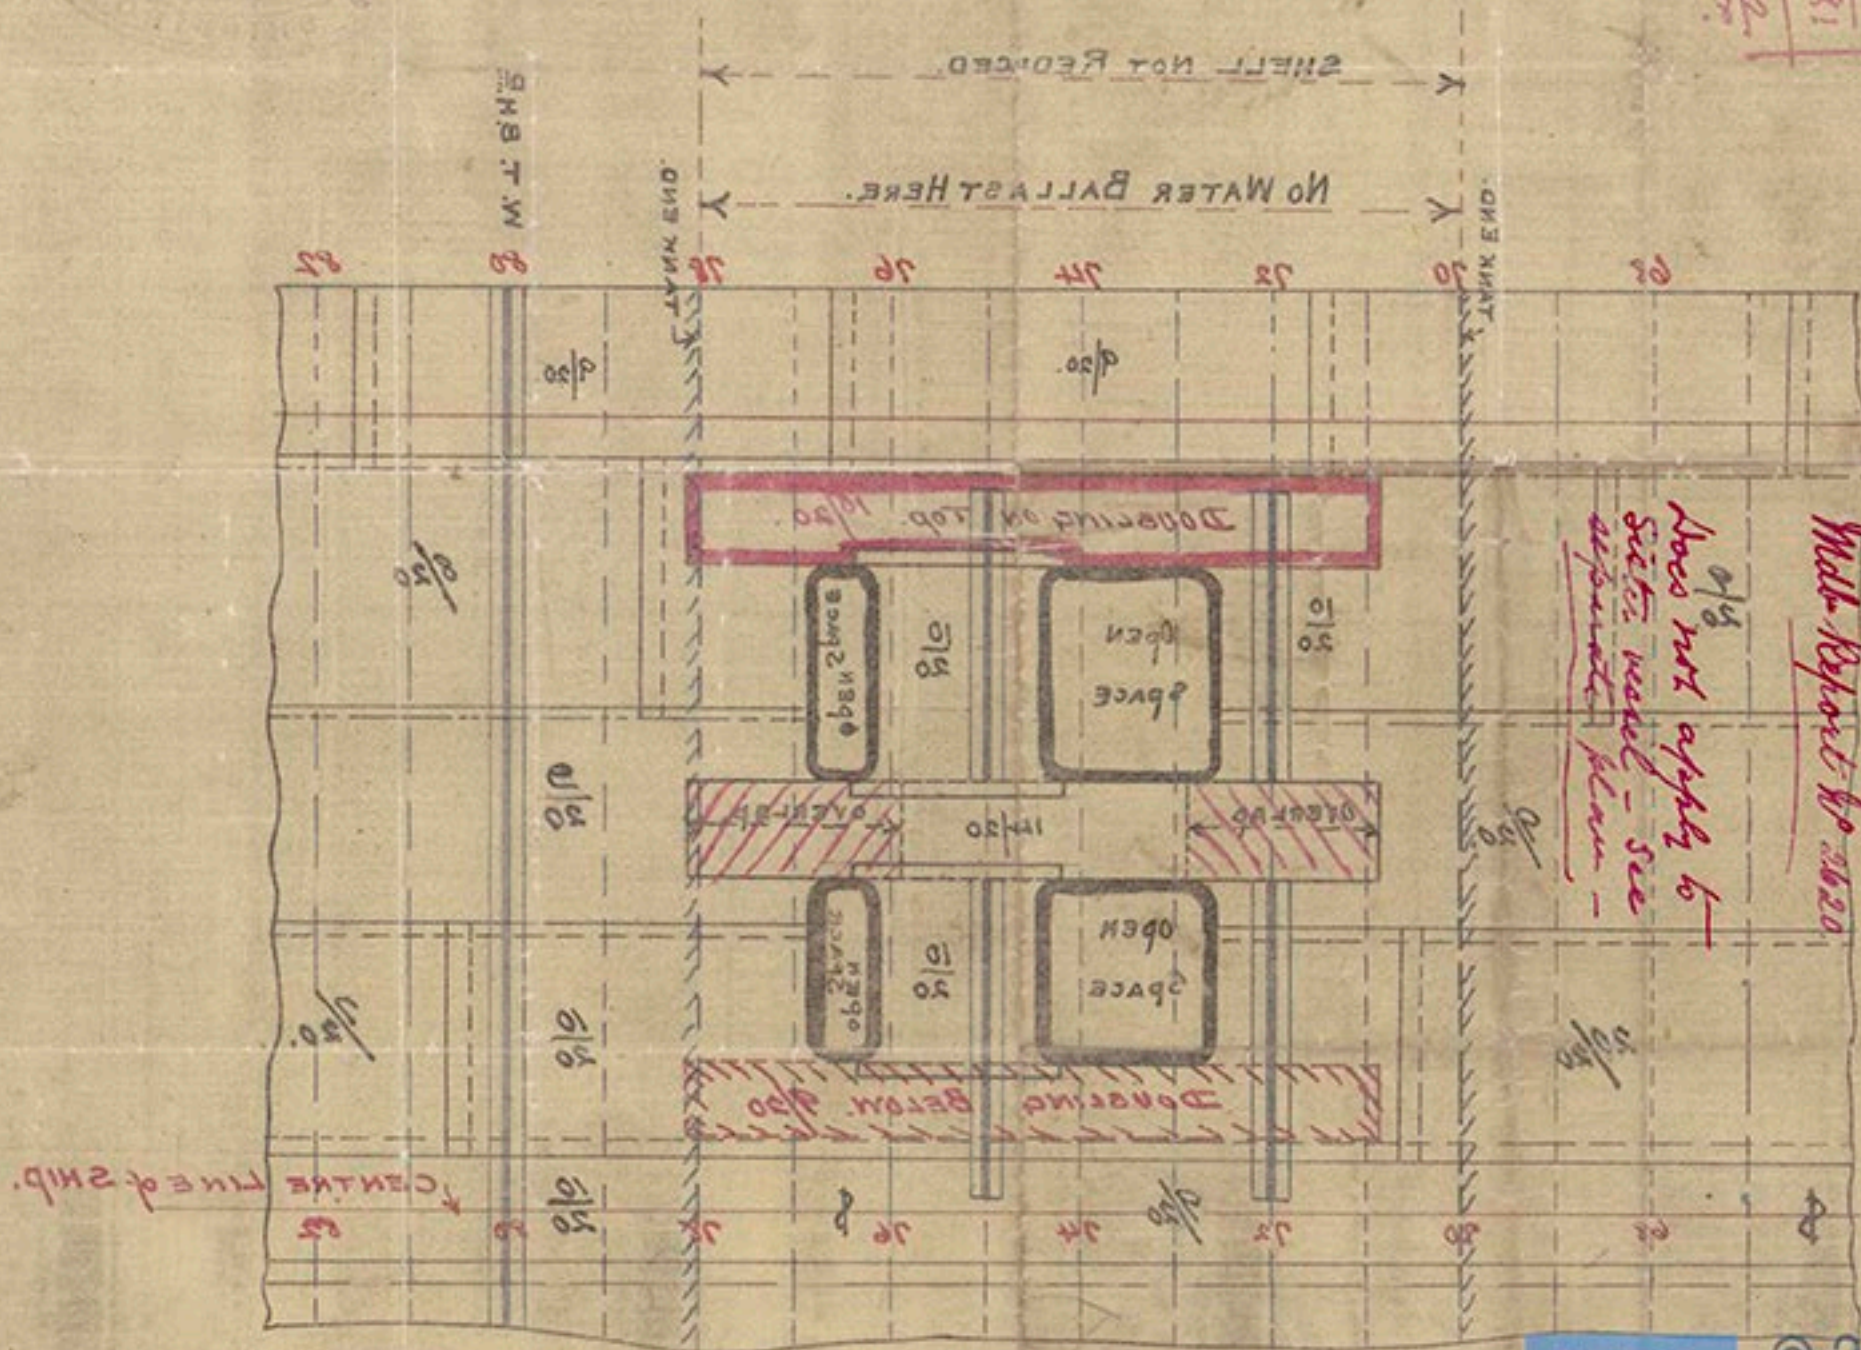

Lk-FAP-TB2, P-15



© 2018

Lloyd's Register
Foundation

LR-FAX-T321-P-15