

## MIDSHIP SECTION

S. B. N<sup>o</sup> 1004

SCALE  $\frac{1}{2}$  = ONE FOOT

TO CLASS 100 A


No. 106a-107

Apr. 20. 12. 93

No: 114

Apr 7. 12. 11. 94


SECTION IN WAY OF QUARTER DECK

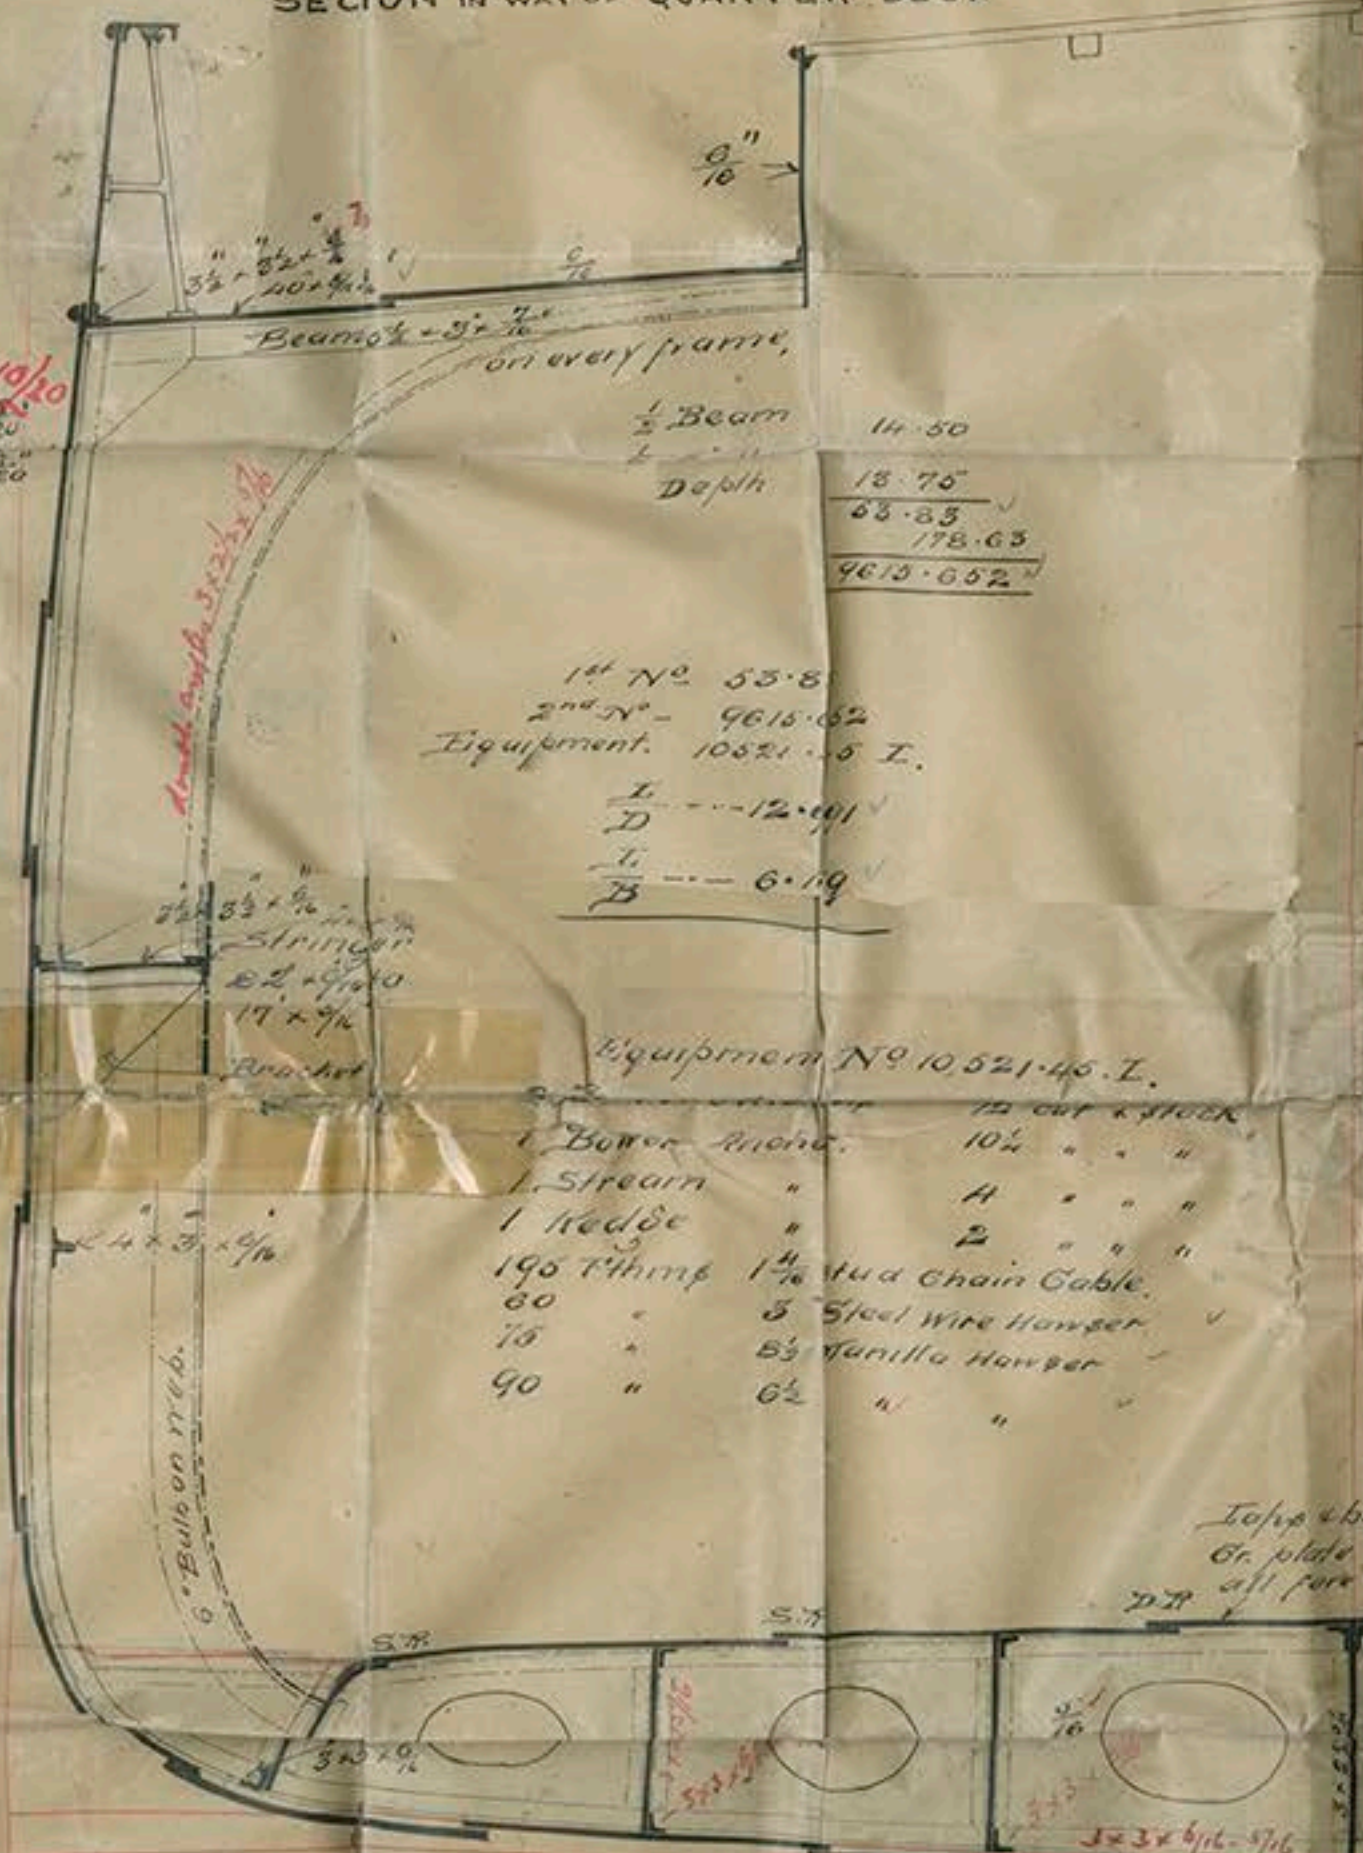

Raised Q. Deck 4ft high  
Top gallant Forecastle 6ft high

Frame work. Iron  
Shell Plating-Steel.

SECTION IN WAY OF MAIN DECK

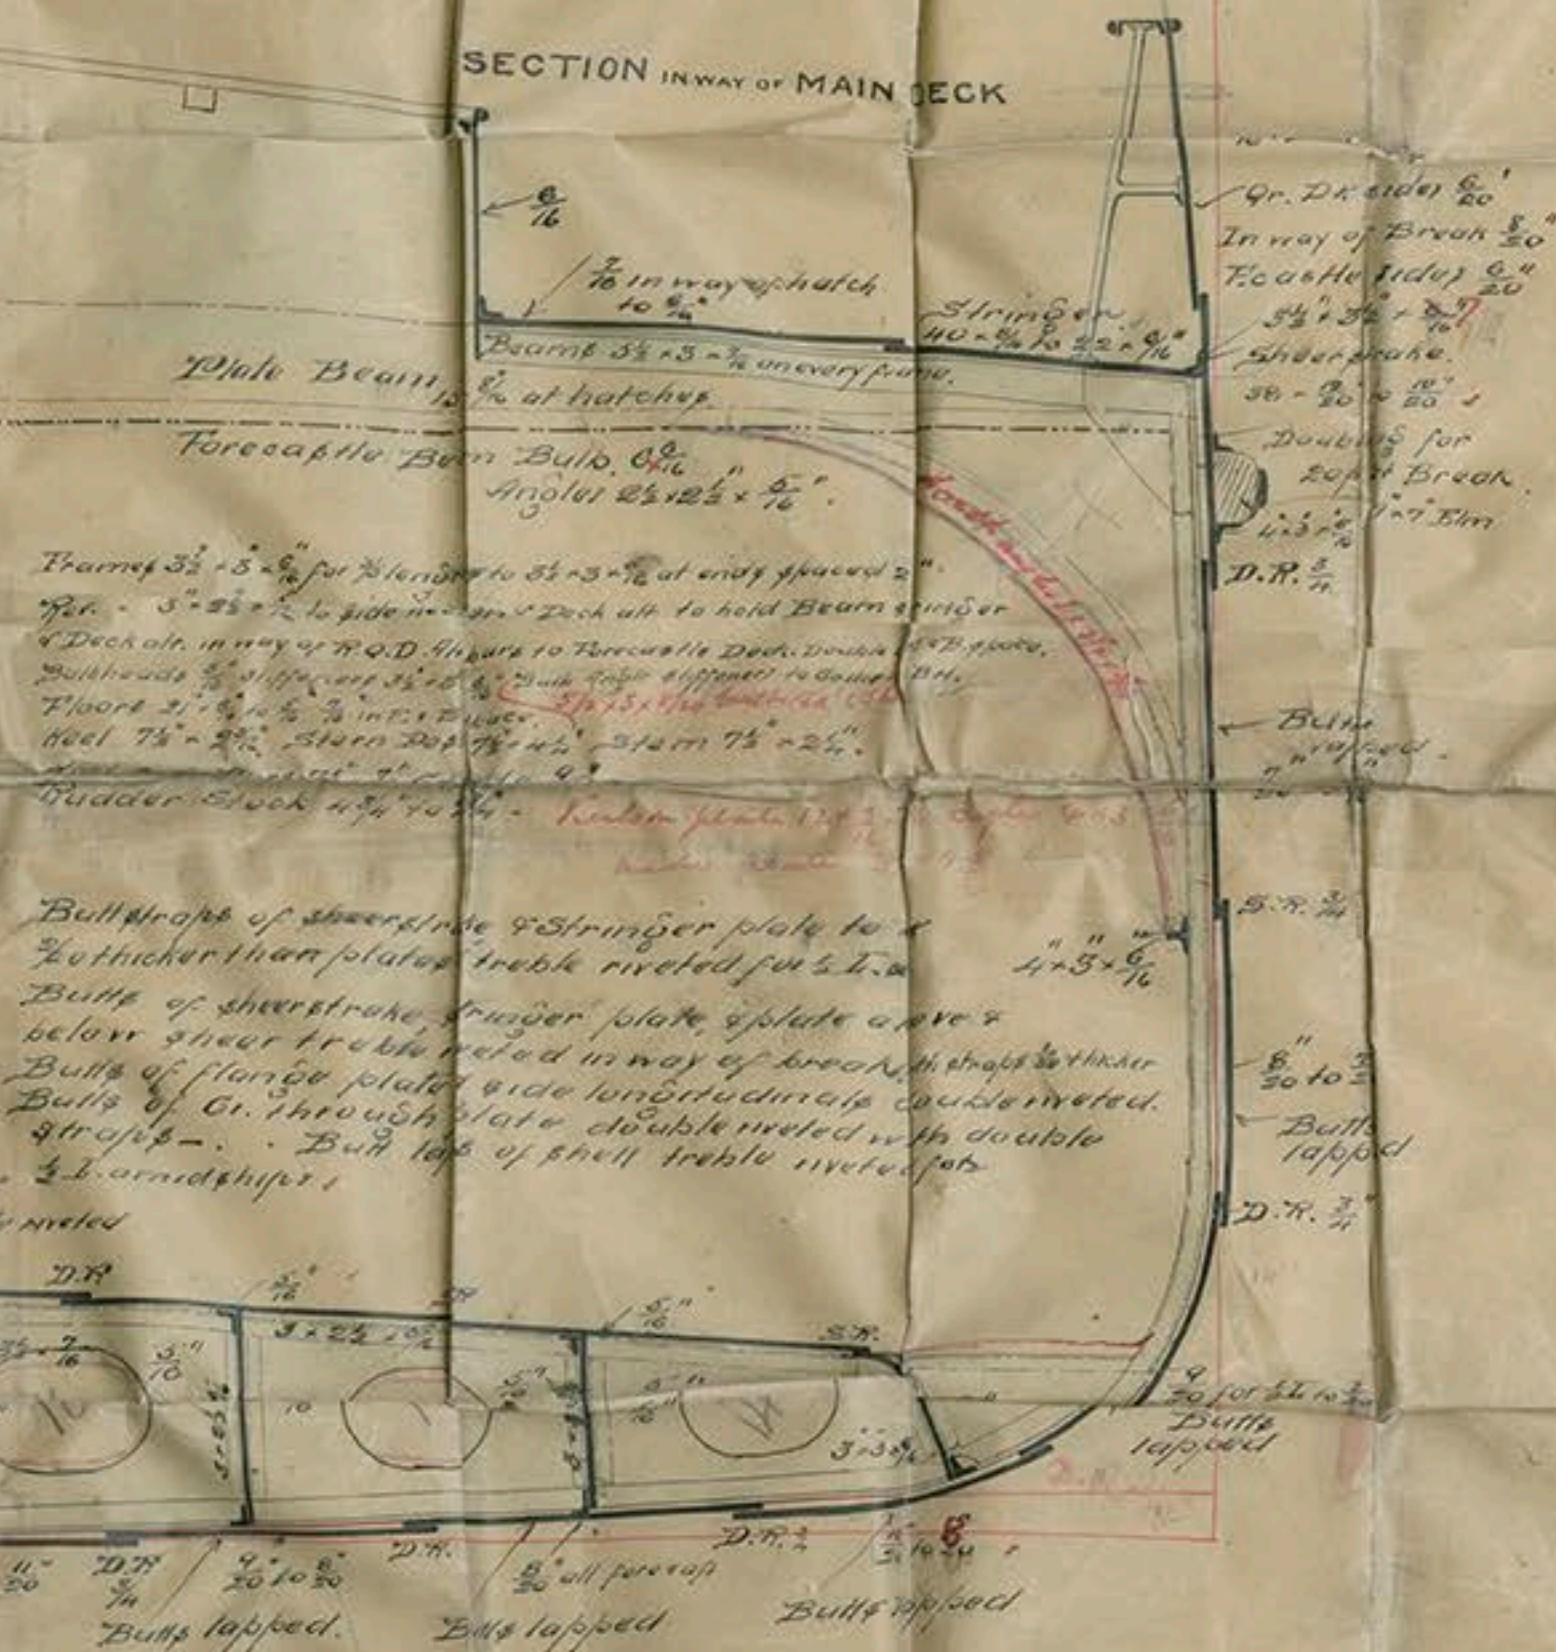

## SECTION ON ALTERNATE FRAMES





