


Nº 145 S.S.  
BULKHEAD FRAME 106

LOOKING FORWARD  
5½ x 3 x 8 B.A. STIFF RS

EXCEPT WHERE OTHERWISE MARKED

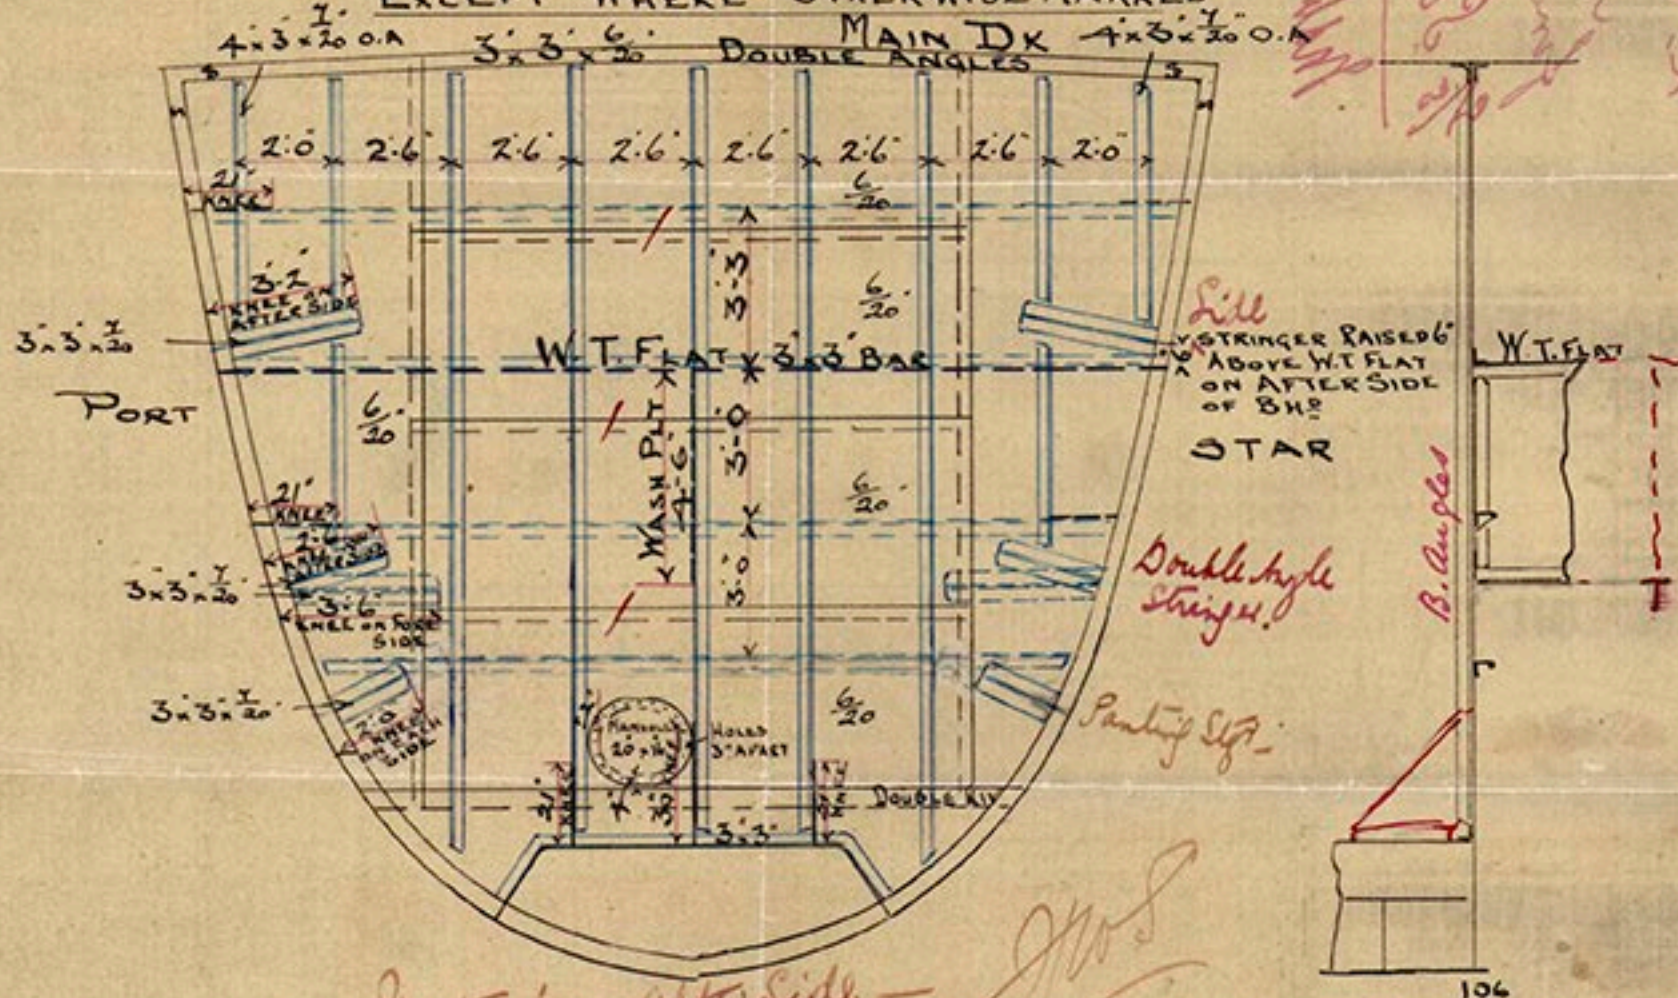

— Verticals on After Side —

