


5.3.04

- PROFILE AND DECK PLAN -

- S.S. N° 379 -

- SCALE $\frac{1}{8}$ INCH = 1 FOOT -

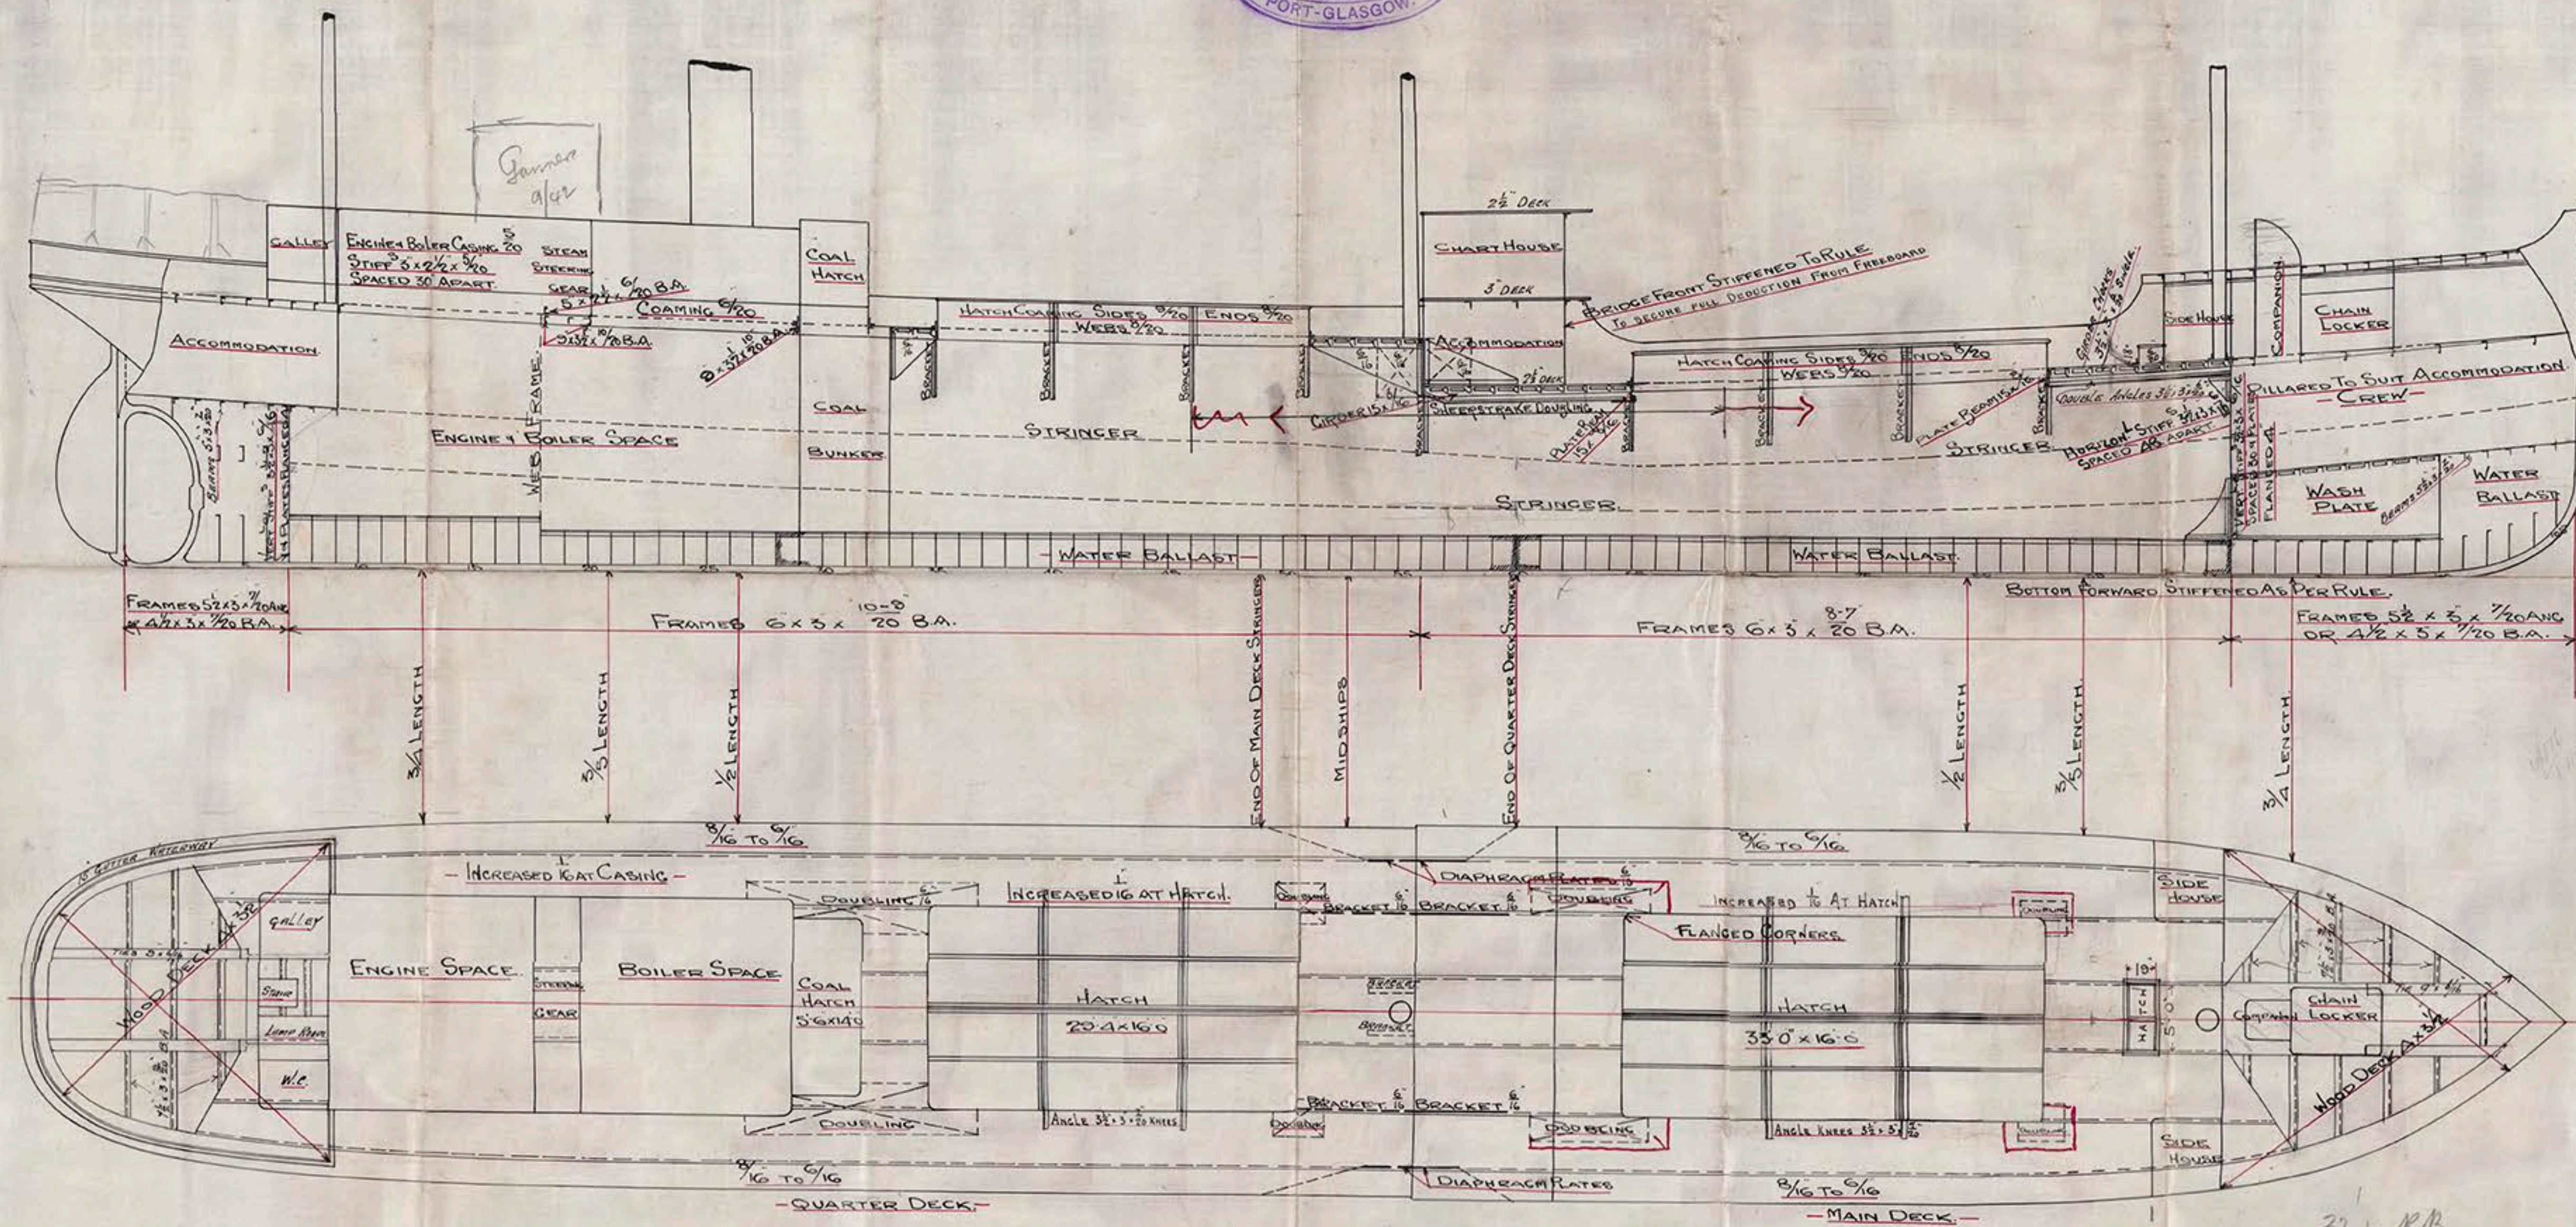

A. Rodger v/o No 379.

Greenock 1st Entree
Report No. 14028.
J. H. Emerald

—PROFILE AND DECK PLAN—



