

9676.



Lon 110594

5/5 "EMERALD"

NEW FORECASTLE FRONT.

Scale 1/4"=1'-0"


NEW WORK TO SUIT EXISTING STRUCTURE.

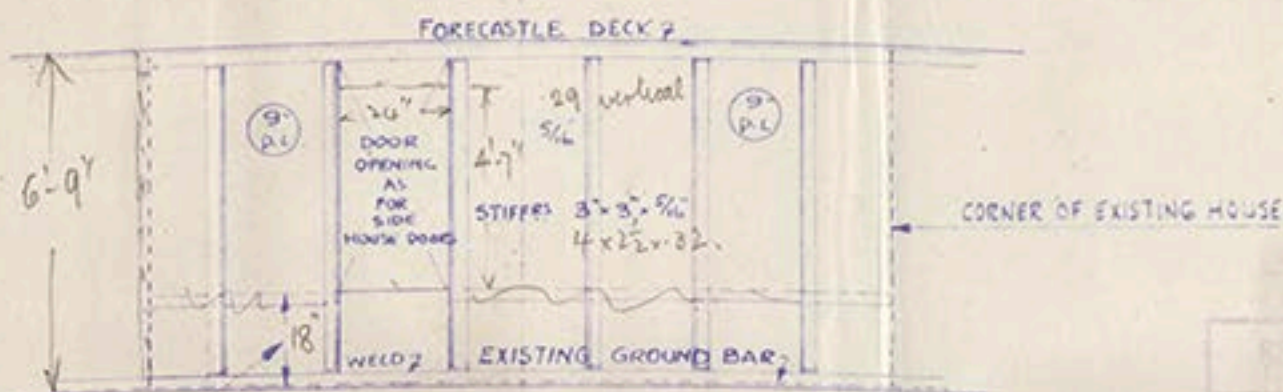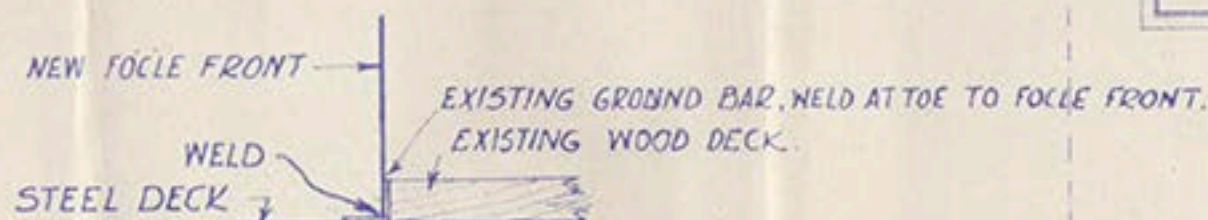

COAMING HEIGHT TO SUIT EXISTING SIDE HOUSE COAMINGS.

NEW FORECBLE FRONT BHD. (looking Aft.)

DATE TO	DATE
Mr. VAREND	11/9/42
2 - Bell	
LEVERICK	
Hoy's Reg	11/9/42
DO FILE	11/4/42

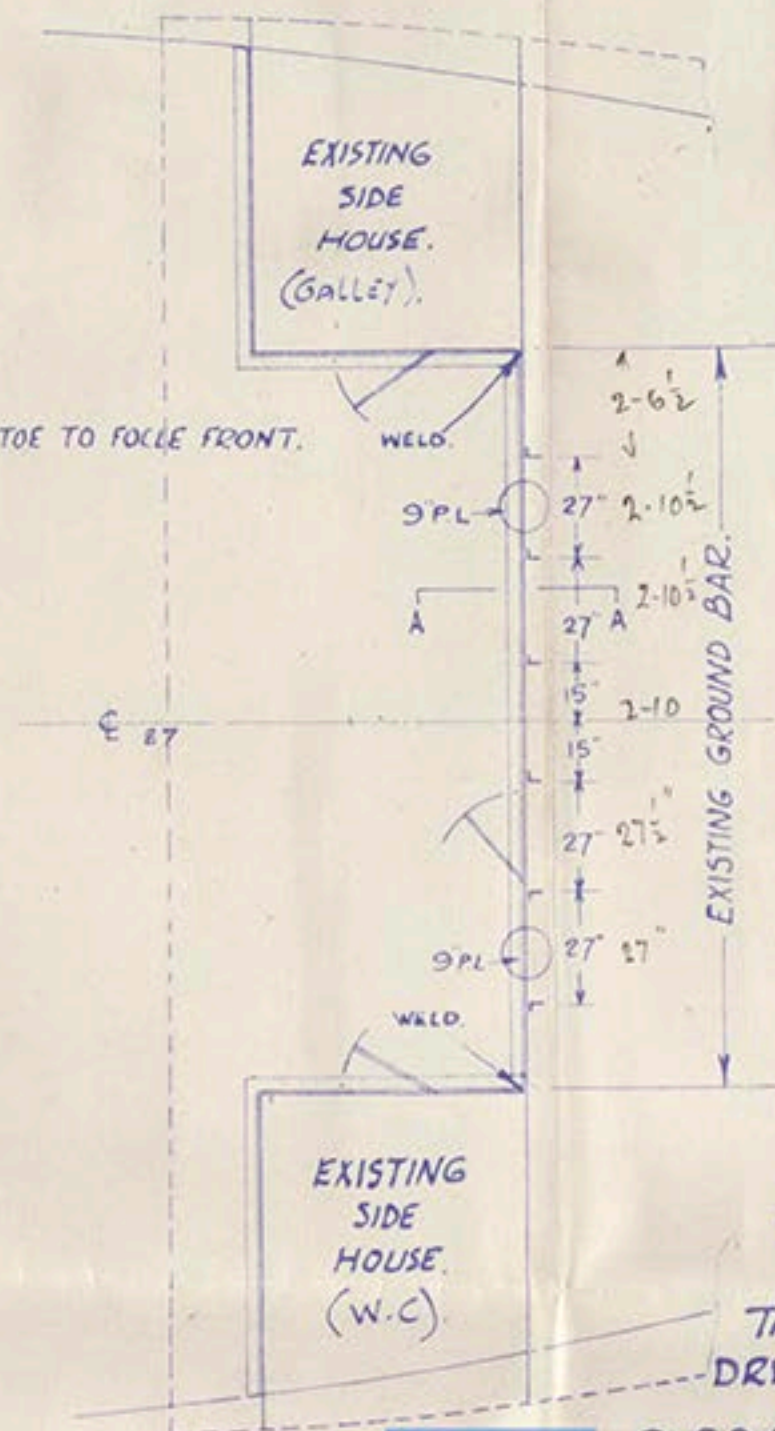

9676.

THIS CANCELS DRWG No. 9655.

© 2018 11/4/42



Lloyd's Register Foundation