

9691

2/5 "EMERALD" Lm 110594

STEERING ARRANGEMENT

SCALE 1/4" = 1'-0"


RUDDER HEAD 44

SHEAVES 12" INSIDE DIA - PINS 3/8" DIA.

CHAINS TO SUIT SPROCKET BUT NOT LESS THAN 1 1/2" DIA.


RODS 3/4" DIA. 13/16"

CHAINS OF B.B.B. CHAIN TO LLOYD'S TEST WITH CERTIFICATE.

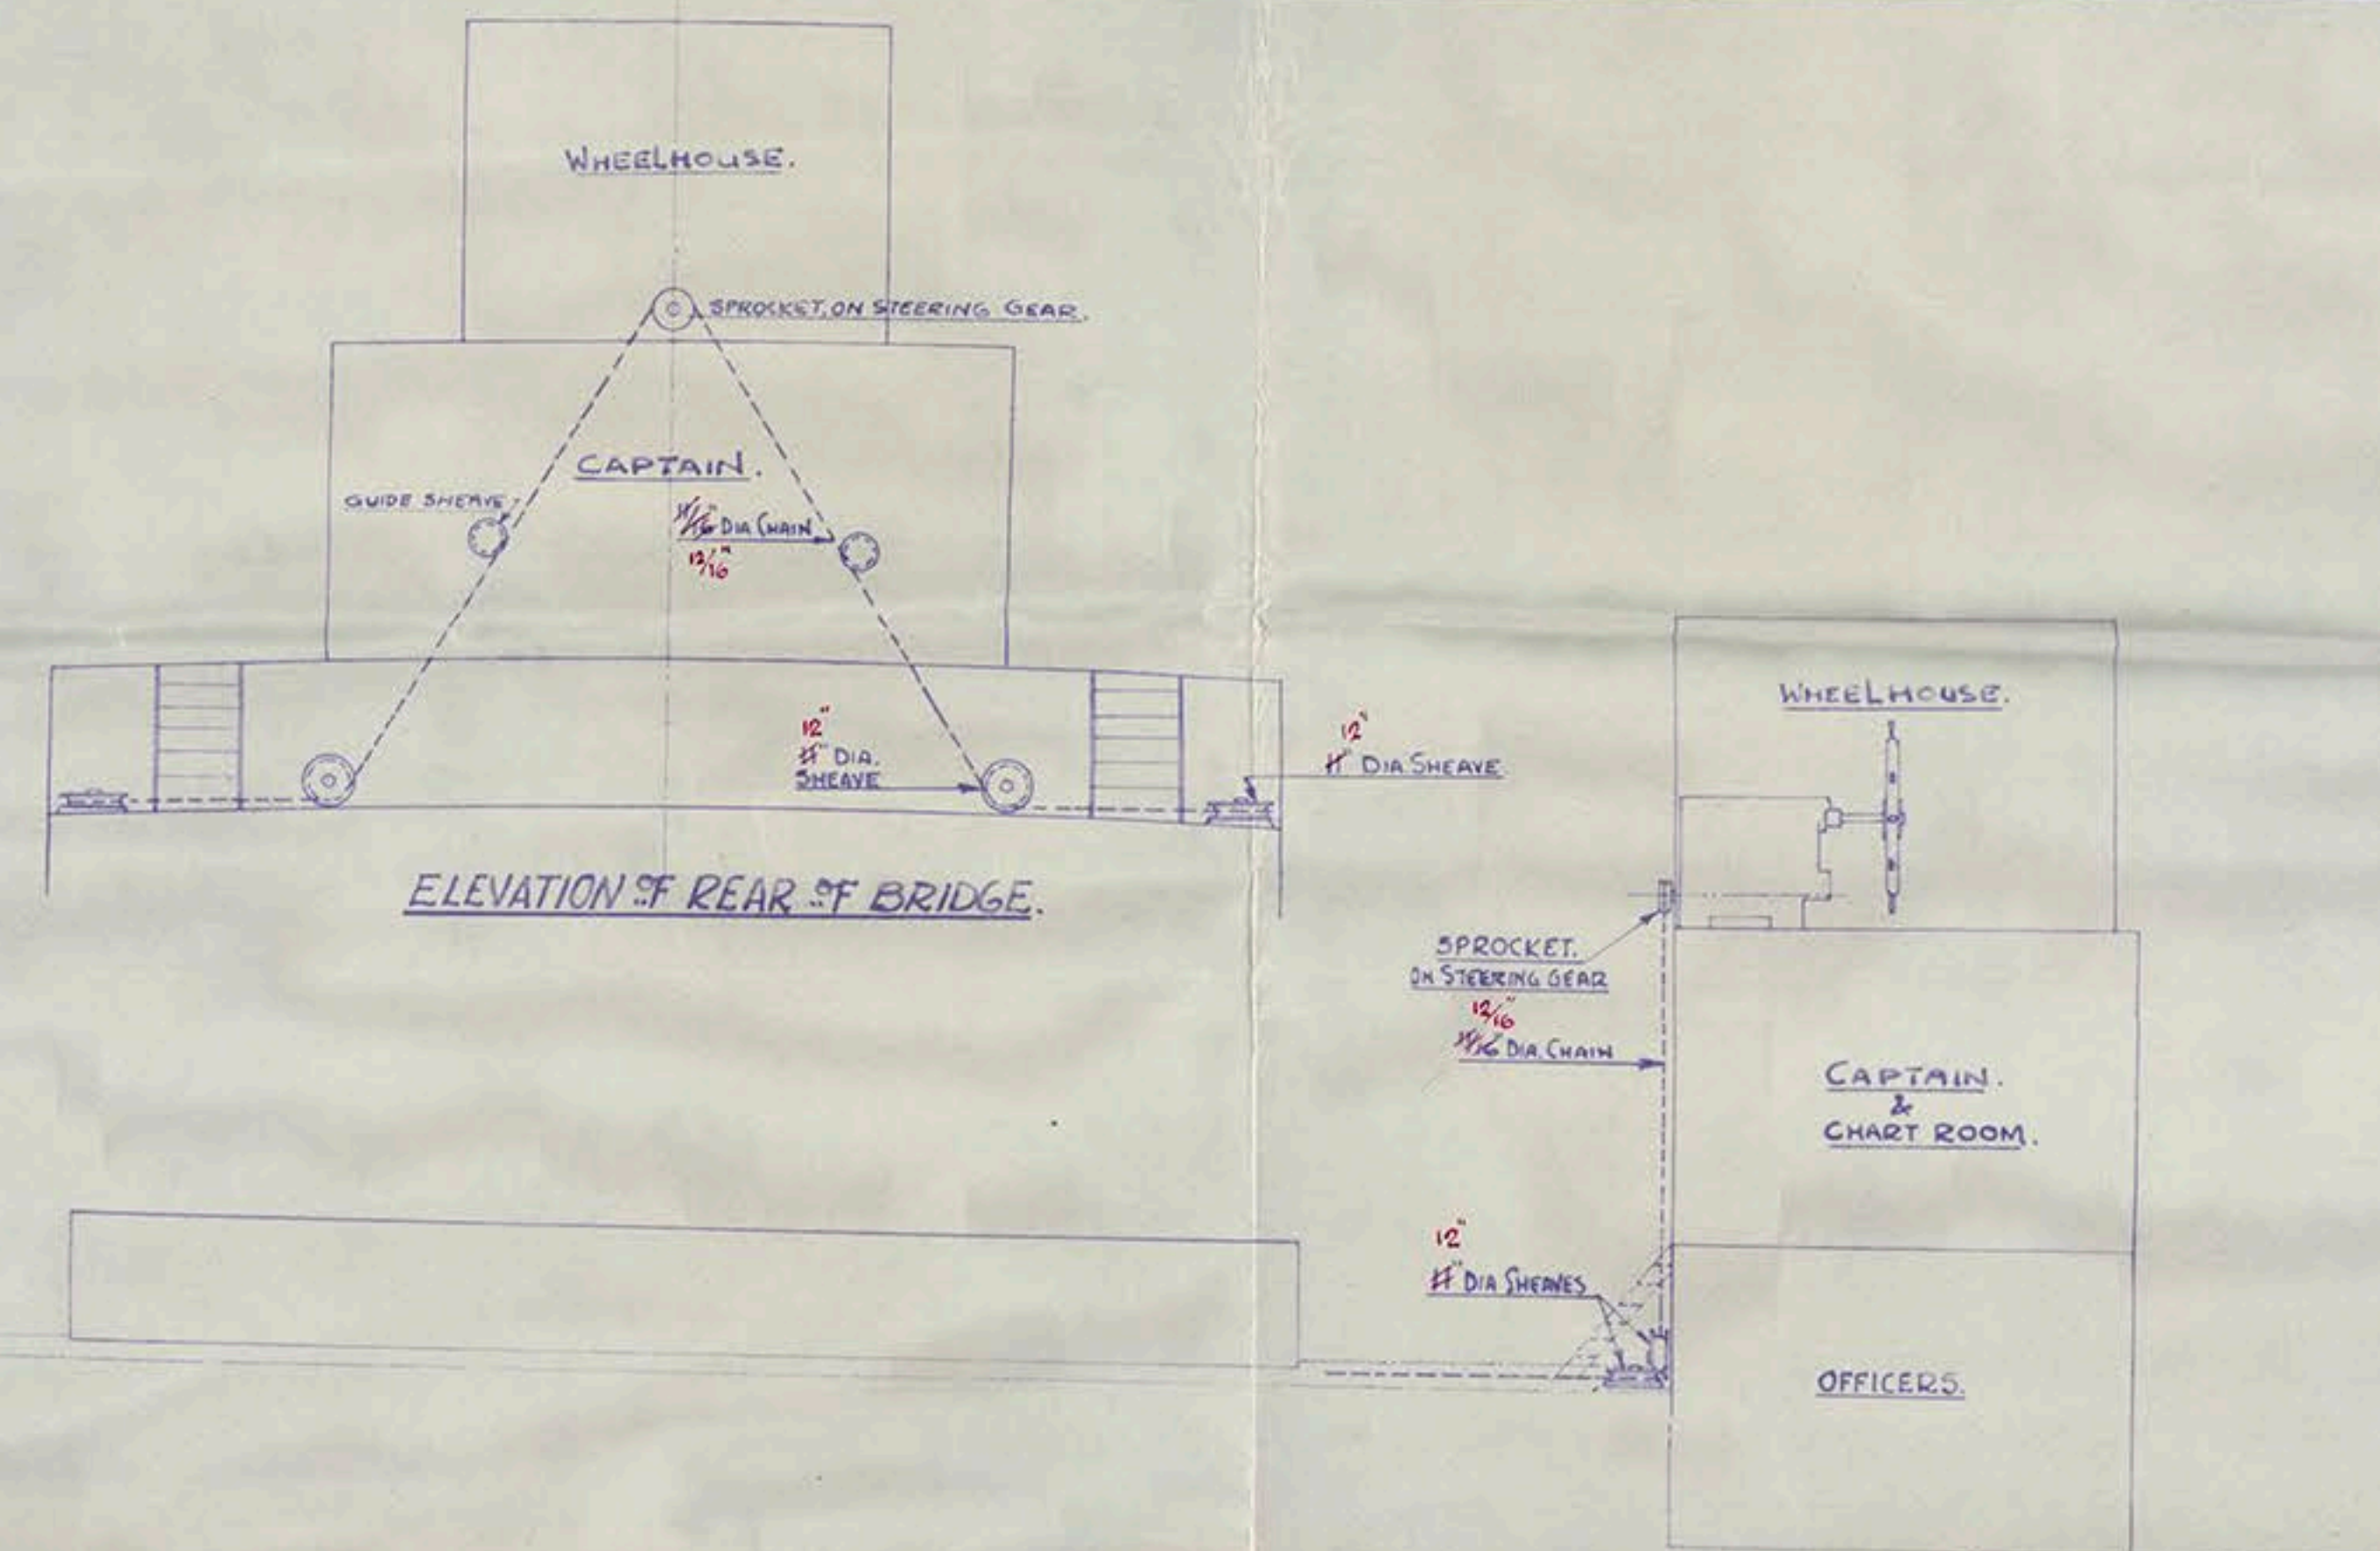

EXISTING FITTINGS AFT
TO BE RE-USED.

EXACT LENGTHS OF CHAINS & RODS TO BE DETERMINED AT SHIP.
GUIDE BLOCKS ARRANGED AS NECESSARY.

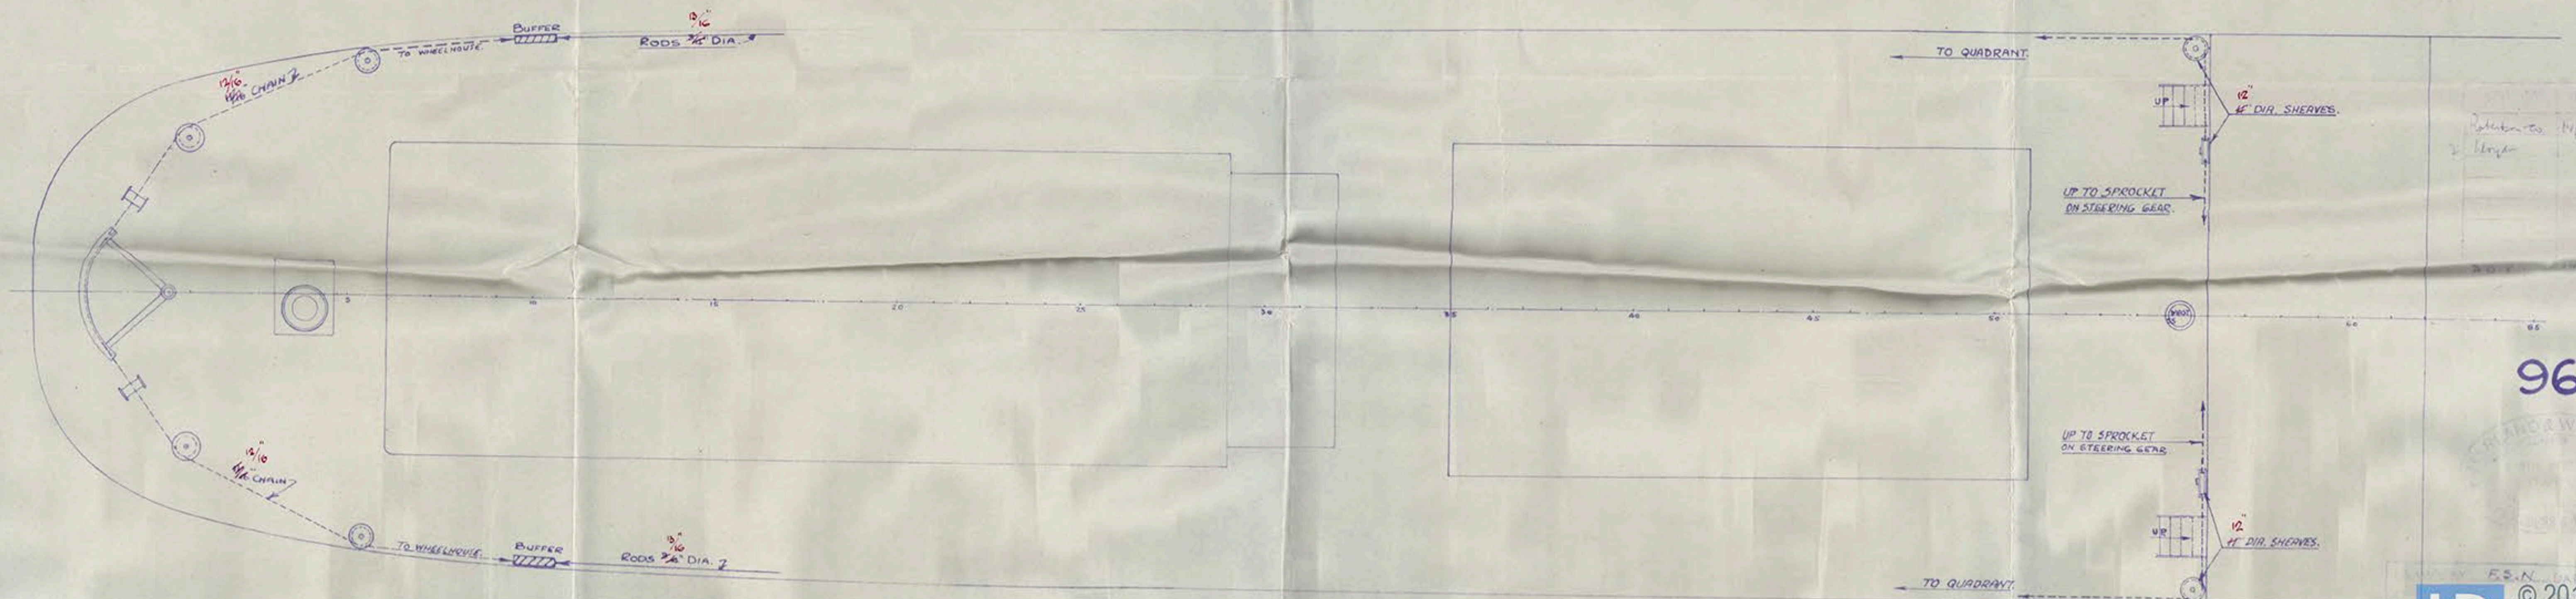

9691