




9696.

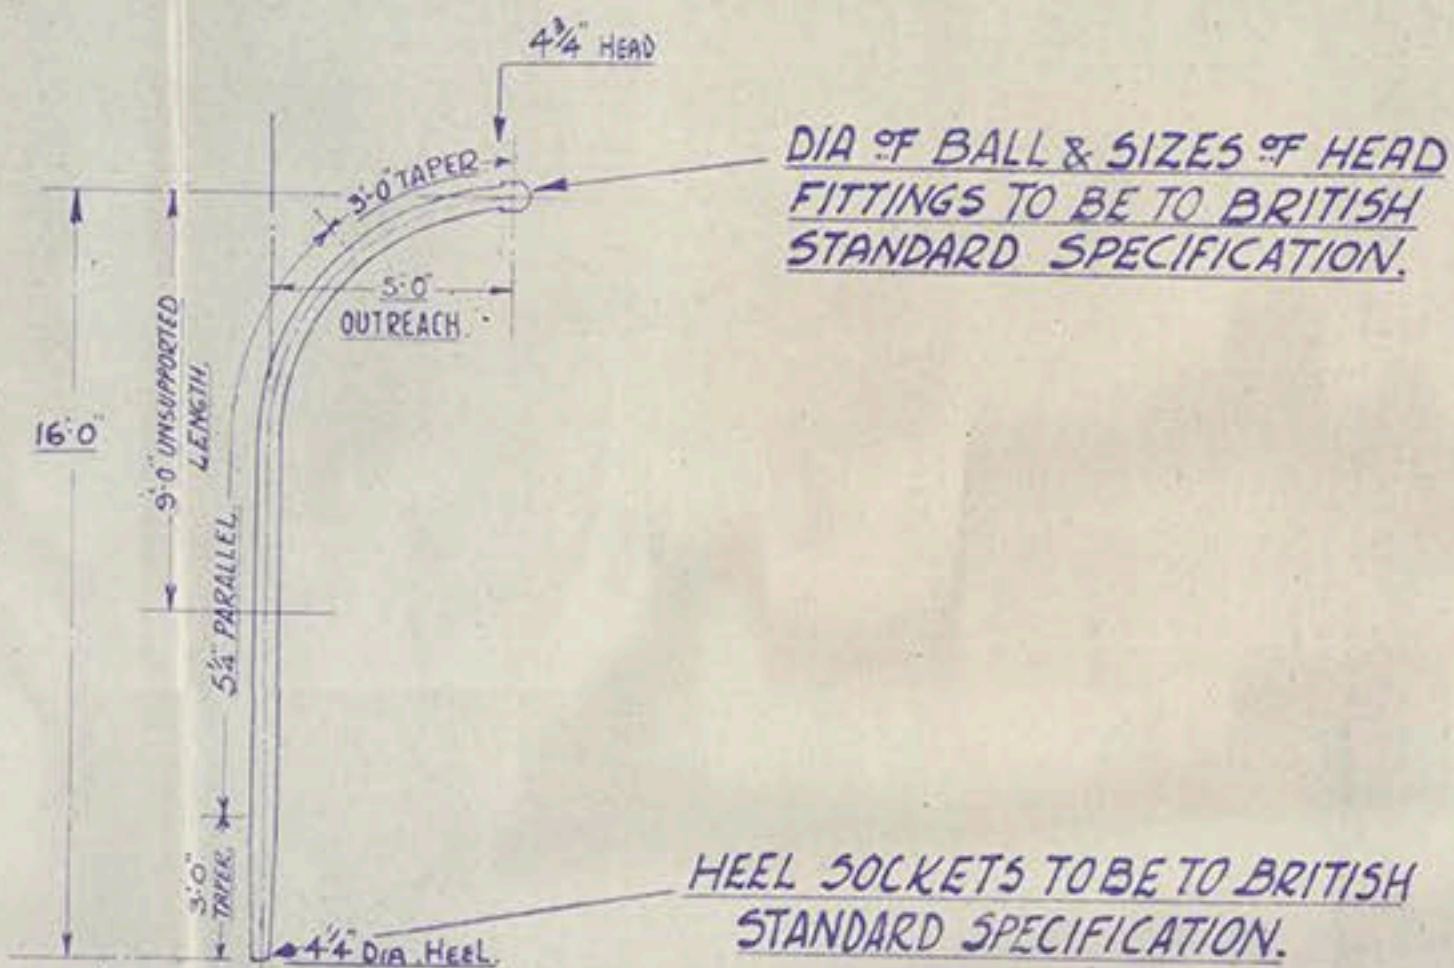

# 1/8" EMERALD LIFEBOAT ARRANGEMENT.

SCALE 1/4"=1'0"

Lon 110594

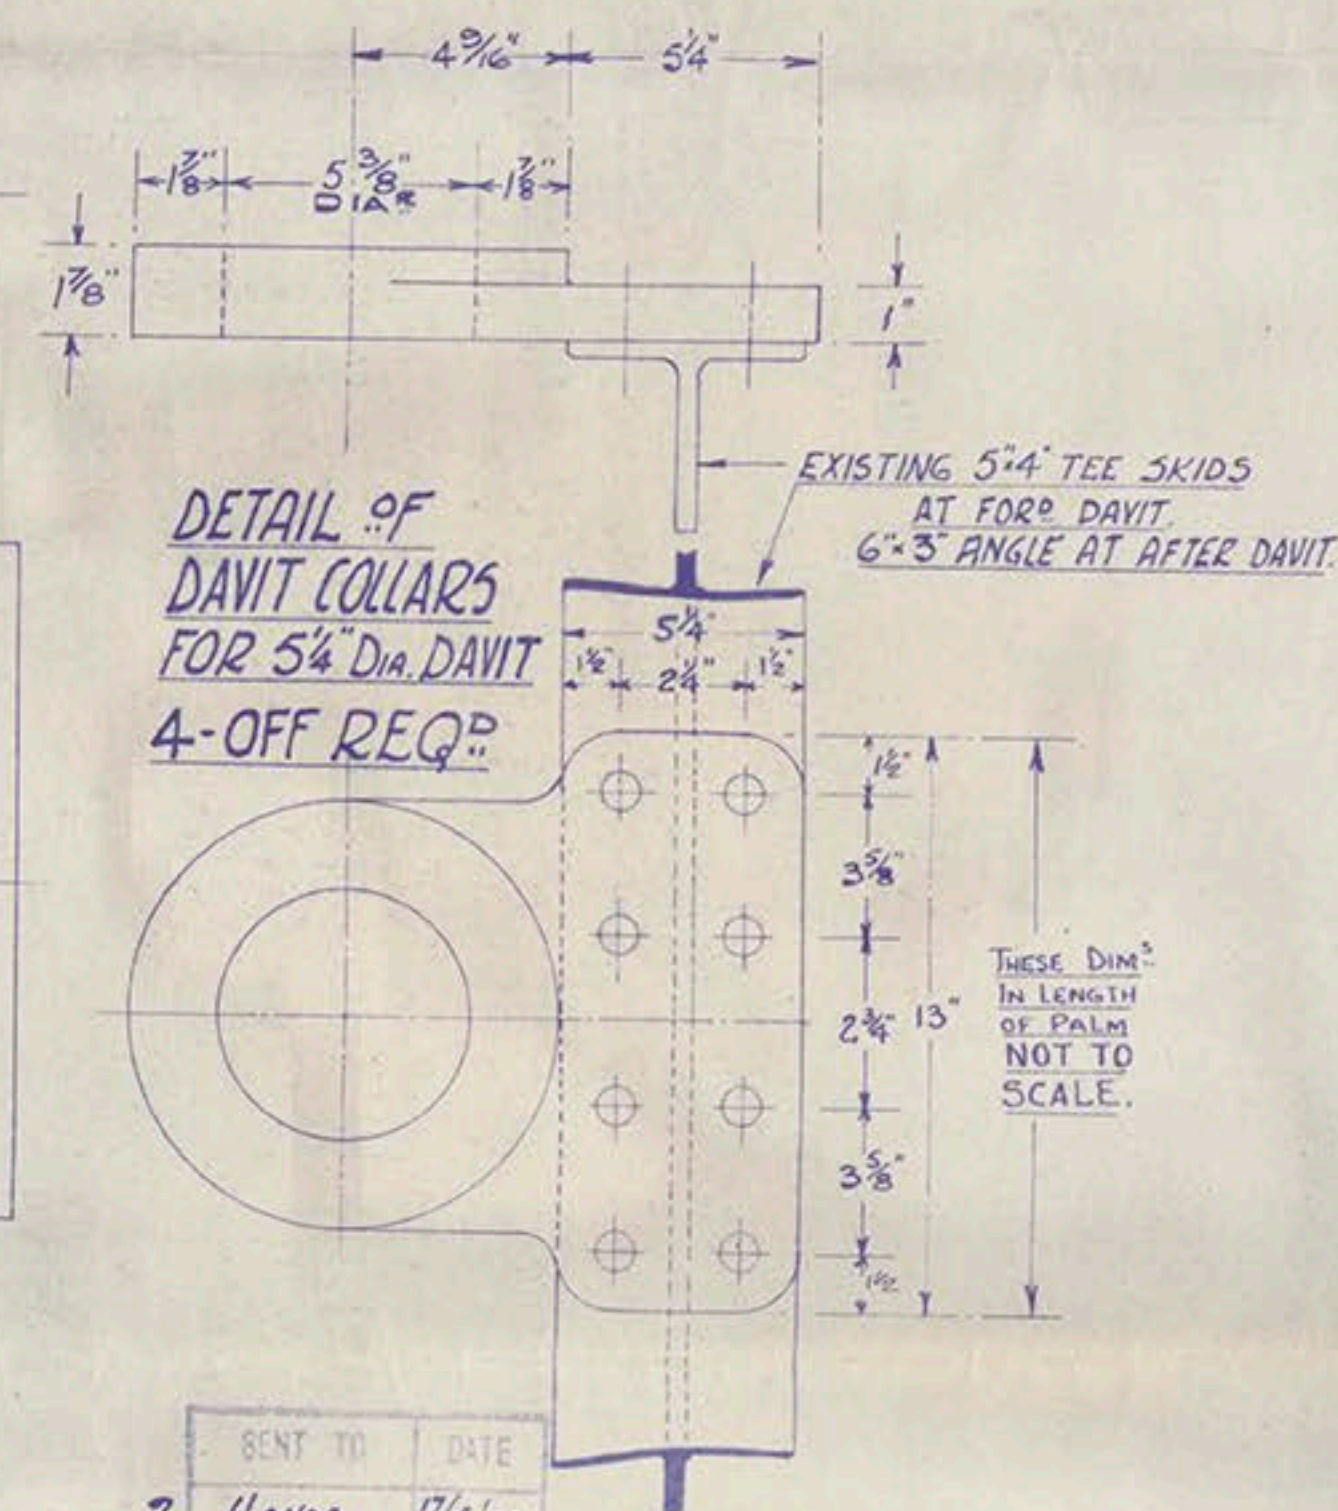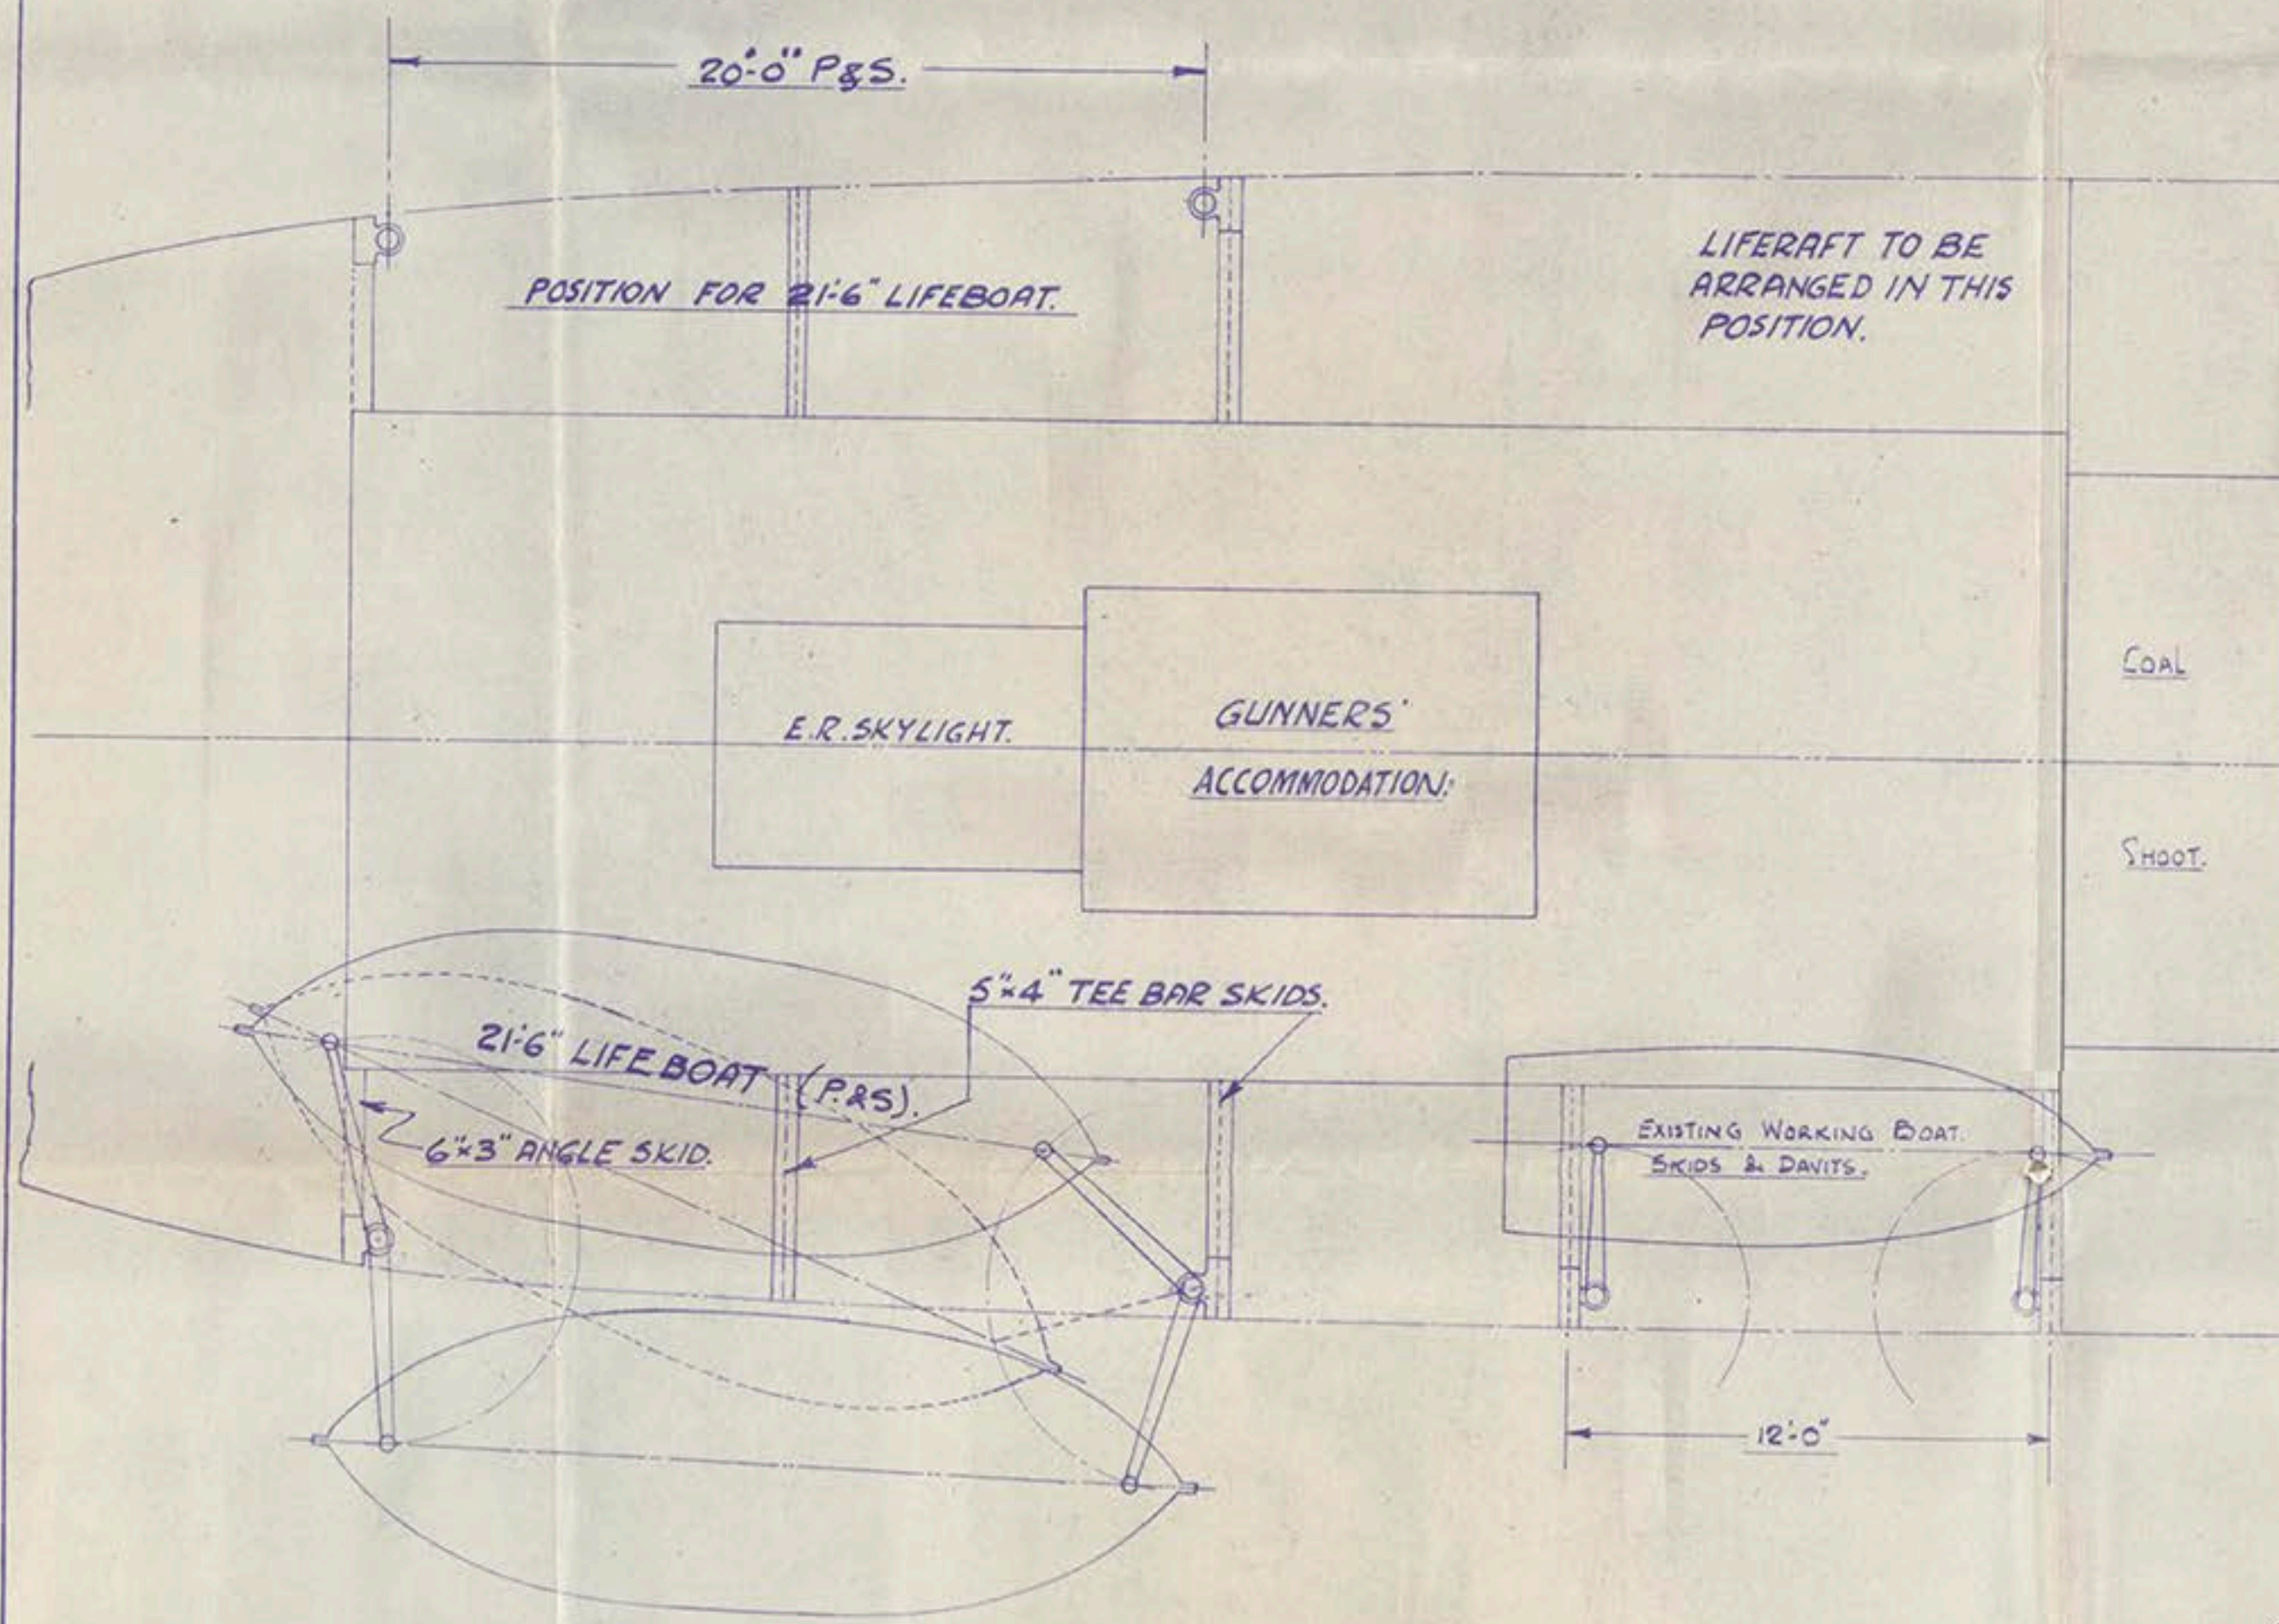

9696.

F.S.N. 17/4/42.

© 2018

Lloyd's Register Foundation



Approved for Scantlings of Davits