

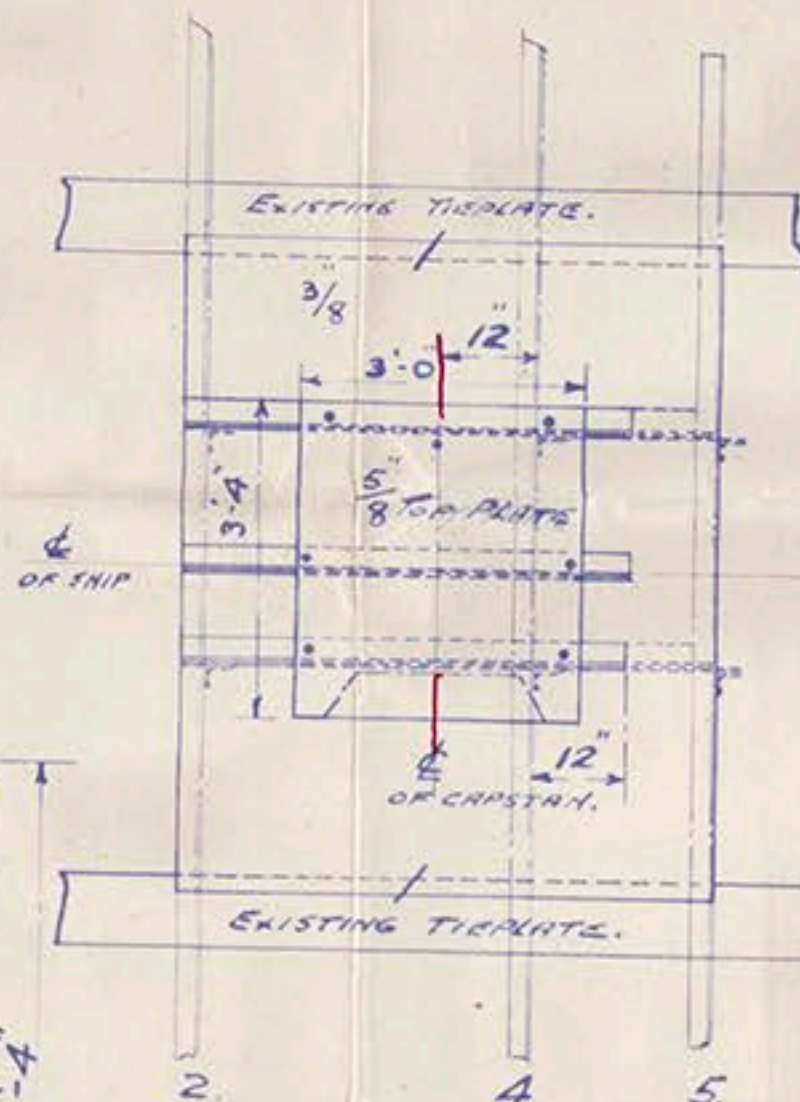


S.S. "EMERALD" / 102.
CAPSTAN ENGINE SEATING.

SCALE $\frac{1}{2}$ " = 1 FOOT.

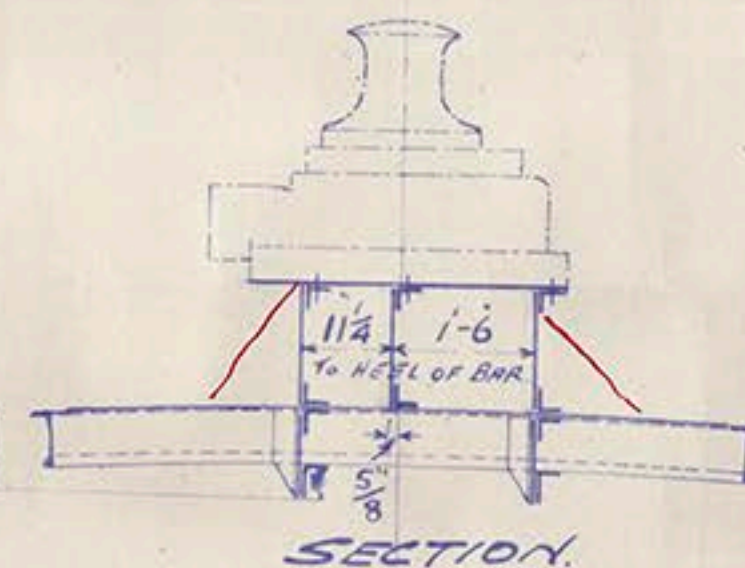


SCALE $\frac{1}{4} = 1 \text{ FOOT.}$

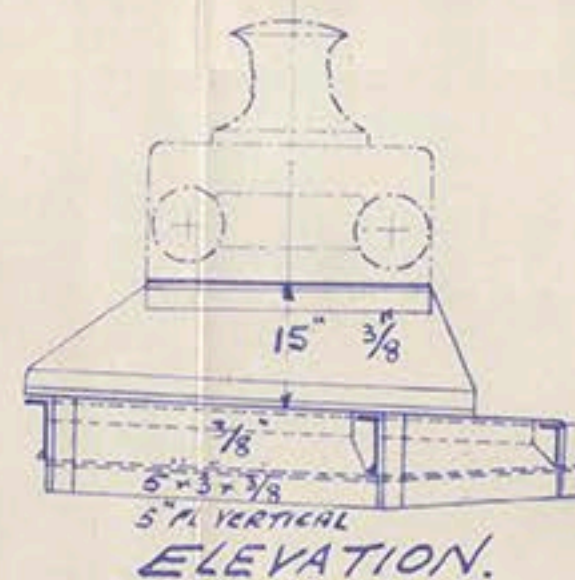

ALL ANGLES & LUGS $3 \times 3 \times \frac{1}{8}$
EXCEPT WHERE OTHERWISE MARKED.

ACTUAL POSITION OF HOLDING DOWN
BOLTS TO BE TAKEN FROM BEDPLATE
BY TEMPLATE.

MATERIAL FROM STOCK.

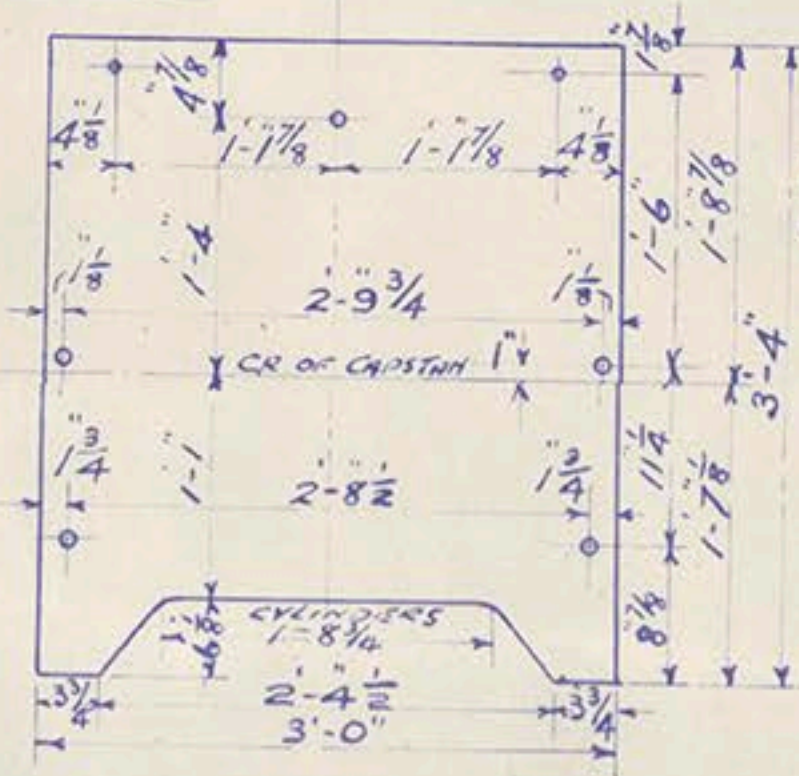

BEDPLATE.
1" = 1 FOOT.

3 Hoyas Rec 27 4 m

D.O. FILE 27442

9717