


11.7.01  
7.8.01  
13.9.01  
18.10.01  
16.1.02  
14.6.02  
4.9.02

S. S. N° 376 OIL STEAMER

510'0" B.P. x 63'3" ml. x 34'6" ml. to UP D'S.

SCALE 1/8" = ONE FOOT.

 

Bottom strengthened at junction of two systems of bottom framing to satisfaction of surveyors

Deck plans to be submitted

properly spaced  
not less than 8" B.P. Bulkheads  
to be complete to upper deck  
with partial bulkheads above  
in shelter beam ducts.

Bottom strengthened forward as per rules  
between 1/2 length to


See amended project

17/07




Longitudinal Section  
Scott & Co No 376

S.S. Harragansett  
Grt Report No 13608.

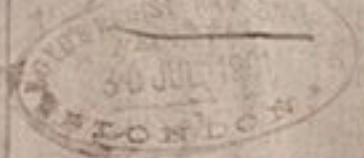

WRECK 29 Top

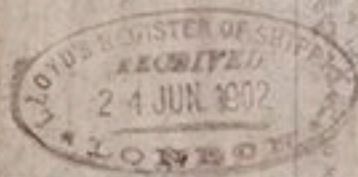

RETAIN

DEC 30  
LONDON



© 2018

Lloyd's Register  
Foundation