






WORKING PRESSURE 215 LBS. PER \square "

WASHERS $7\frac{1}{2}$ " DIA X $\frac{13}{16}$ " THK

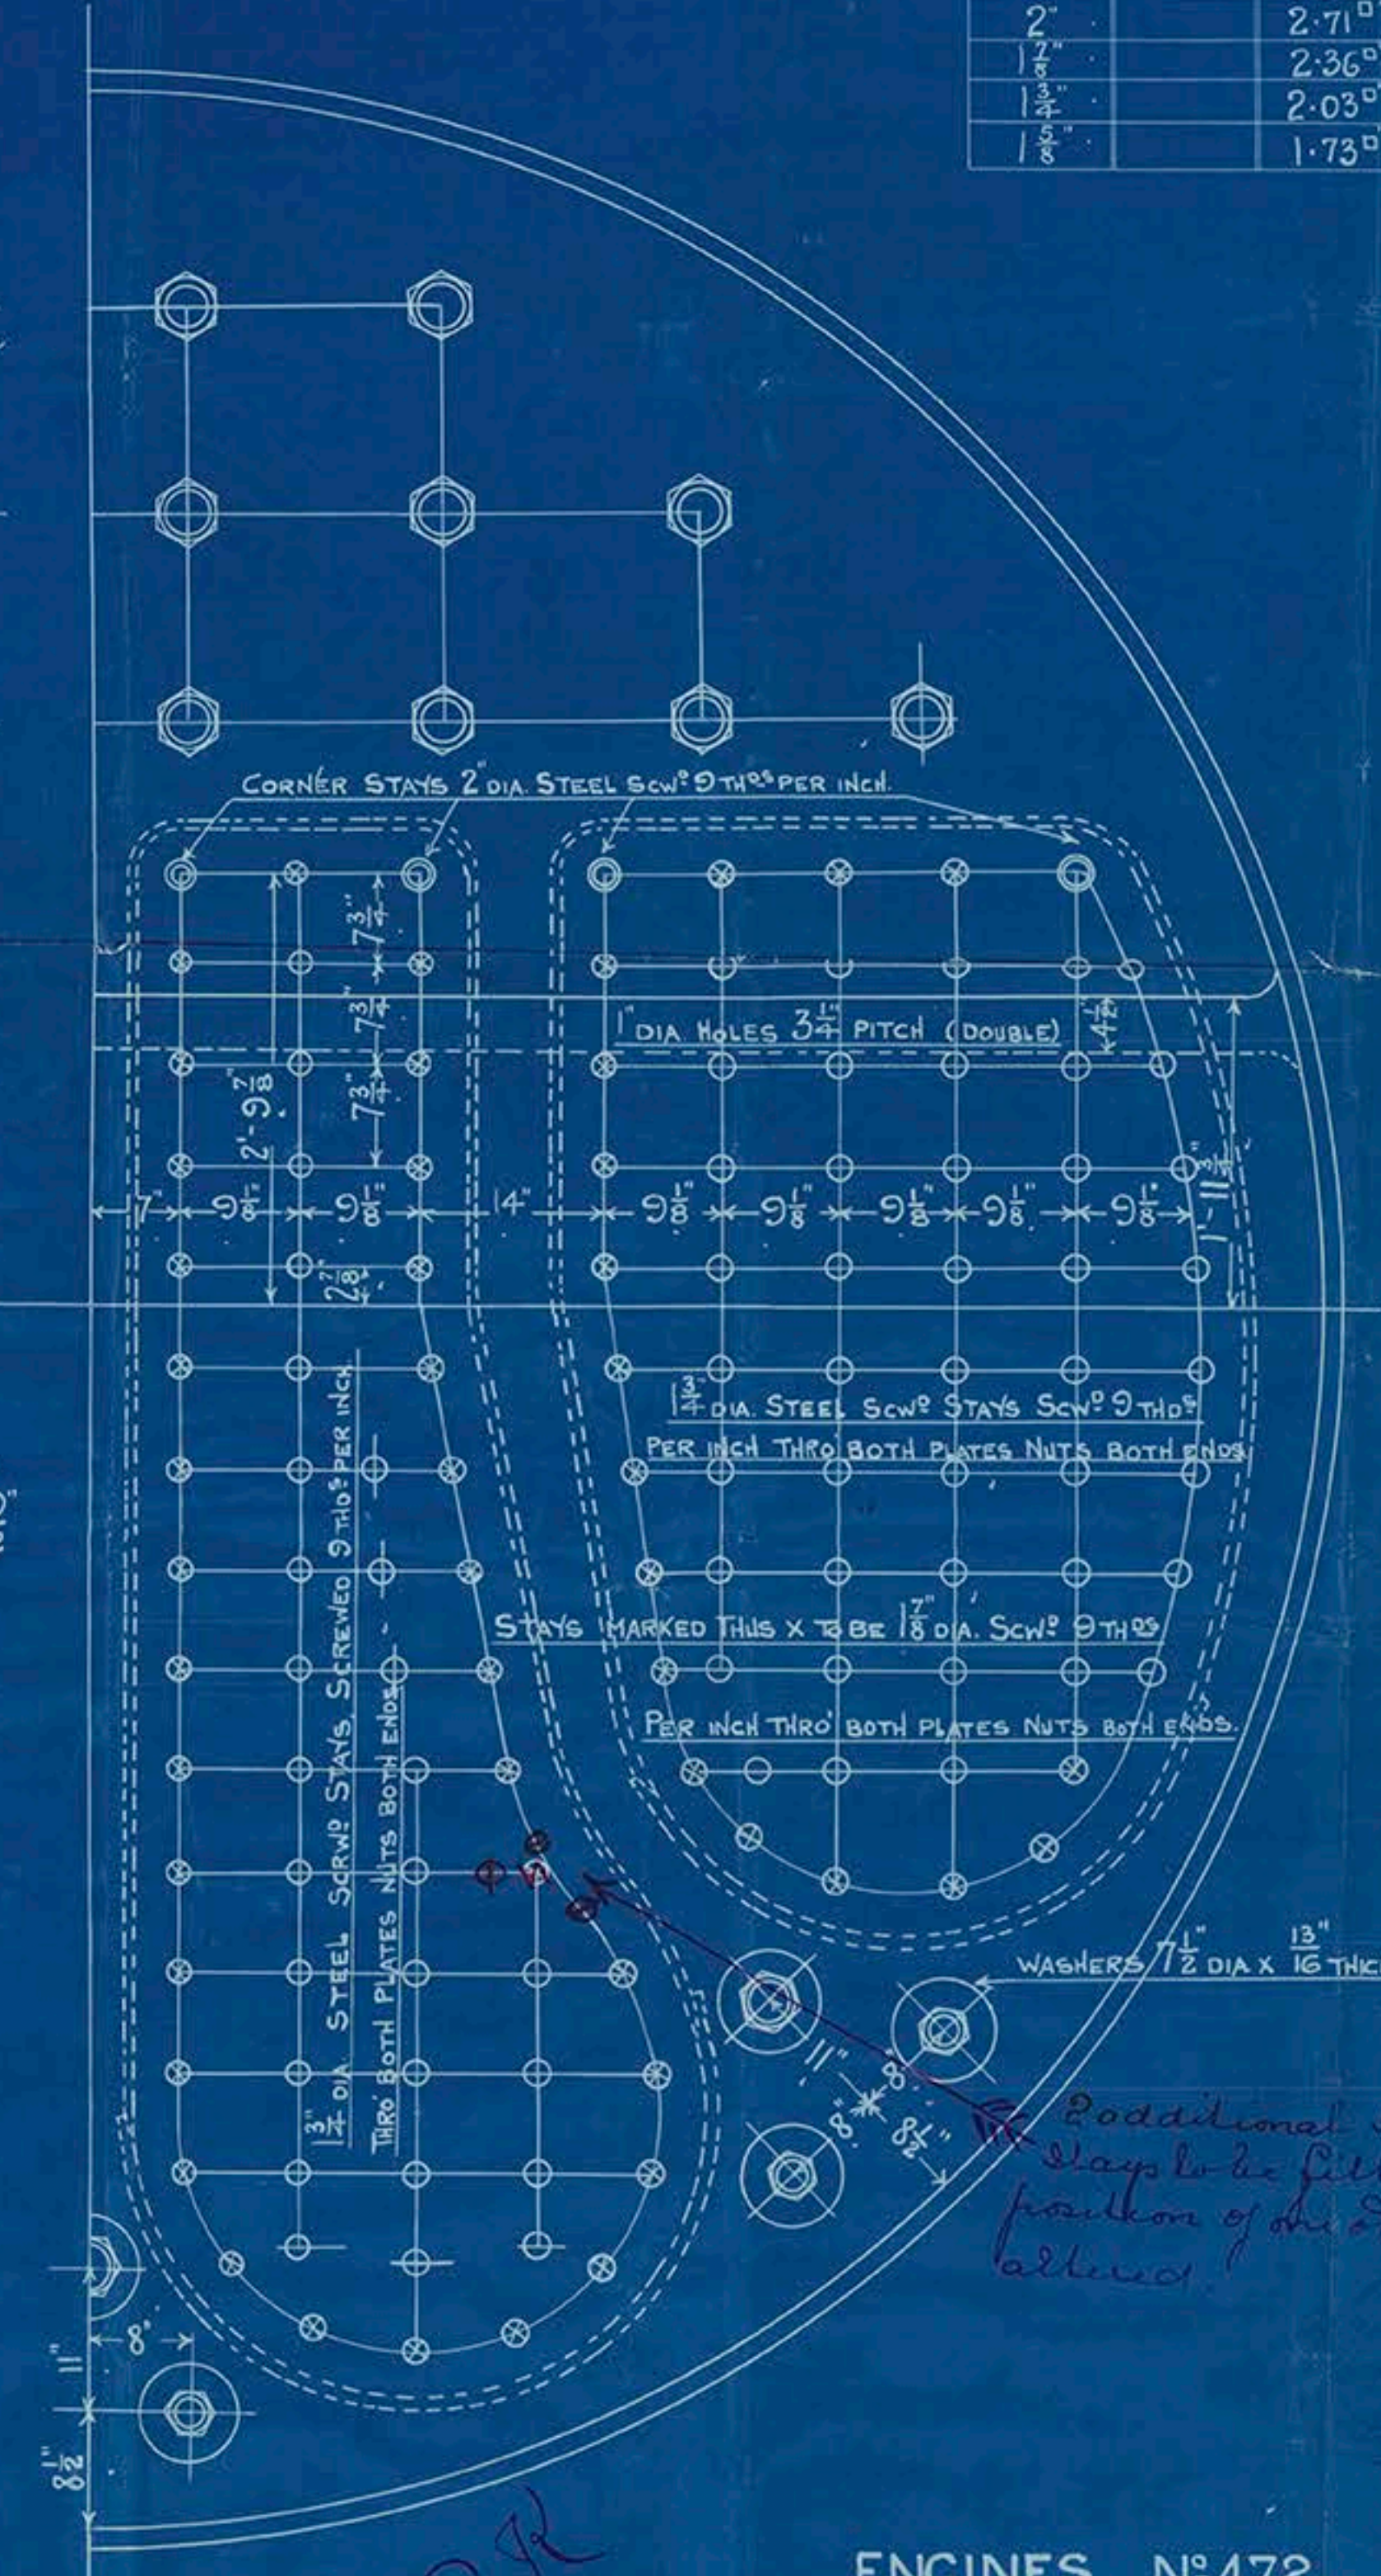

ENGINES N°472

MAIN BOILERS.

SCALE 1 INCH = 1 FOOT.

5 - OEE

checked 16/10/01
18/10/01
19/10/01
3

5 off
Parlay Cables.

N^o 472.

315 lbs. W. P.

11. Waratah
GLASGOW Report. No. 27140

Tested 5.6.08

Cert. 9513. 4 3/4 lbs. A.T.T.

Submitted 18/10/09



© 2018

Lloyd's Register
Foundation