

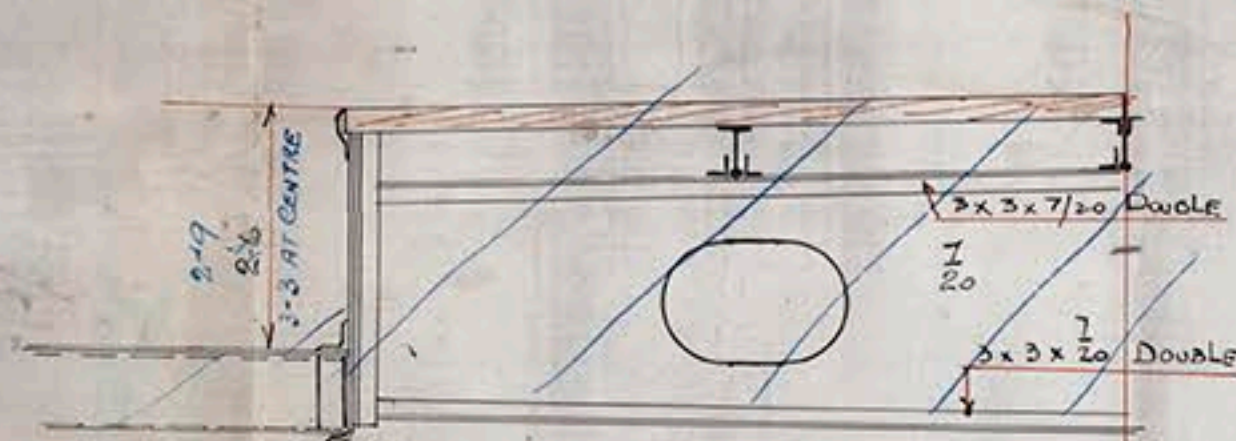


25.11.07

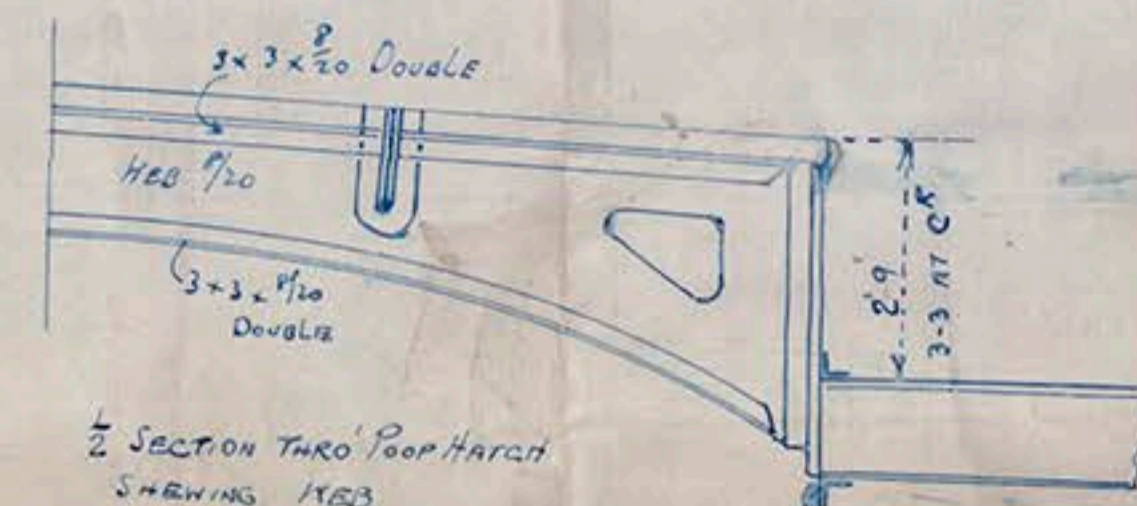

POOP BEAMS 11 x 3 1/2 x 3 1/2 OR 10 x 3 1/2 x 3 1/2 CHANNELS

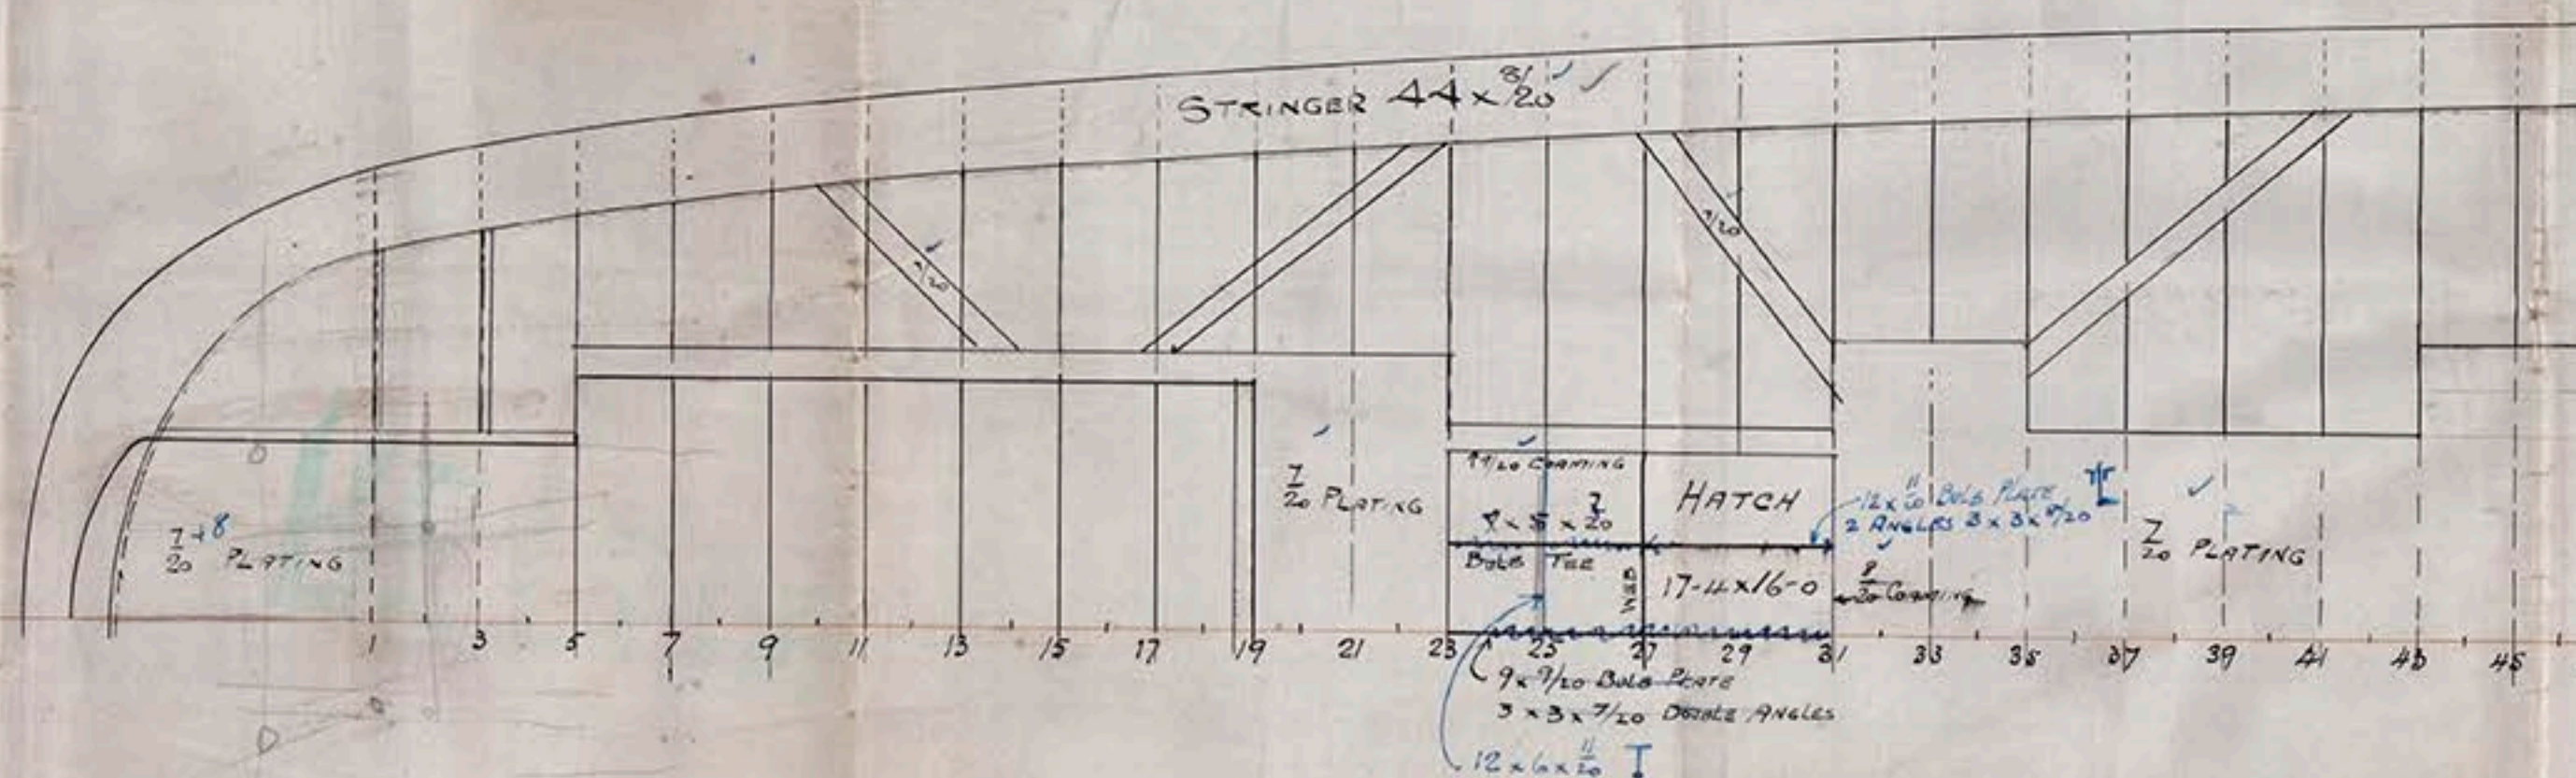



POOP BRIDGE & FOLE DECKS No 472 TSS

TO CLASS 100 A.I. SPAR D² RULE



SCALE 1/4" = ONE FOOT



BRIDGE DECK BEAMS 7 x 3 1/2 x 3 1/2 OR 10 x 3 1/2 x 3 1/2 CHANNELS

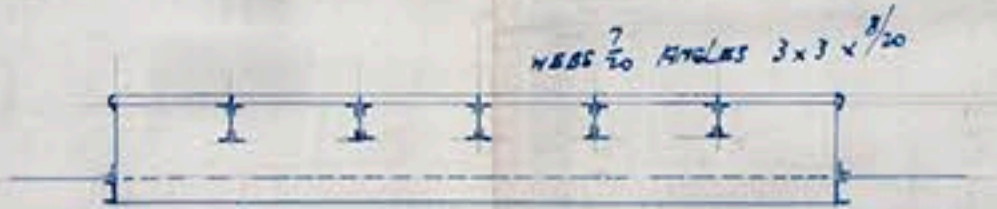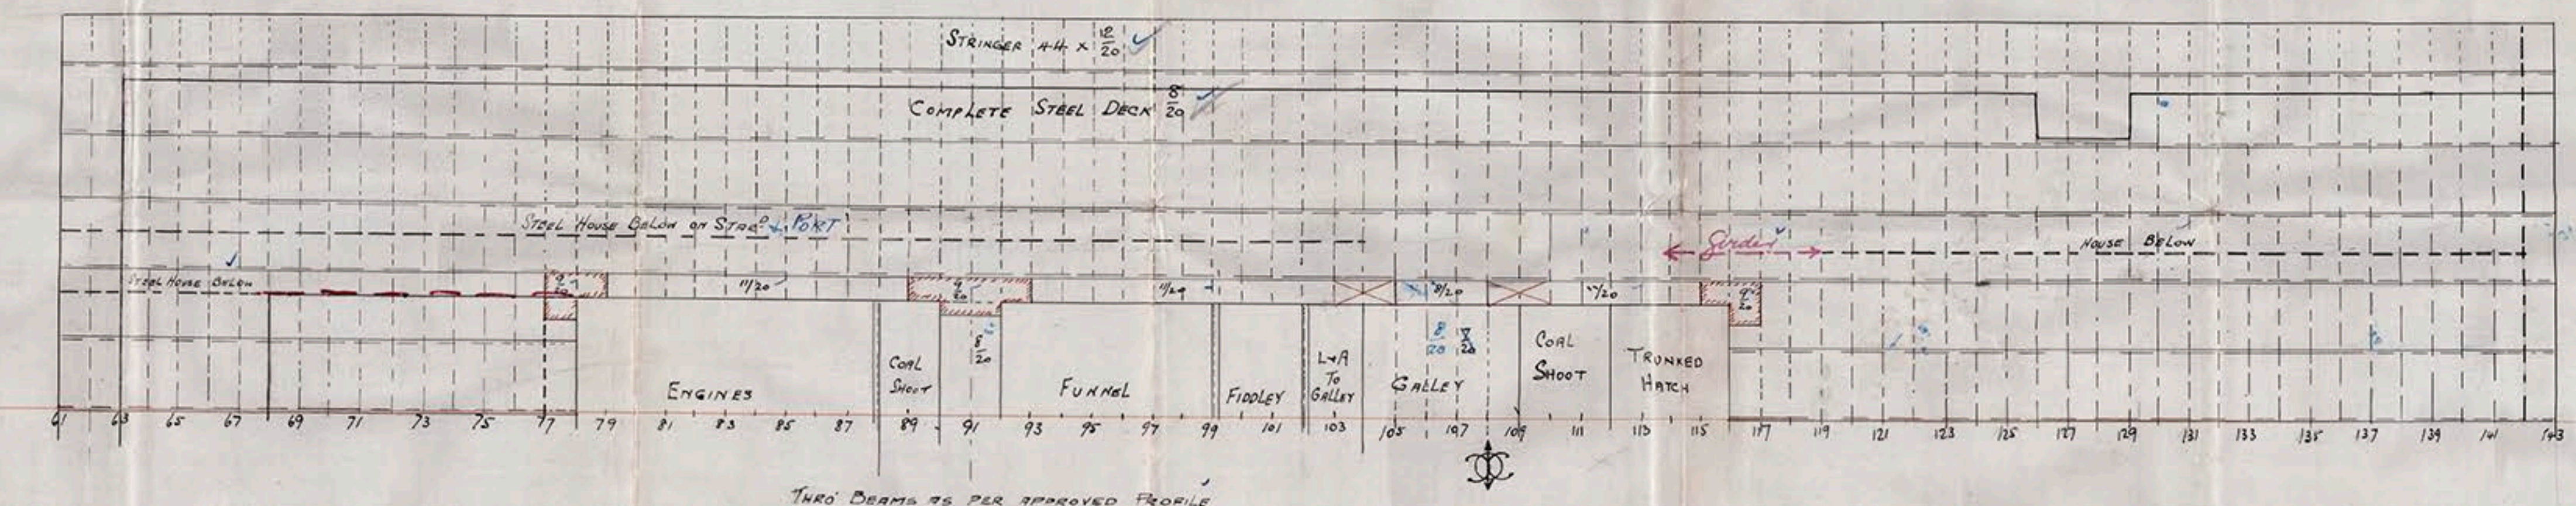

FOLE BEAMS 11 x 3 1/2 x 3 1/2 OR 10 x 3 1/2 x 3 1/2 CHANNELS

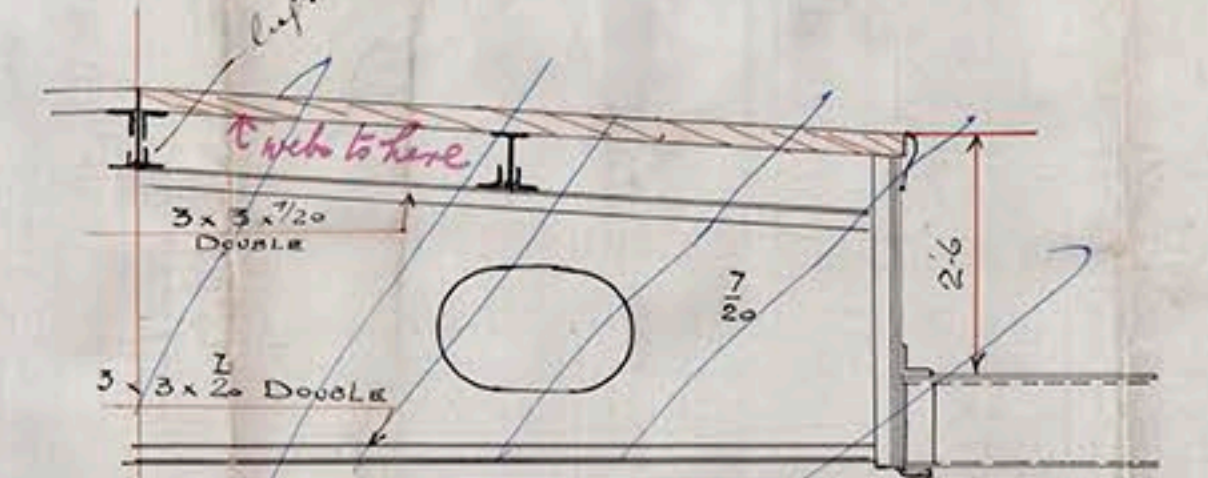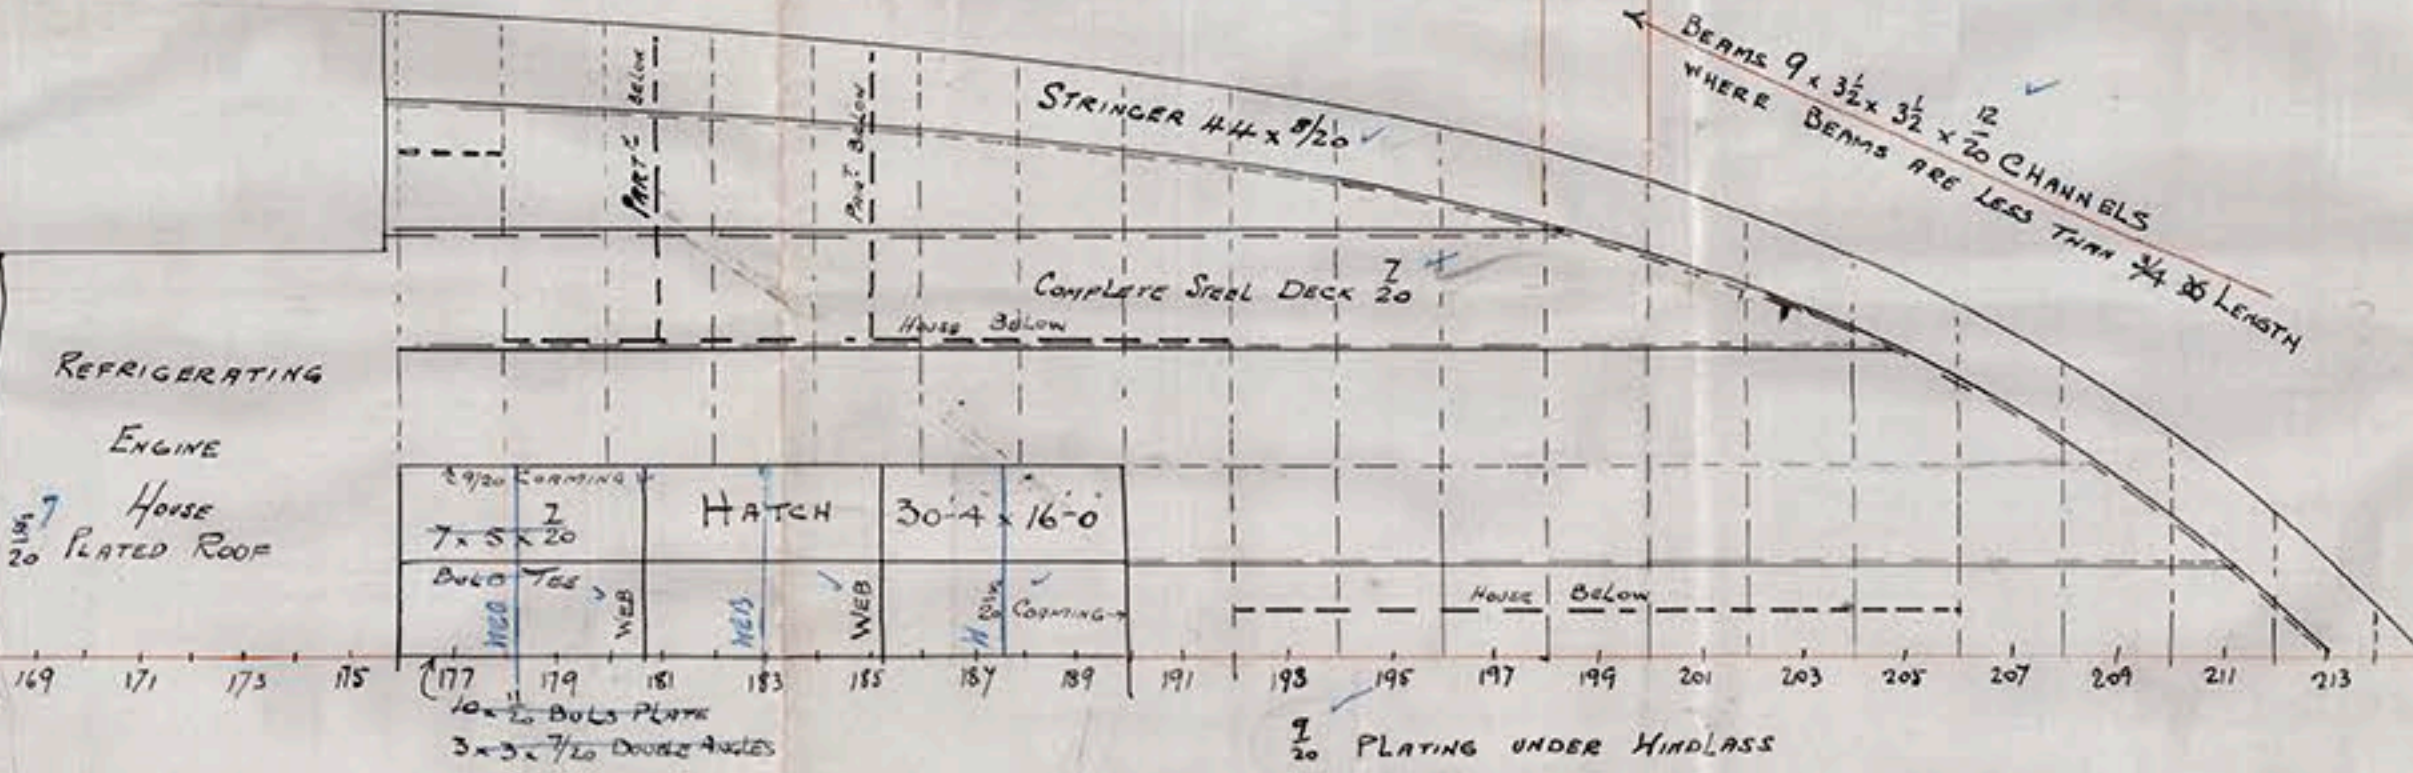

25.11.07


Barclay Curle & Co.

472 ✓

Ice. Bridge. & Prop. S&S


M. Waratah

GLASGOW Report No. 27140

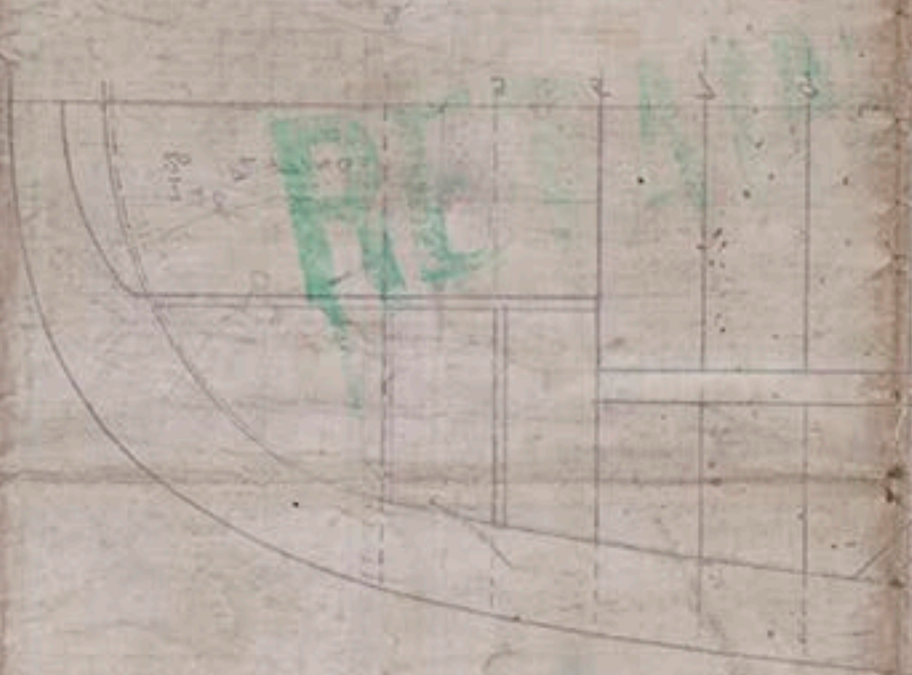

RECEIVED

32.11.02

 

© 2018

Lloyd's Register
Foundation