


Corrected to Lloyd's Improved Law  
23-4-1912.

IRVINE'S  
SHIP BUILDING  
AND 4.5.12  
DRY DOCKS CO LTD  
WEST HARTLEPOOL



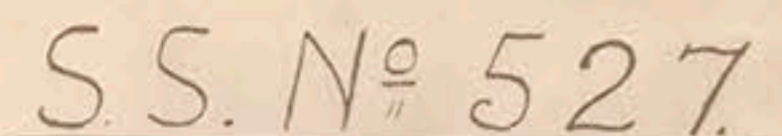

Irvine S.B. & D.D. Co

J. I. No. 527

Amended plan  
of Stern-frame.

"DIGBY"



Refat. No. 14645



BALTROVER

DESTROY  
1975



© 2018

Lloyd's Register  
Foundation

LR-FAF-TB23-P.5