


27-9-1918.

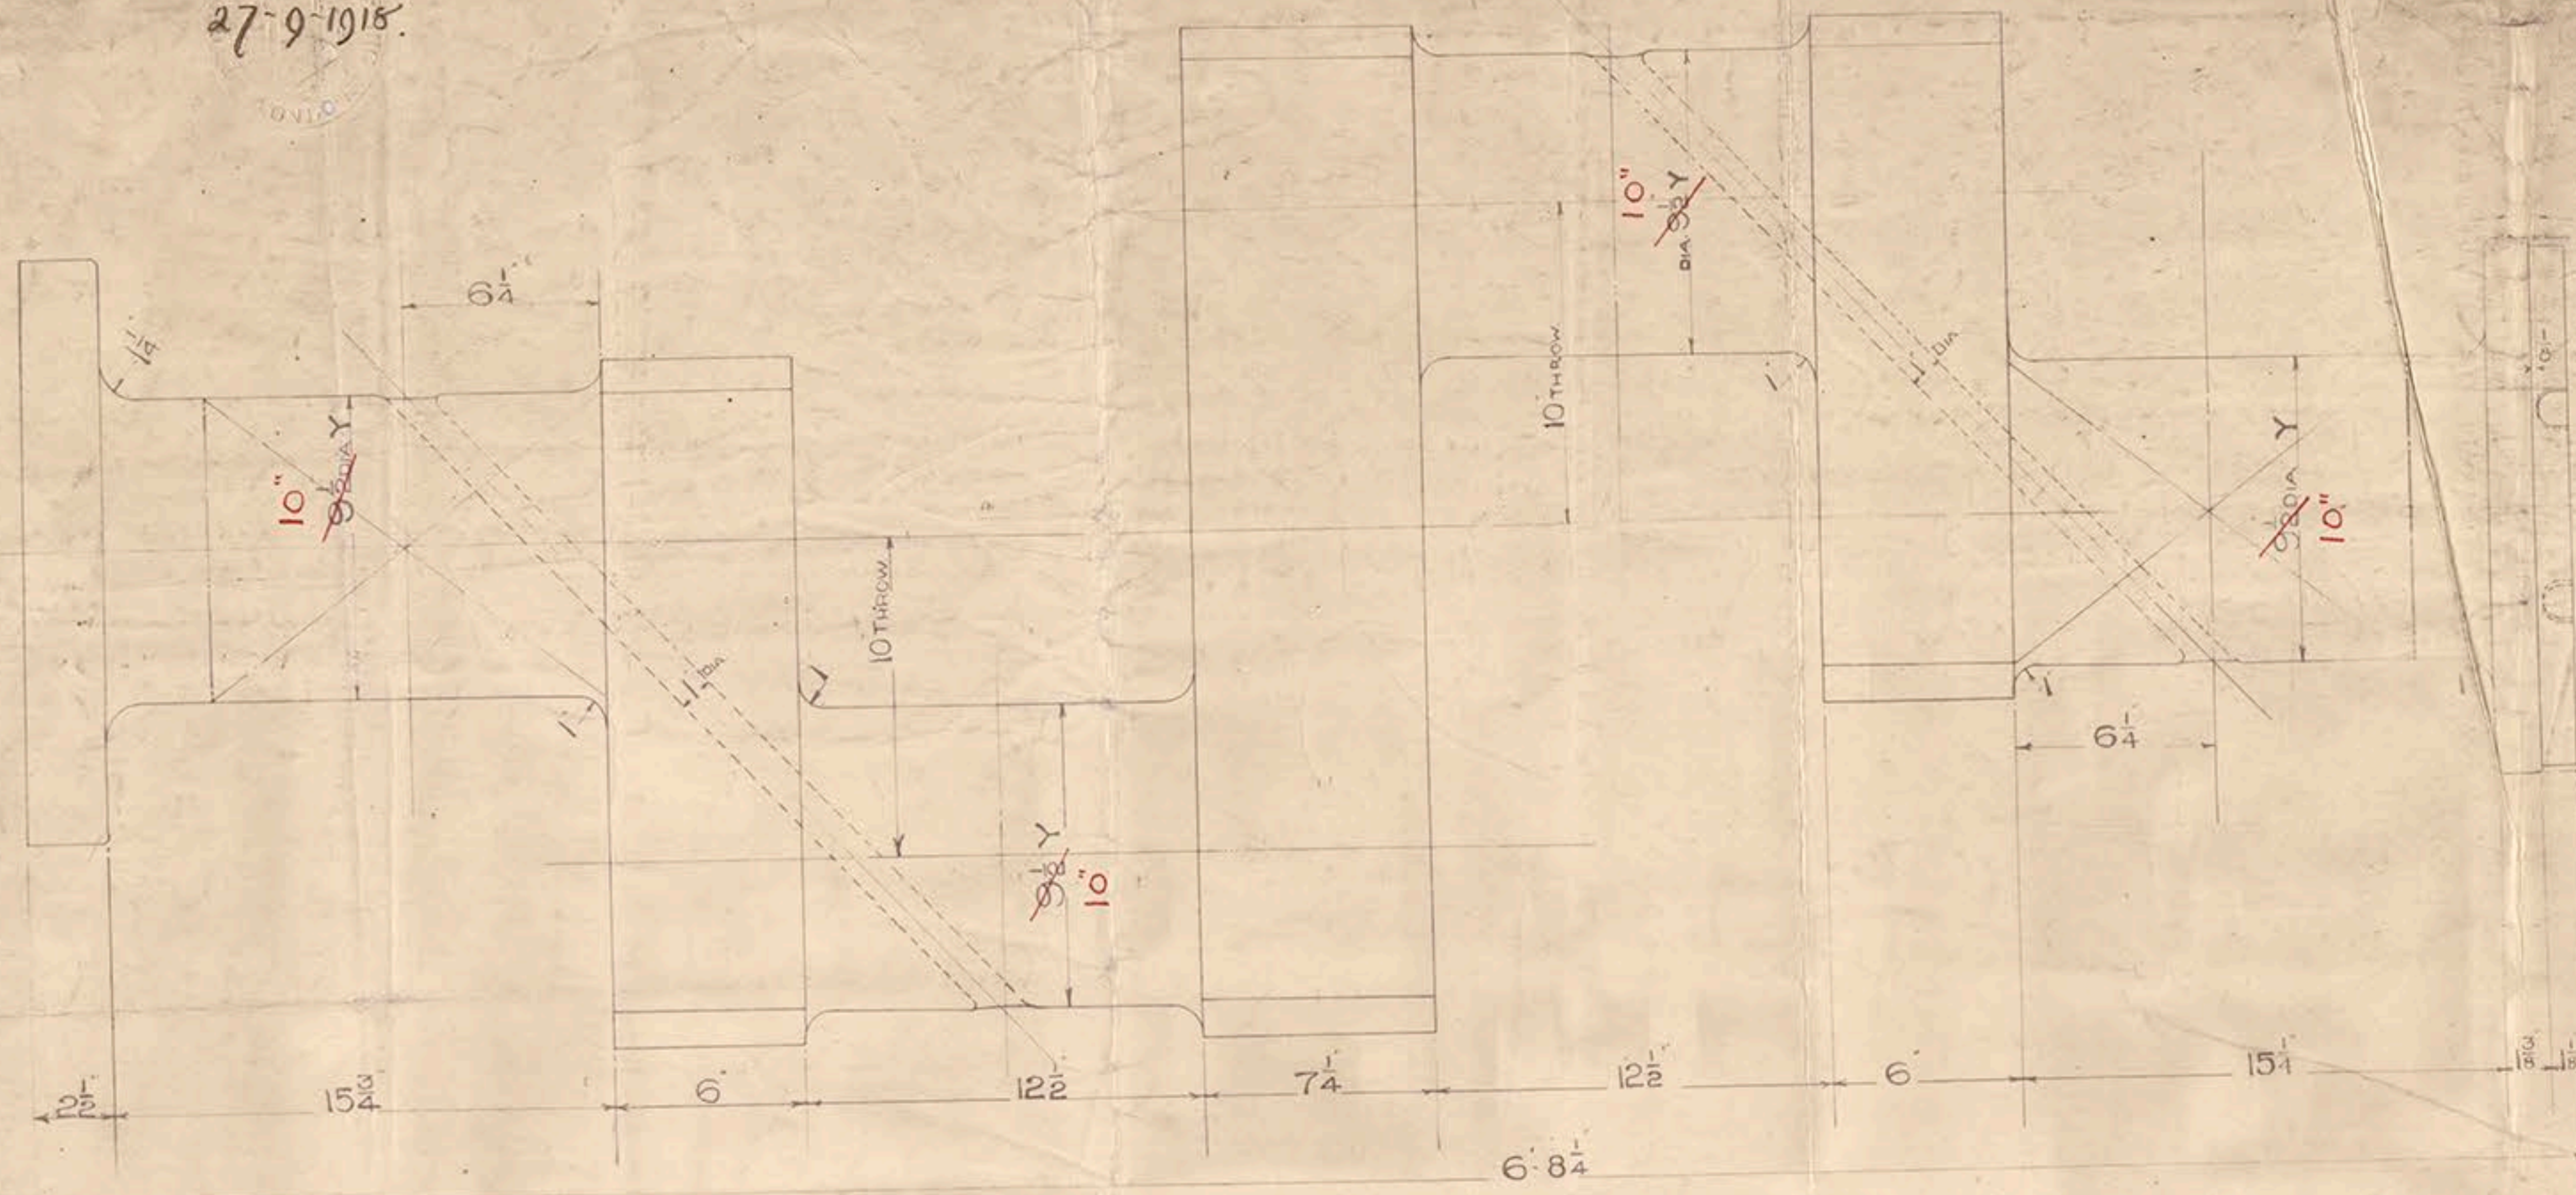



Samuel Lloyd Hb.

No 552

© 2018



Lloyd's Register  
Foundation

S.P.

Shenan

n.n.

Pedros



© 2018

Lloyd's Register  
Foundation