

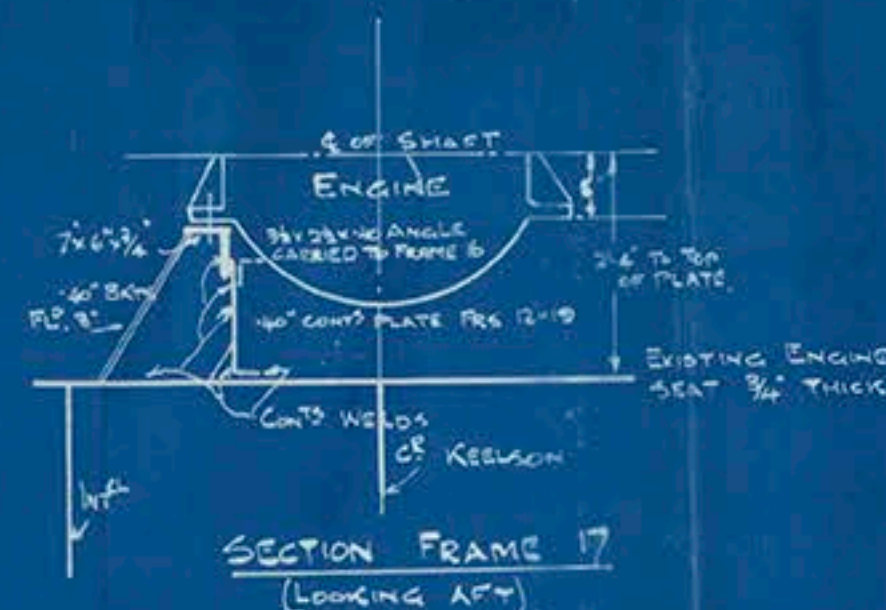
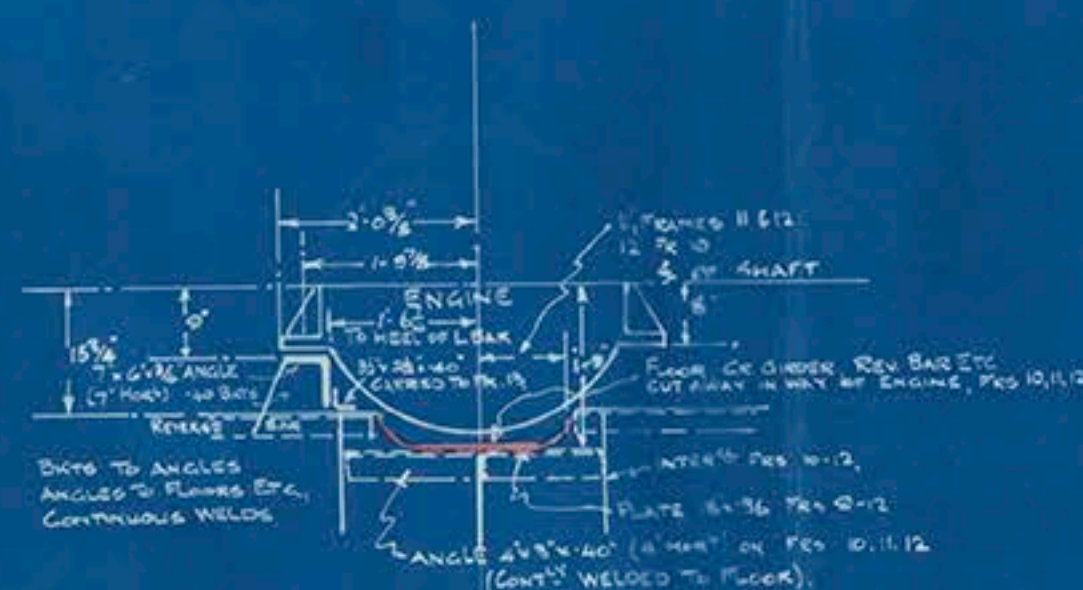
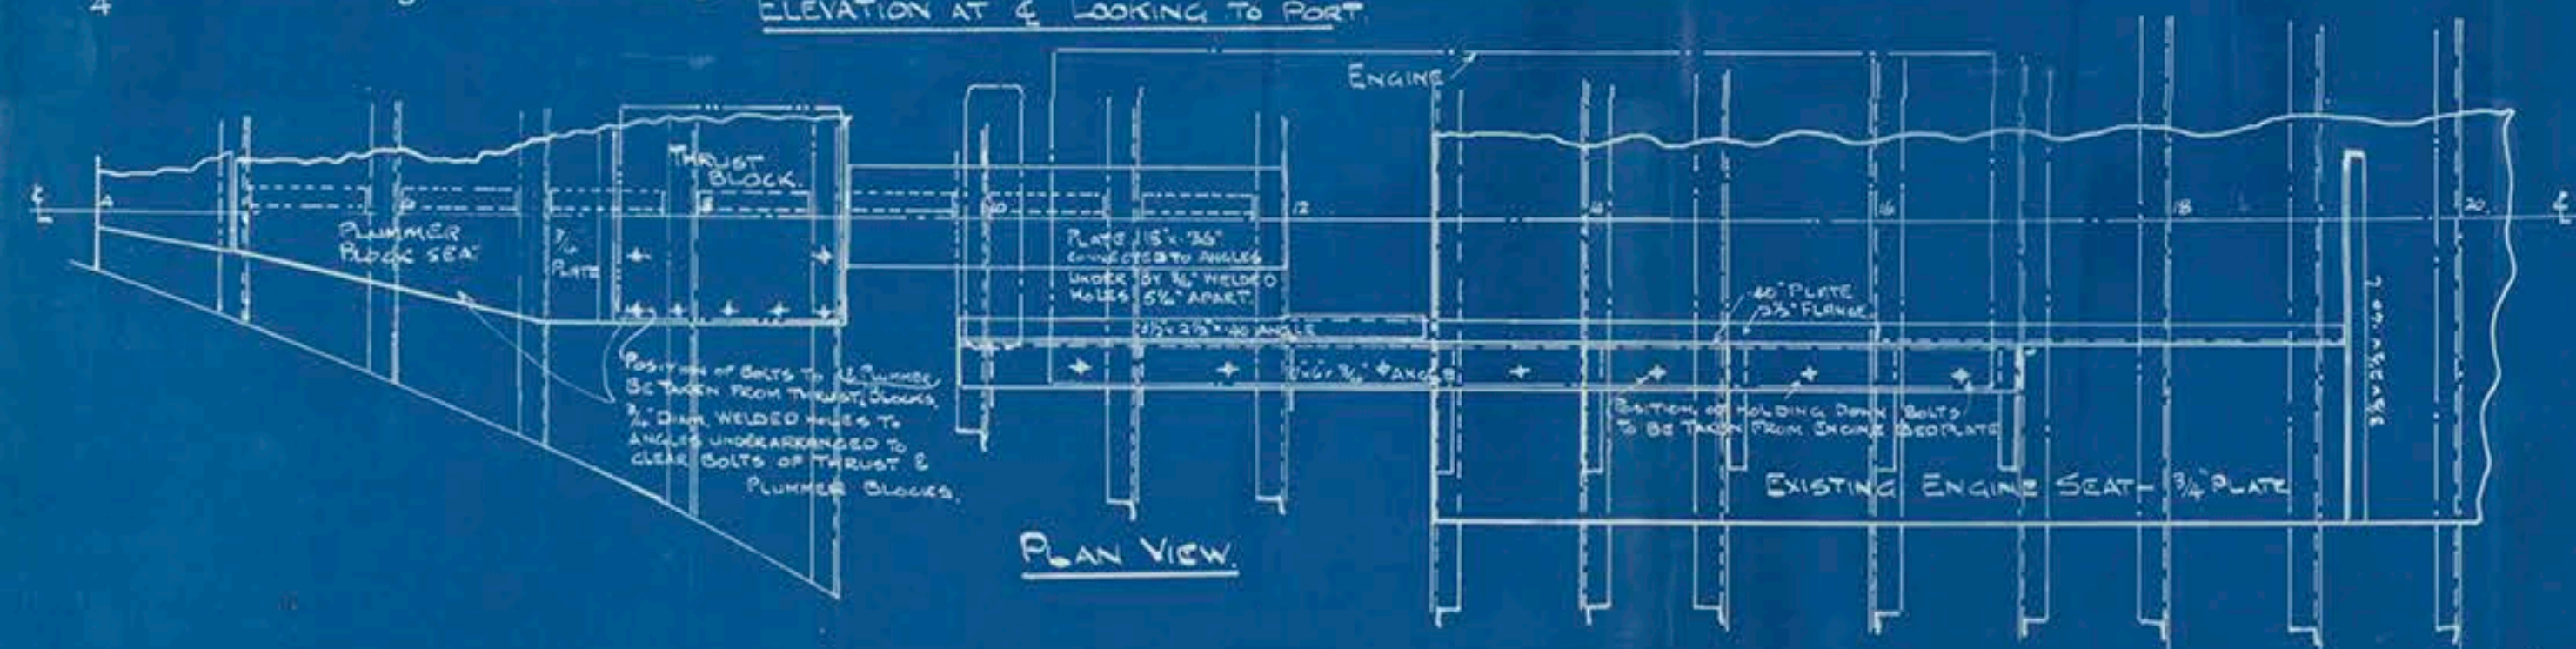



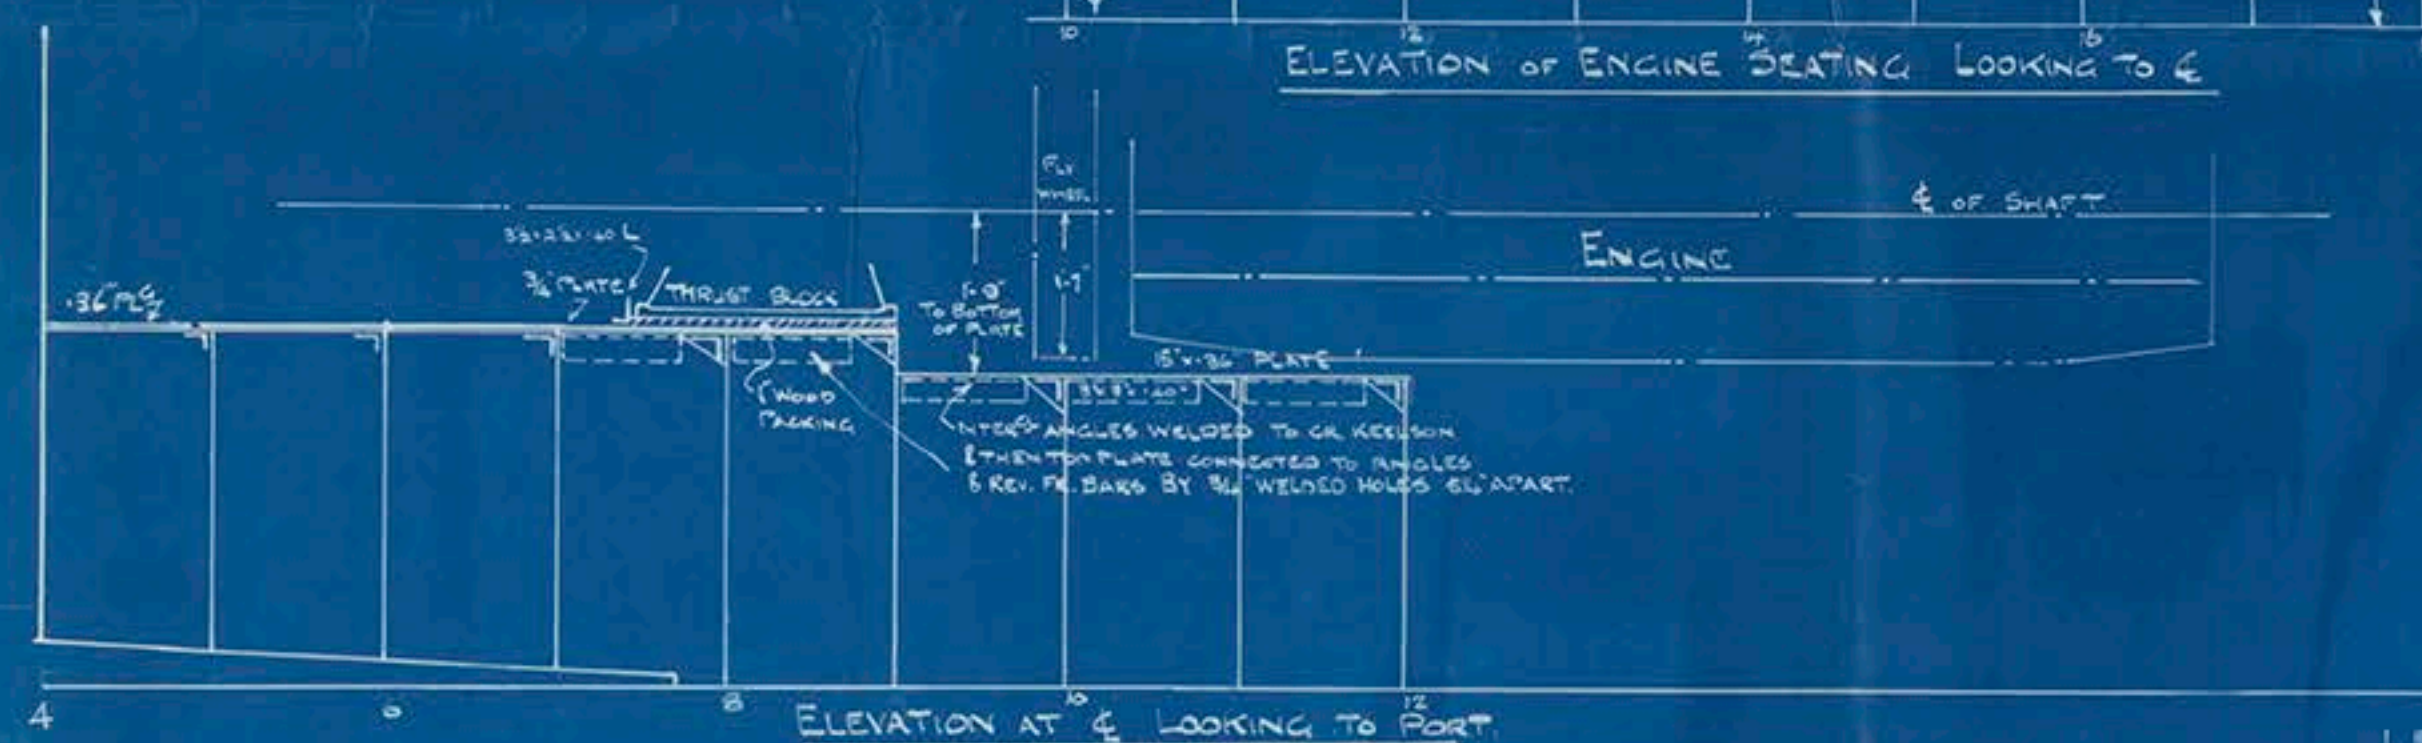


M.S. FULLAGAR
ENGINE SEATS (BEARDMORE) — FLY.
SCALE 1/2" = ONE FOOT.

NOTE: — WHERE MATERIAL IS BURNT OUT,
EDGES MUST BE CHIPPED IF
ANYTHING IS TO BE WELDED TO
THEM.

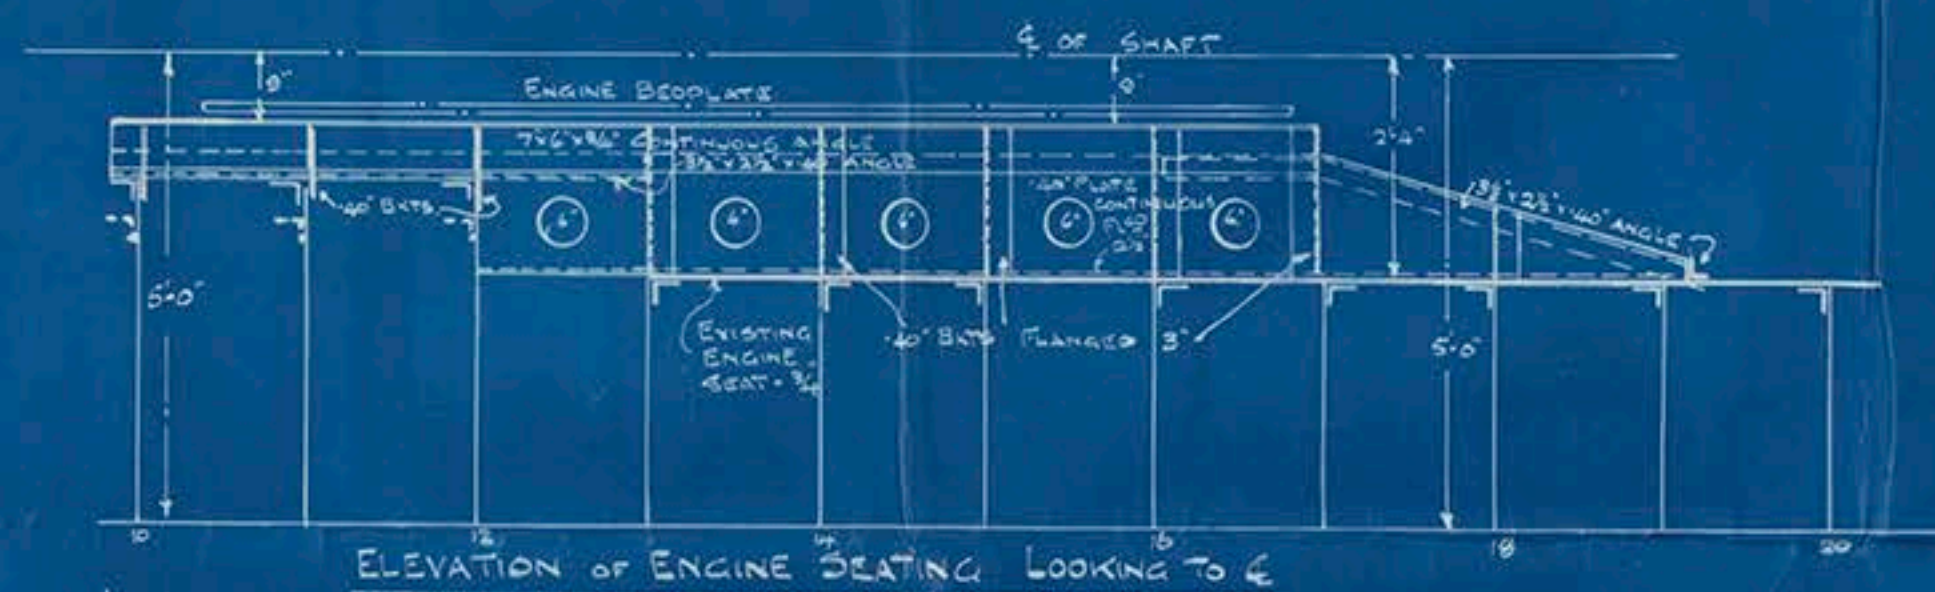

MATERIAL TO BE CUT OUT, THUS

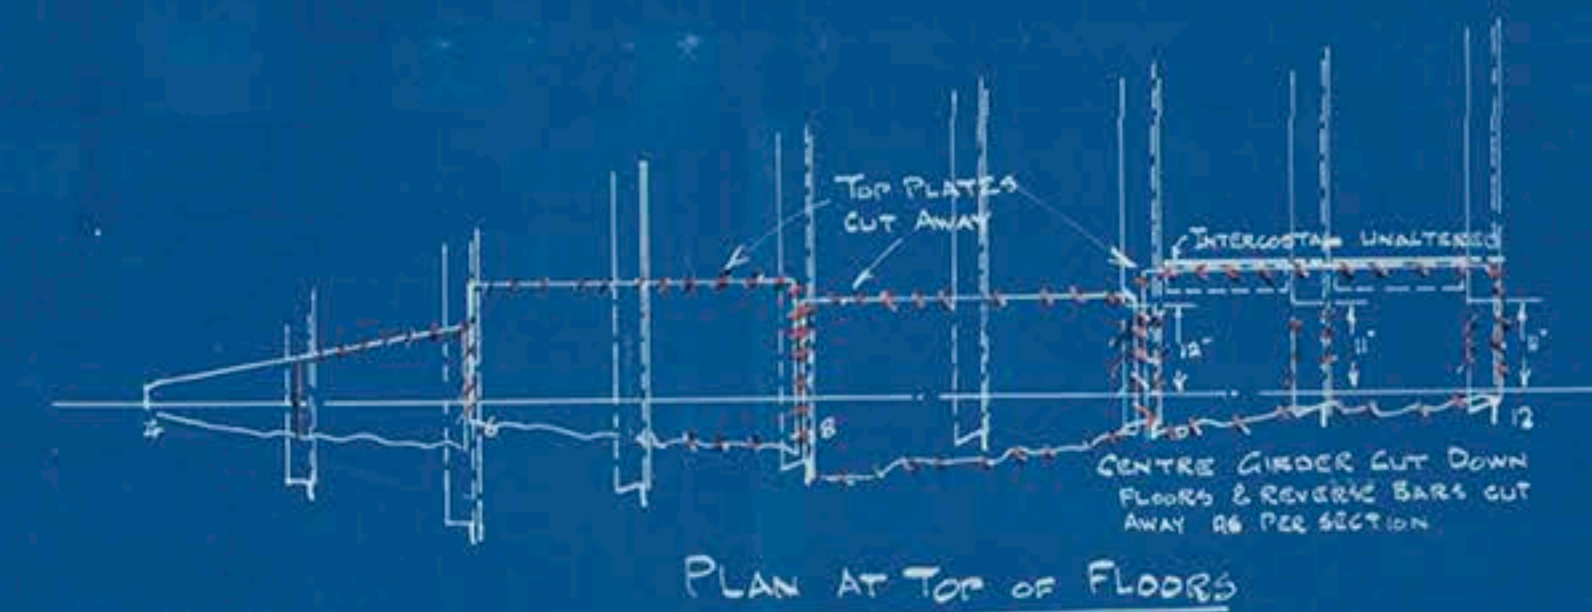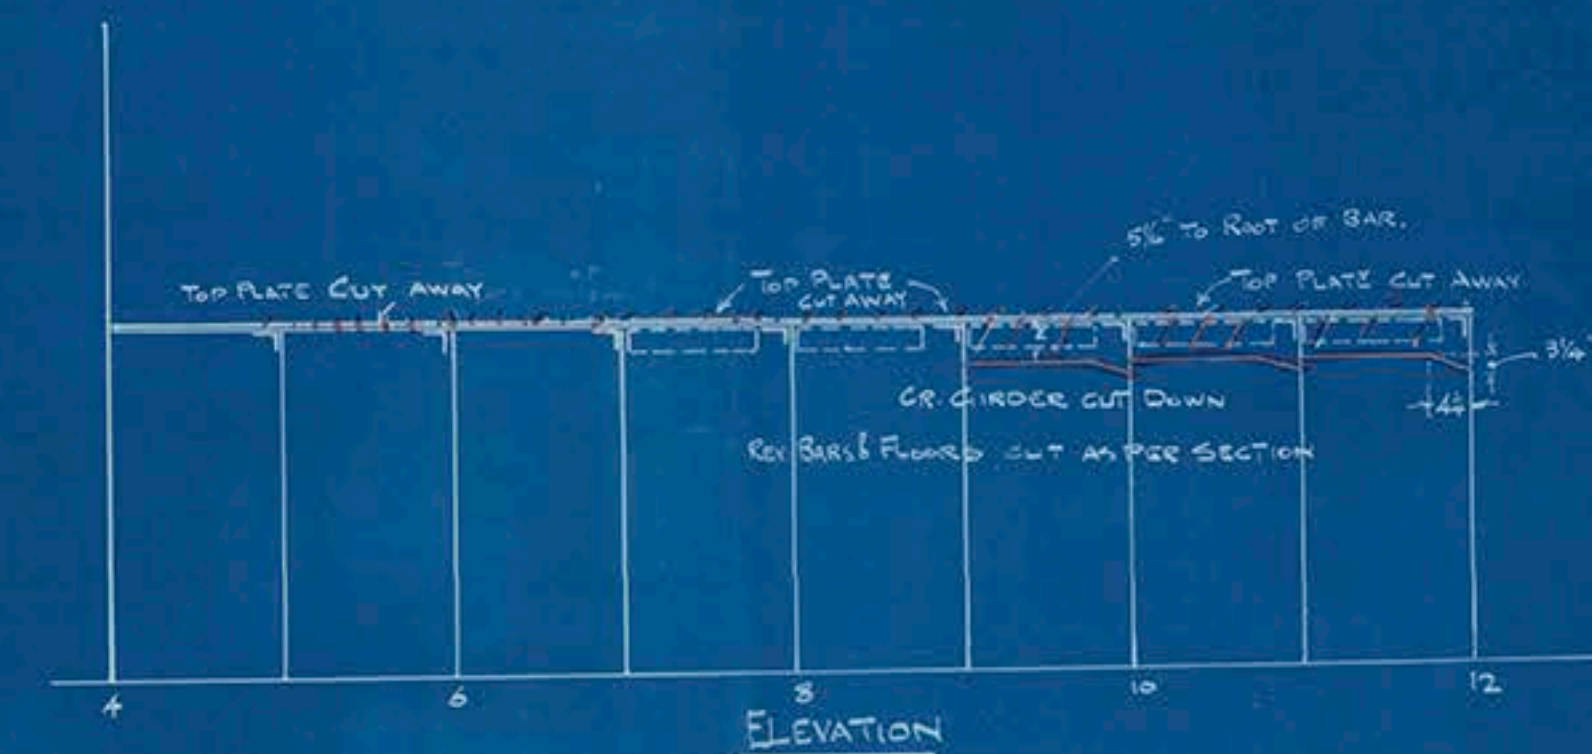

G.P.P.
R.
11/1/21

M. P. Fullagar
Amended plan of Engine Seats.

S.S. "Fullagar"



© 2018

LIVERPOOL;

Report No. 82808
Lloyd's Register
Foundation