



SCALE 1/16 INCH=1 FOOT.

PRINCIPAL DIMENSIONS

LENGTH OVERALL	574-6
BREADTH MOULDED	74-0
DEPTH MOULDED TO UPPER DECK (D)	42-6
MEAN DRAFT	24'-10"

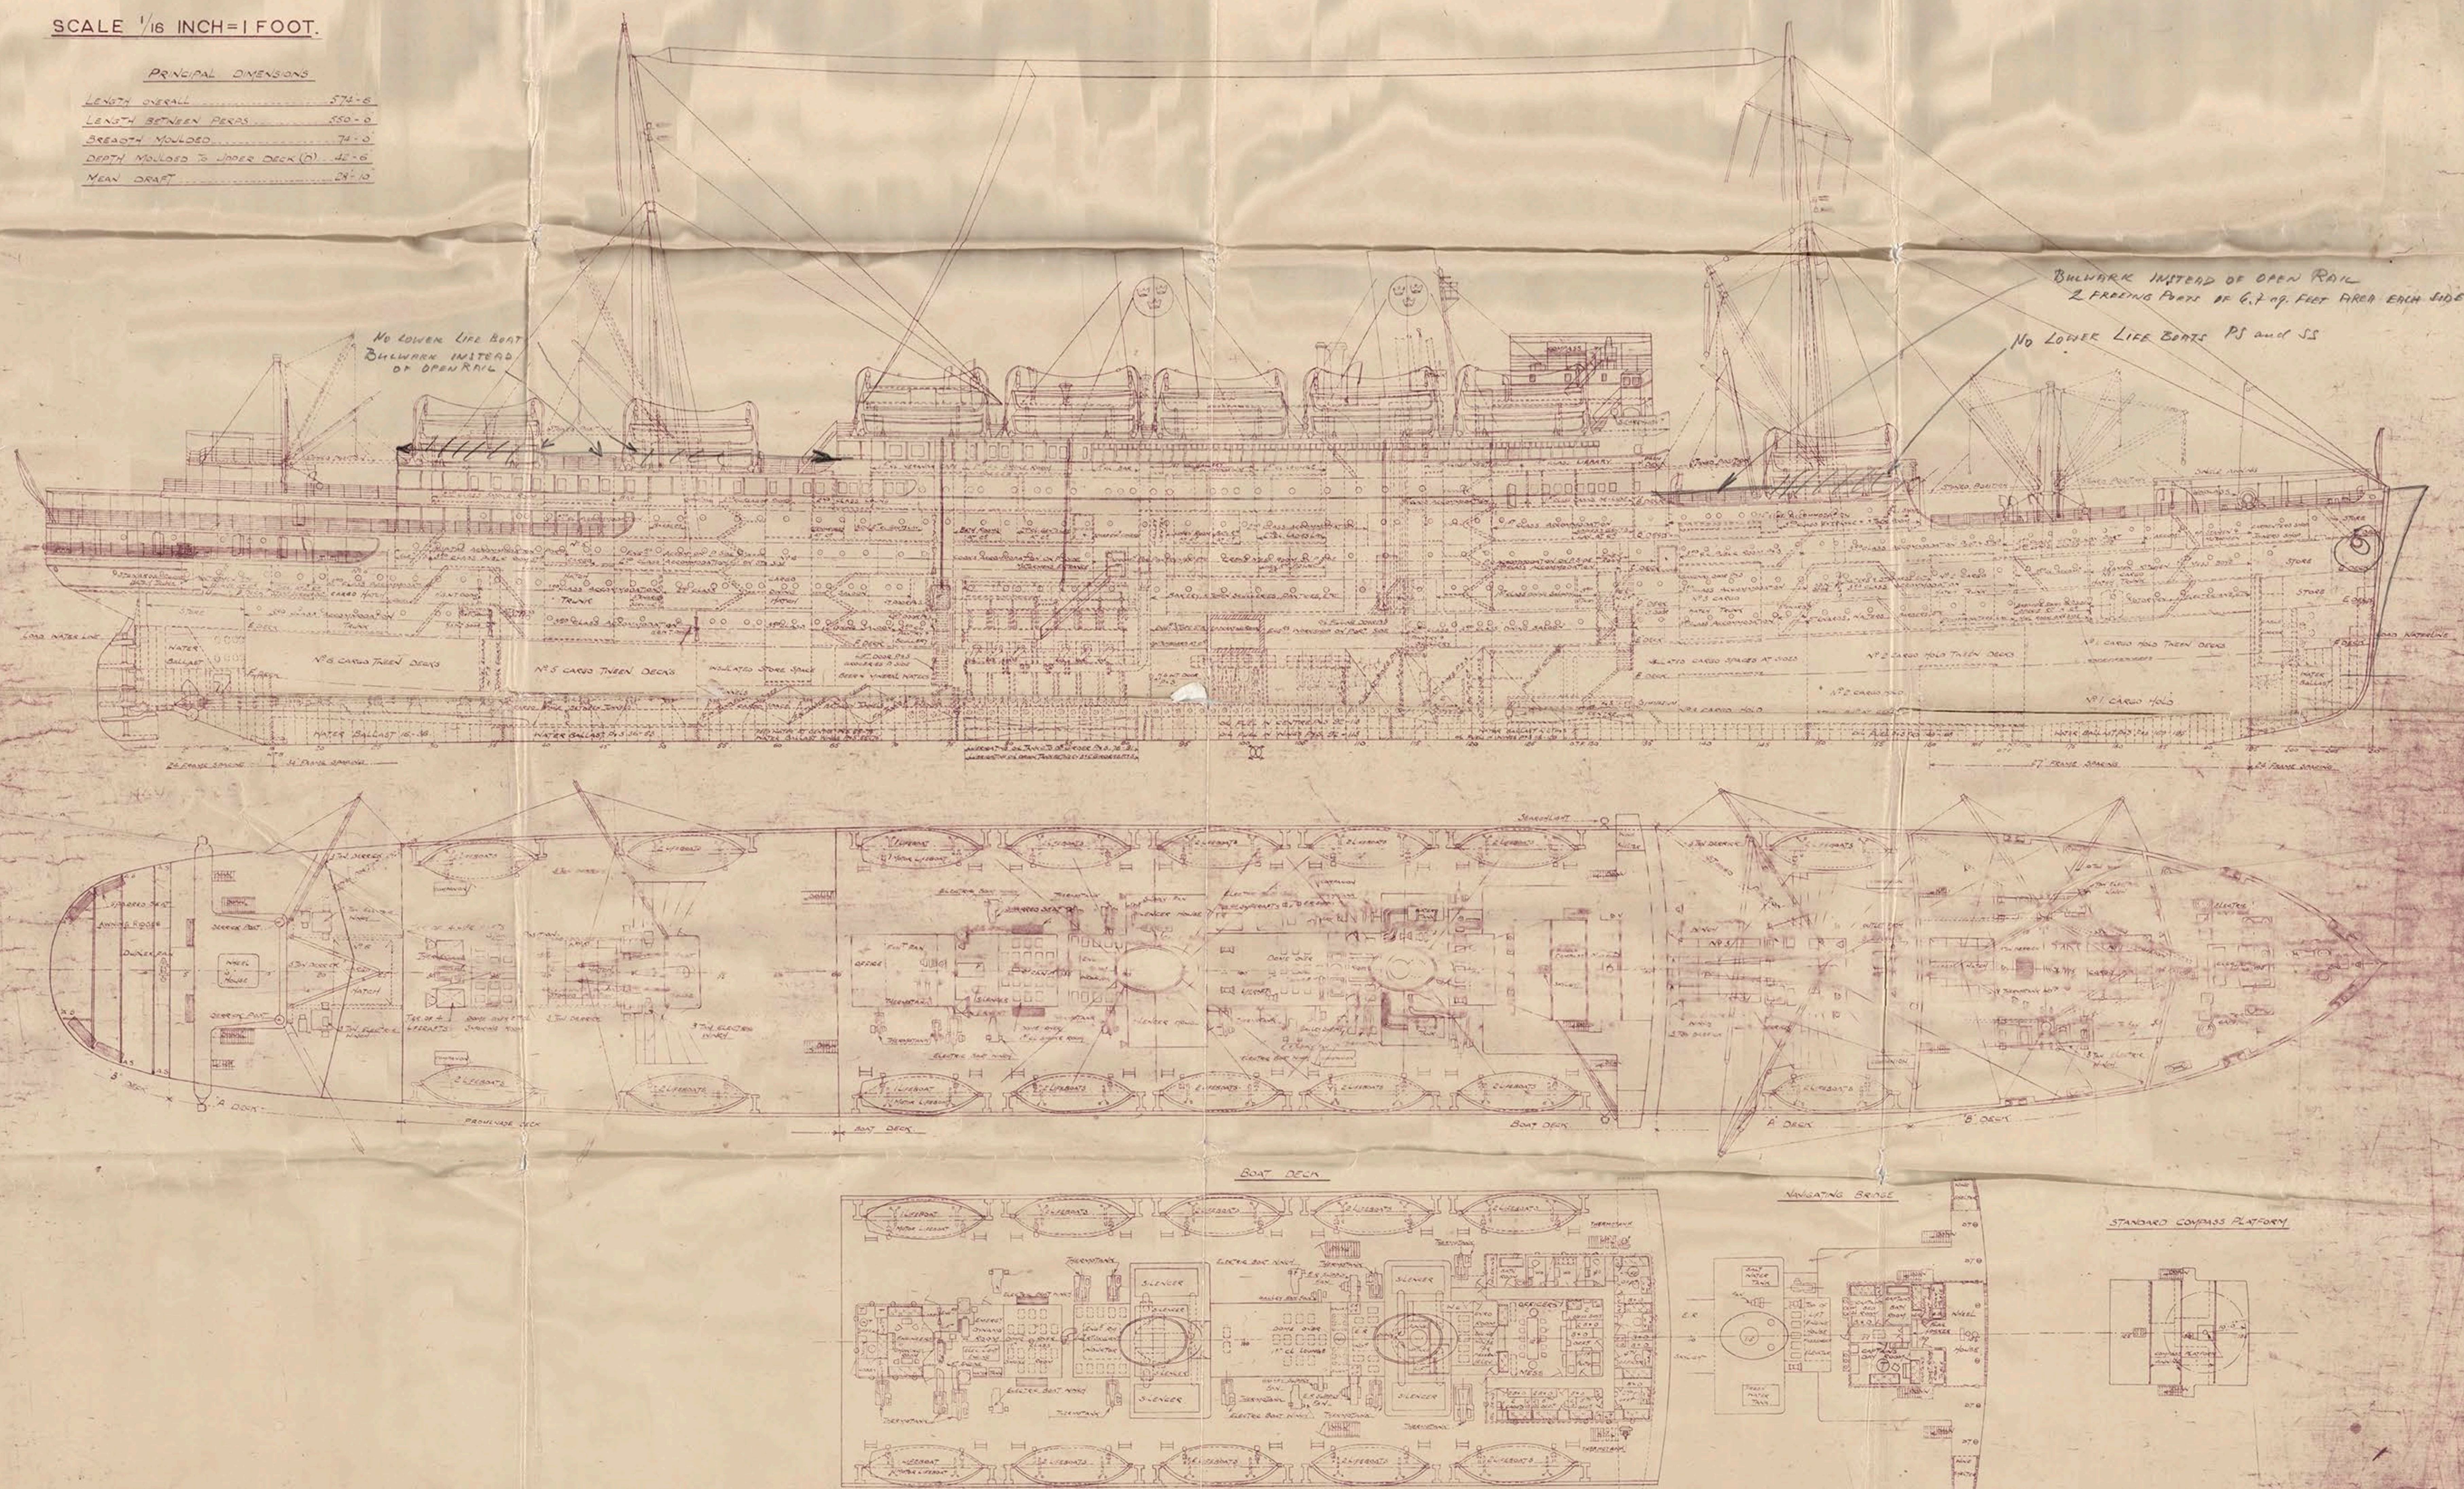


Gipsstolen 

General Angst.

Ham 158

RECORDS DEPT..
LONDON

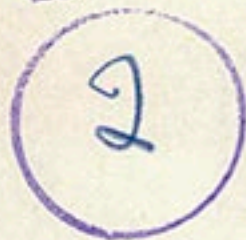

© 2018

Lloyd's Register
Foundation

LR-FAC-T015-P.4