


9. 6. 20

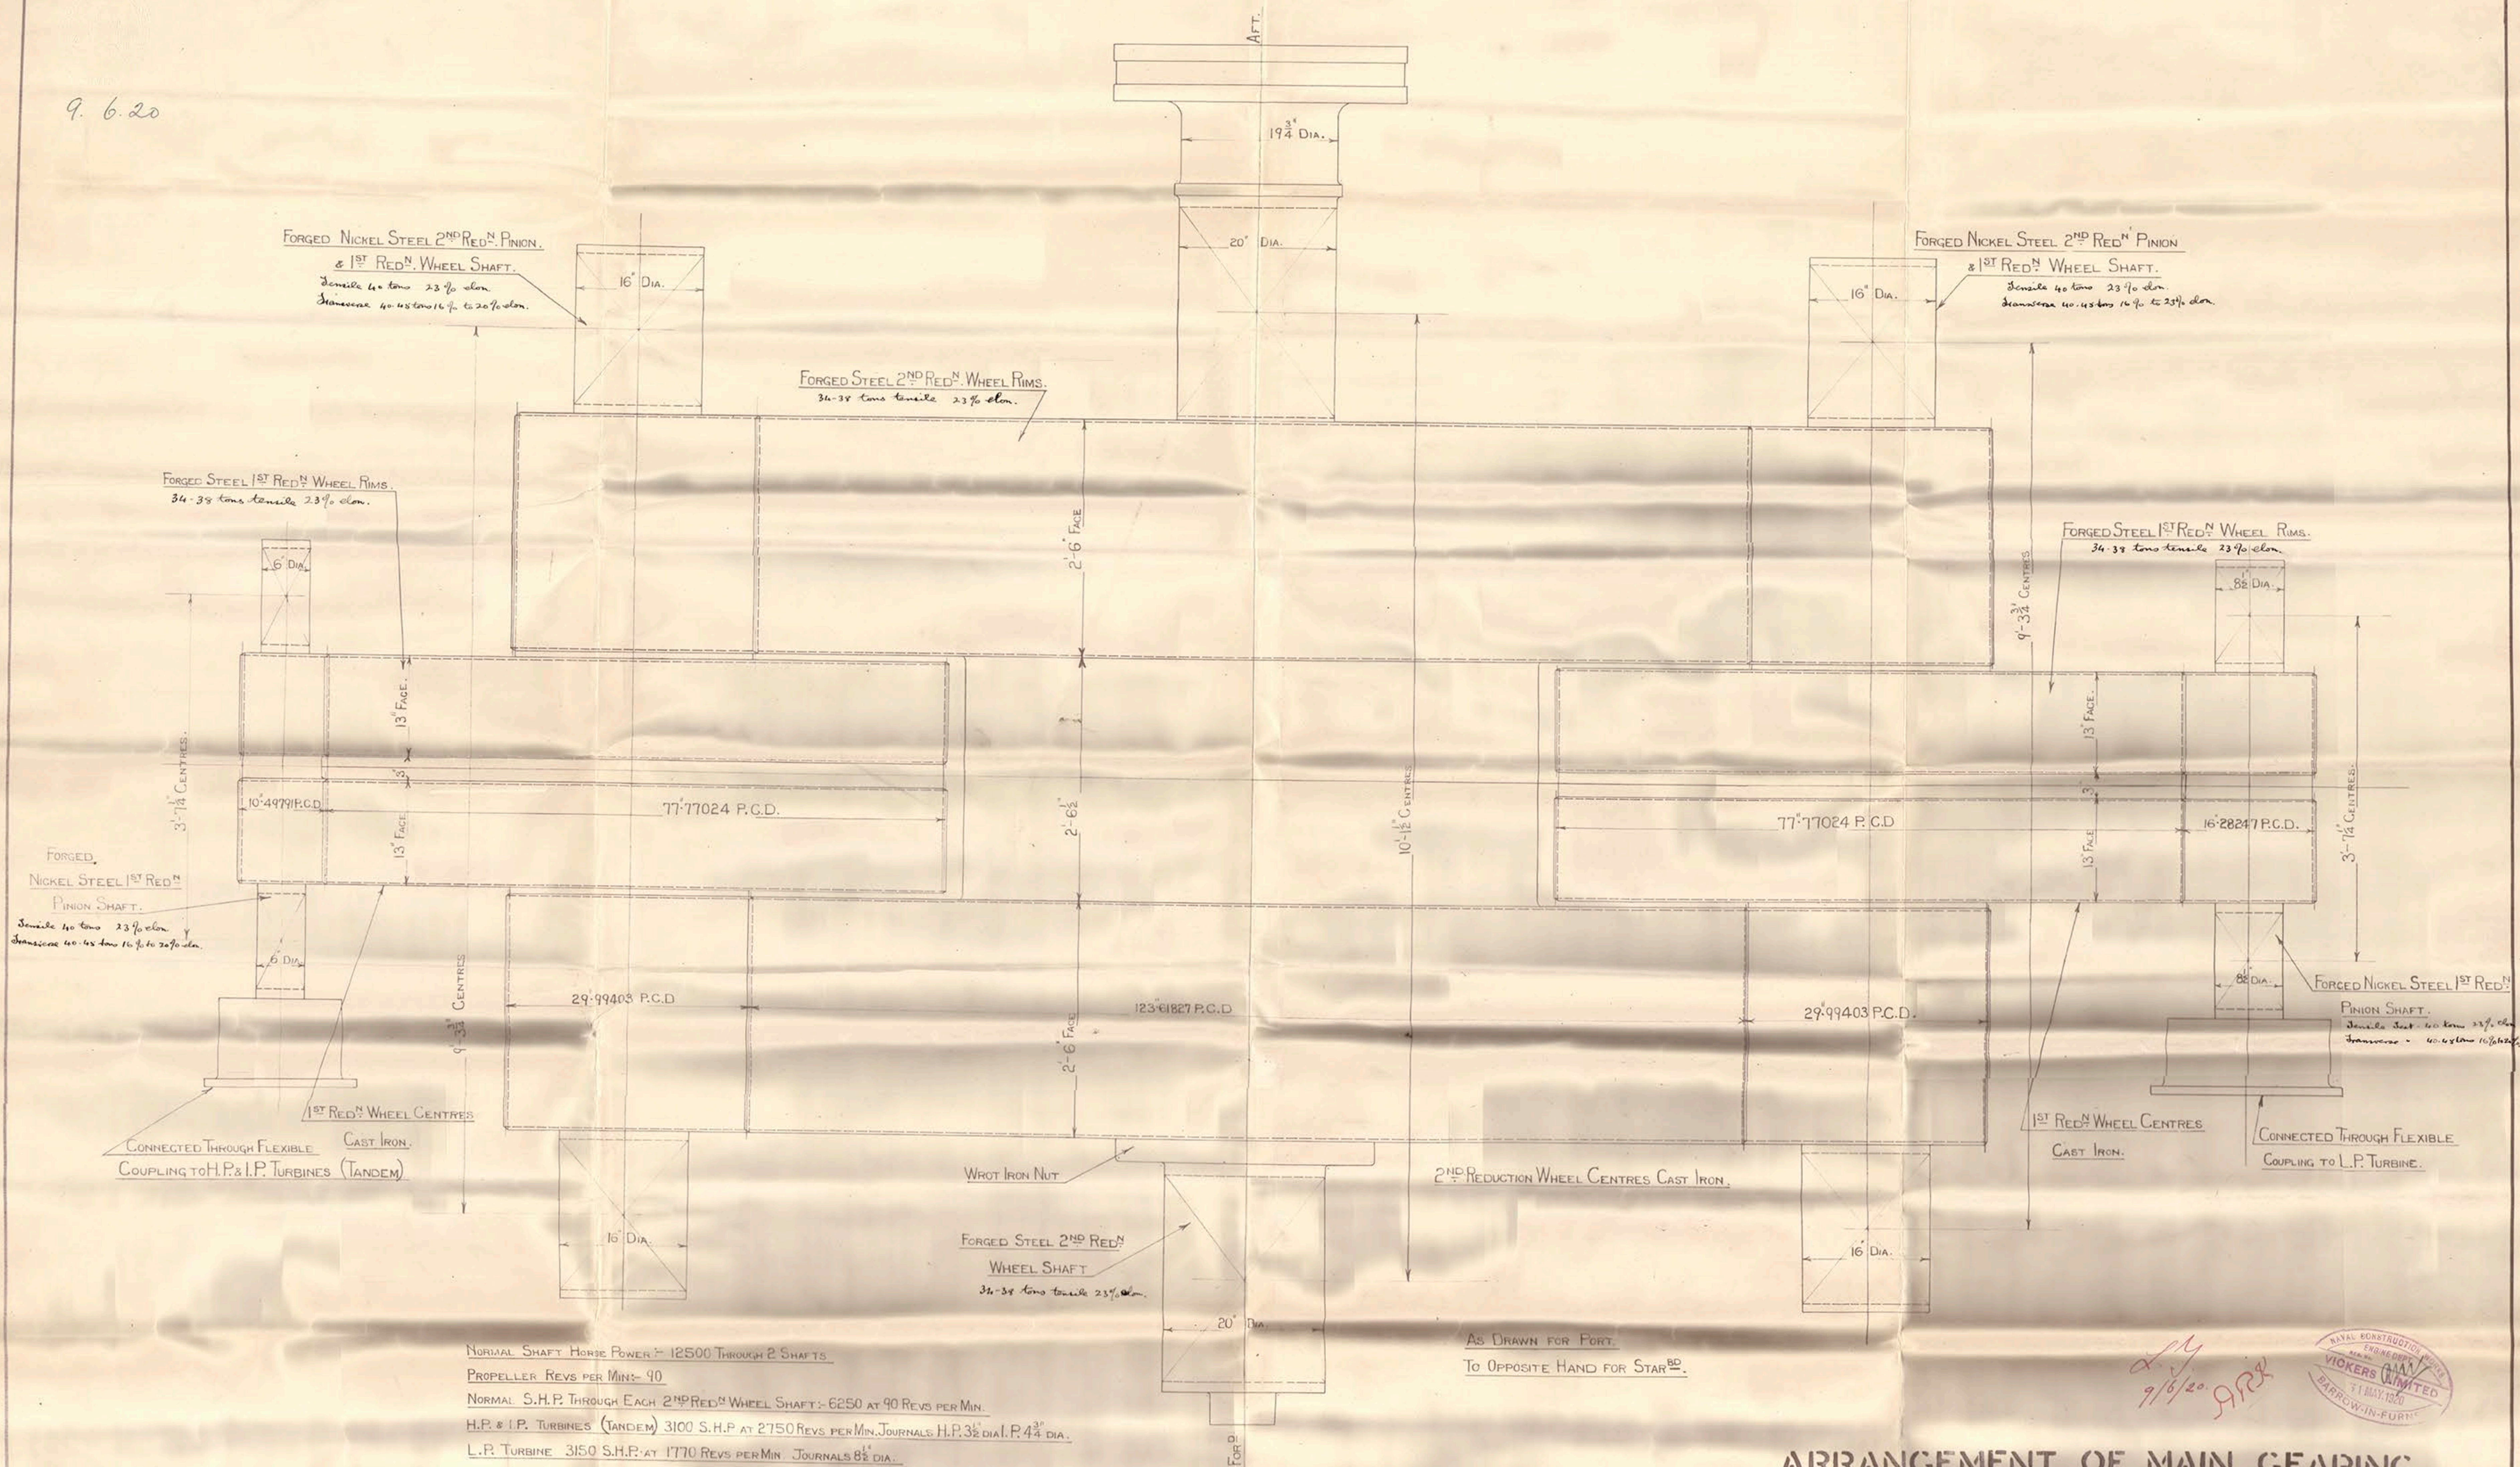

DRAWING NO 586/9 A.G.S.

SUBMISSION DRAWING.

ARRANGEMENT OF MAIN GEARING.

SCALE: 1 1/2" = 1 FT.

Vickers Ltd. Eng No 586.

— " —
Main Gearing ✓

— " —
T.S.S. CARINTHIA

Bow 1st Entry Report No
2147

RETAIN

RETAIN



© 2018

Lloyd's Register
Foundation

LR-TAF-T326-P-12