


COCHRAN PATENT VERTICAL MULTITUBULAR BOILER

HORIZONTAL FLUE TUBES.

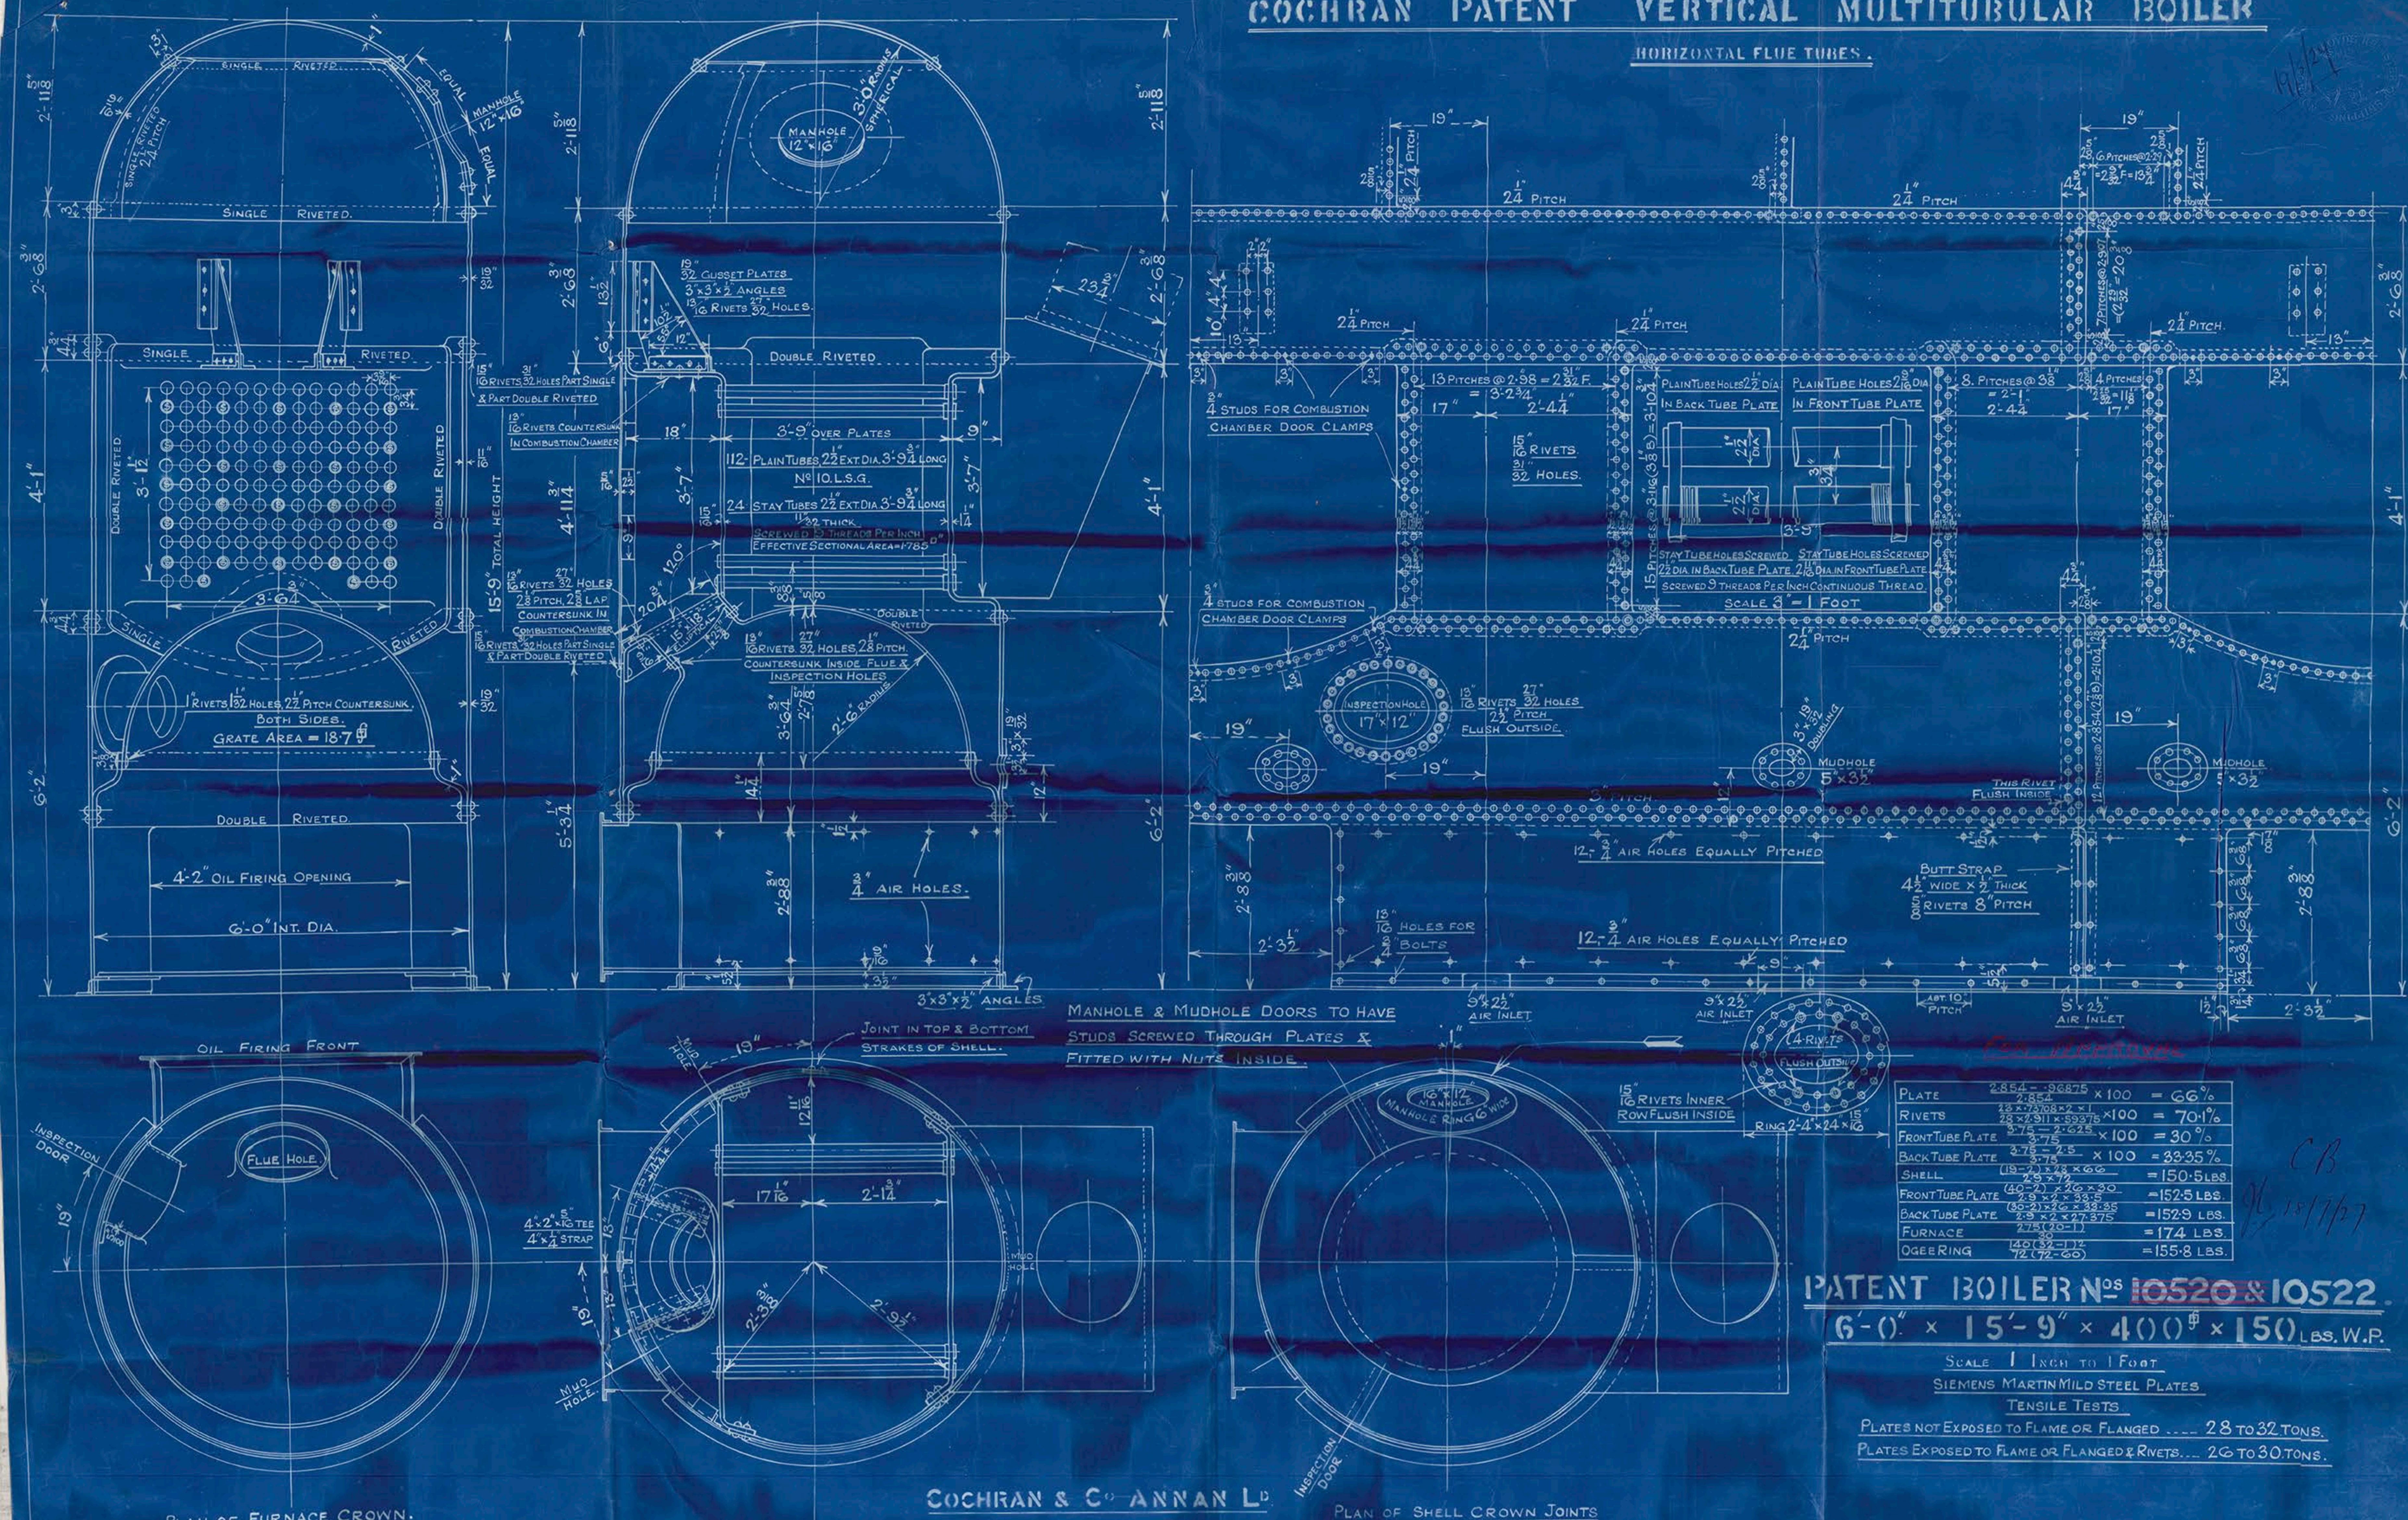

PATENT BOILER NOS 10520 & 10522.

6'-0" x 15'-9" x 4'0" x 150 LBS. W.P.

SCALE 1 INCH TO 1 FOOT

SIEMENS MARTIN MILD STEEL PLATES

TENSILE TESTS

PLATES NOT EXPOSED TO FLAME OR FLANGED ---- 28 TO 32 TONS.

PLATES EXPOSED TO FLAME OR FLANGED & RIVETS... 26 TO 30 TONS.

SURVEY:- LLOYDS & NORWEGIAN BOARD OF TRADE.

DRAWING N° 74

10522
COCHRAN & CO., ANNAN, L.R.

Boiler No. 10522

Drawing No. 15774

W.P. 150 lb^a

S.S. "Belpamela"

NEWCASTLE ON TYNE. - 1028

Report No. 82473.

GLASGOW REPORT No. 47062



© 2018

Lloyd's Register
Foundation

LR-FAC-TB26-P-19