




LLOYDS NUMERALS

L x D	=	8410
L (B x D)	=	23650
D	=	10.7

# SHIP No. 578. PROFILE & DECK PLANS.

DIMS. 305'-0" B.P. x 50'-0" B.MLO x 28'-6" D.MLO. TO UPPER DECK  
TO CLASS LLOYDS 100.A.1. (CARRIAGE OF PETROLEUM IN BULK.)

SCALE  $\frac{1}{8}" = 1'-0"$

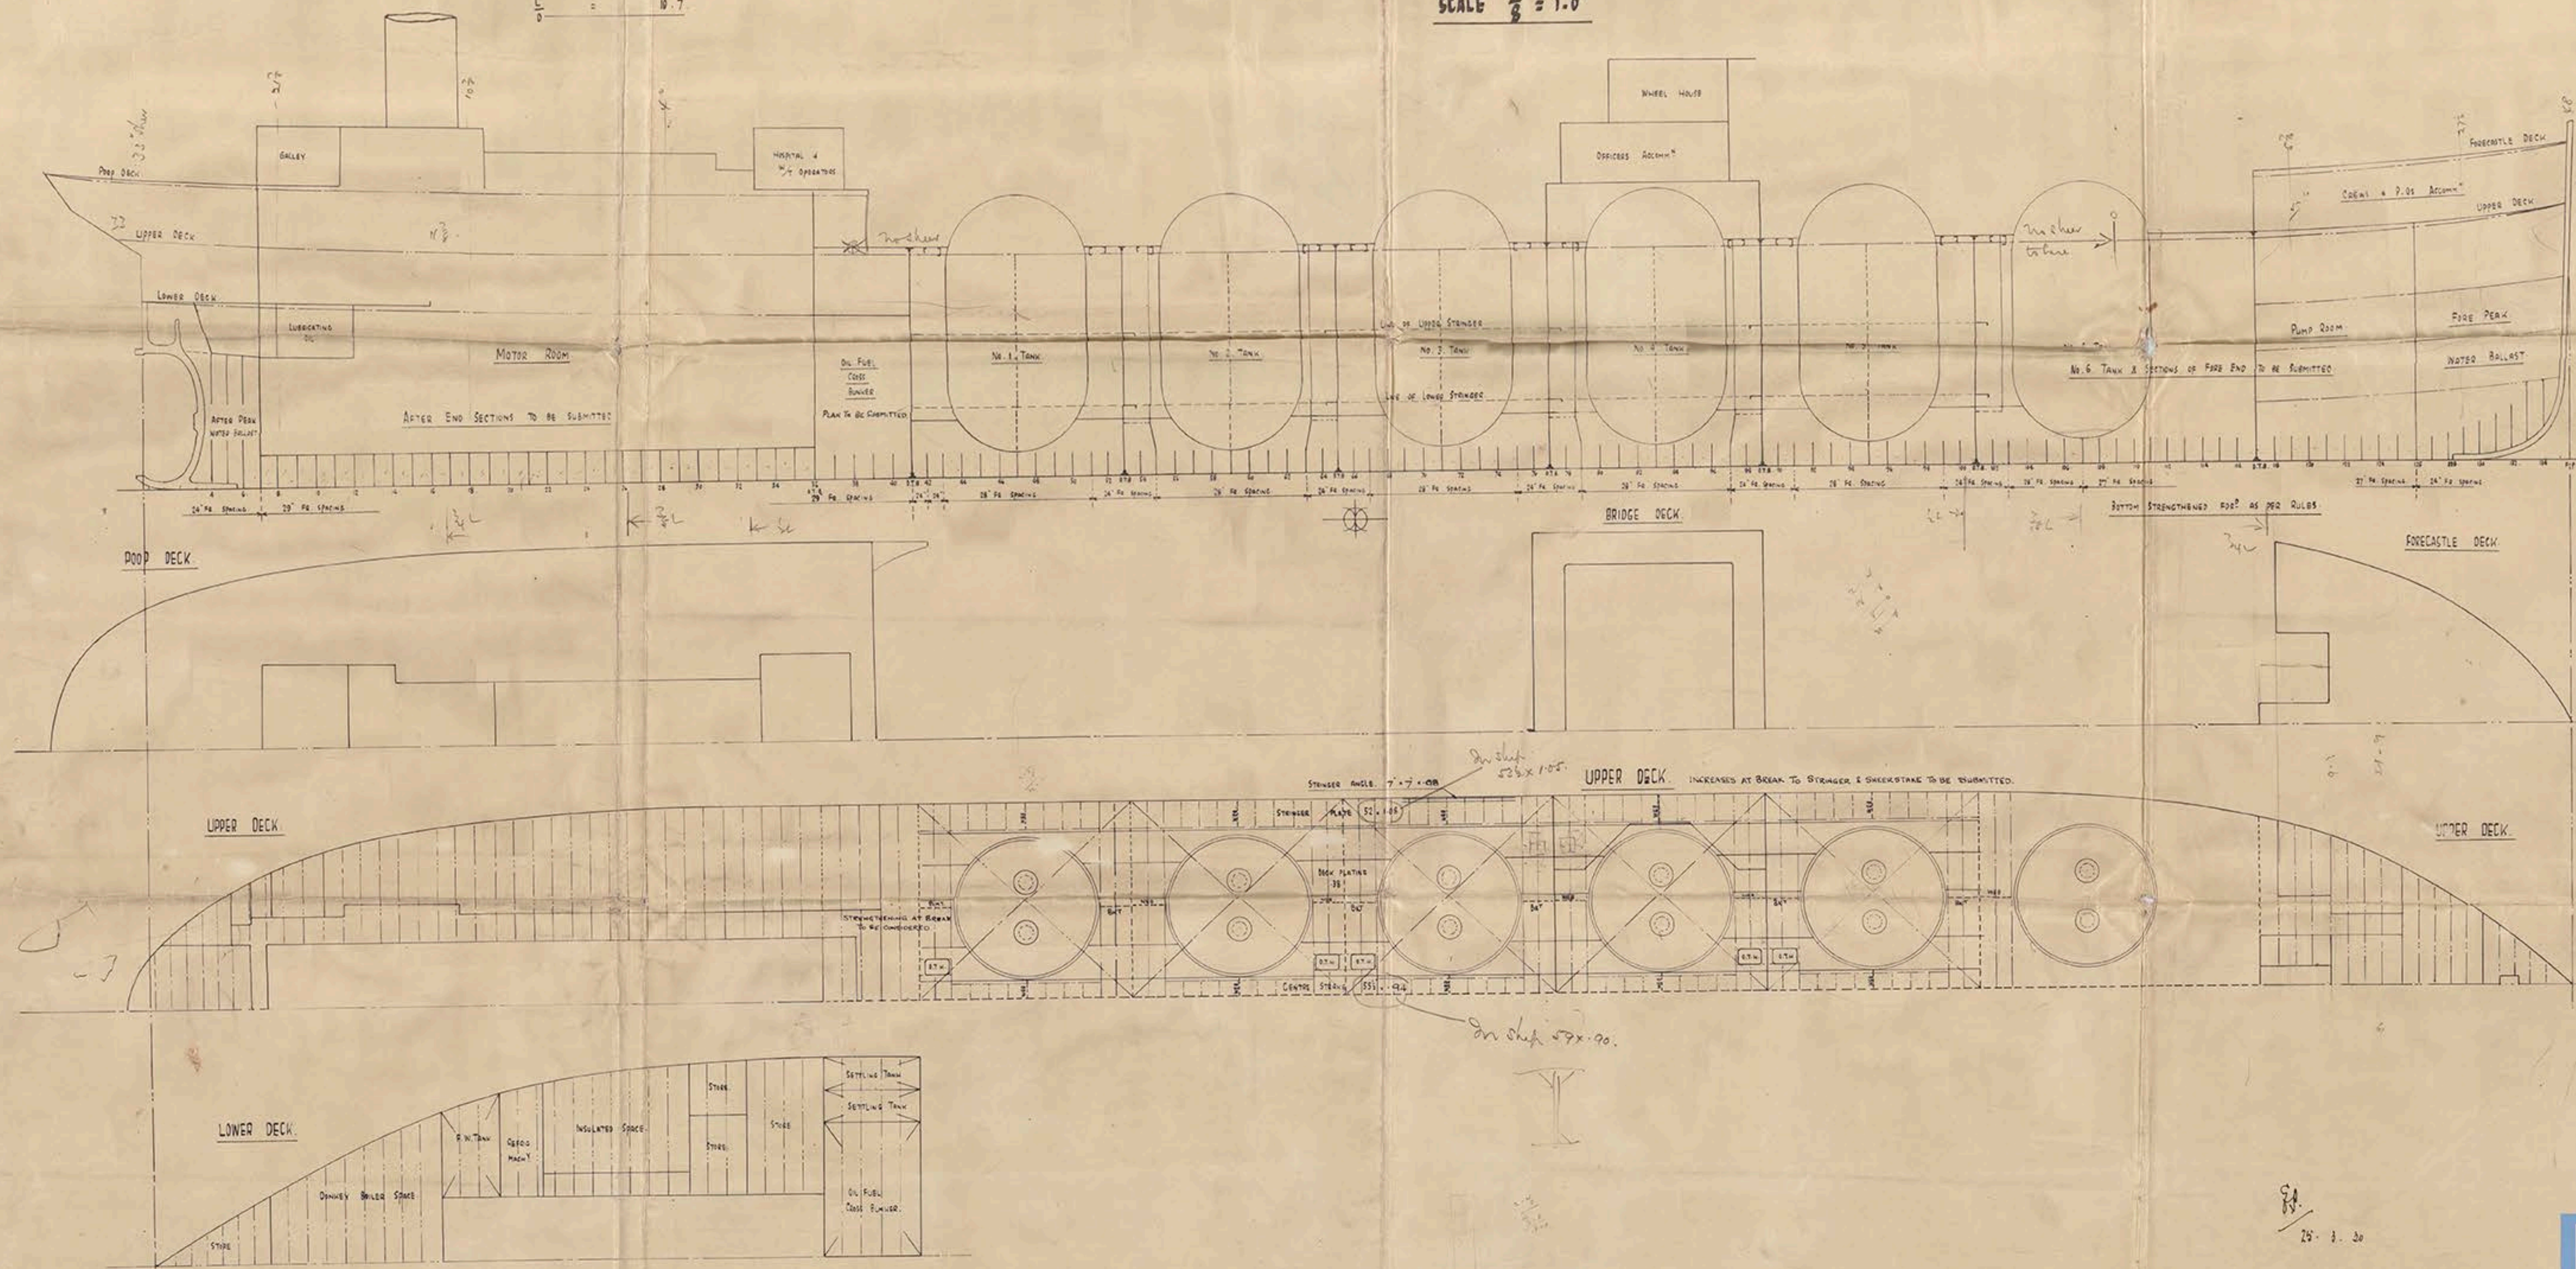

24  
25-1-30



1084  
Hawthorn Leslie  
Nº 578  
Profile + Deck

SS. "AGHITA"

NEWCASTLE ON TYNE.

Report No. 86945



© 2018

Lloyd's Register  
Foundation

LK-TAF-7822-P-5