
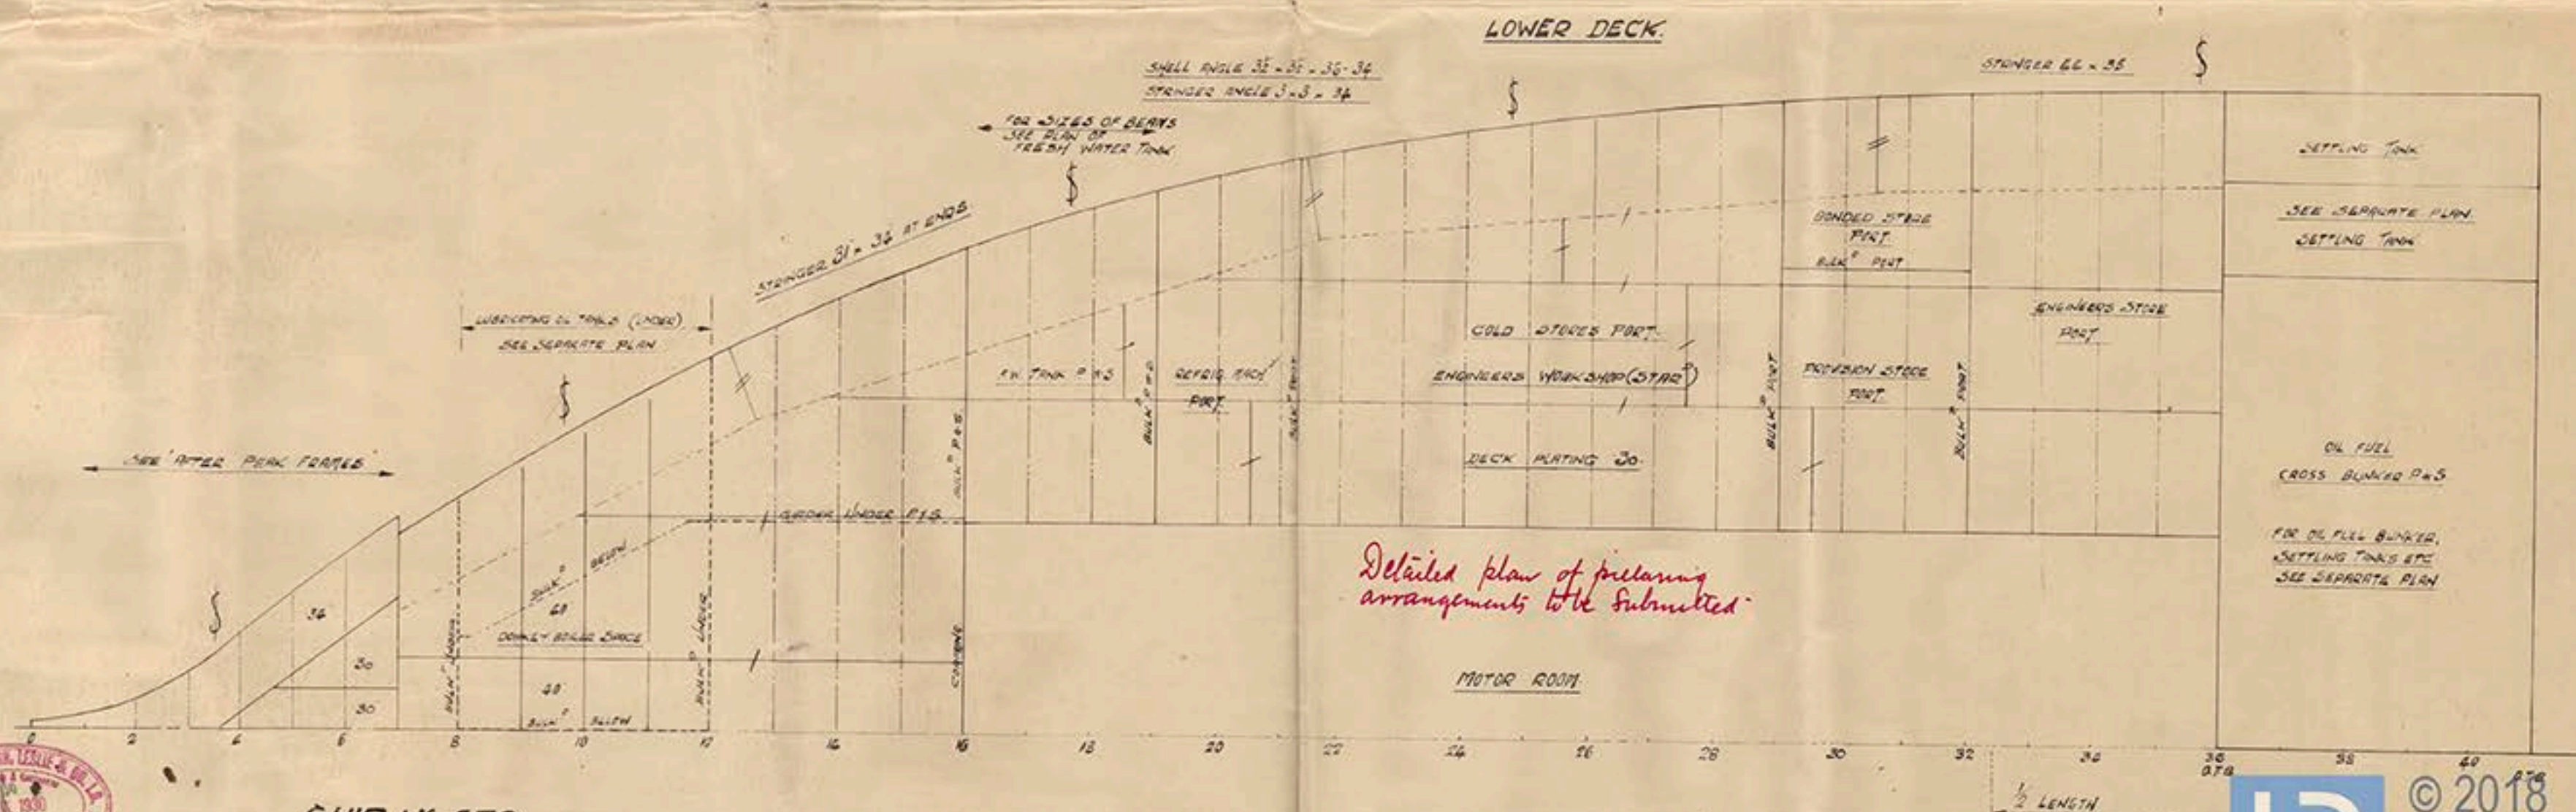
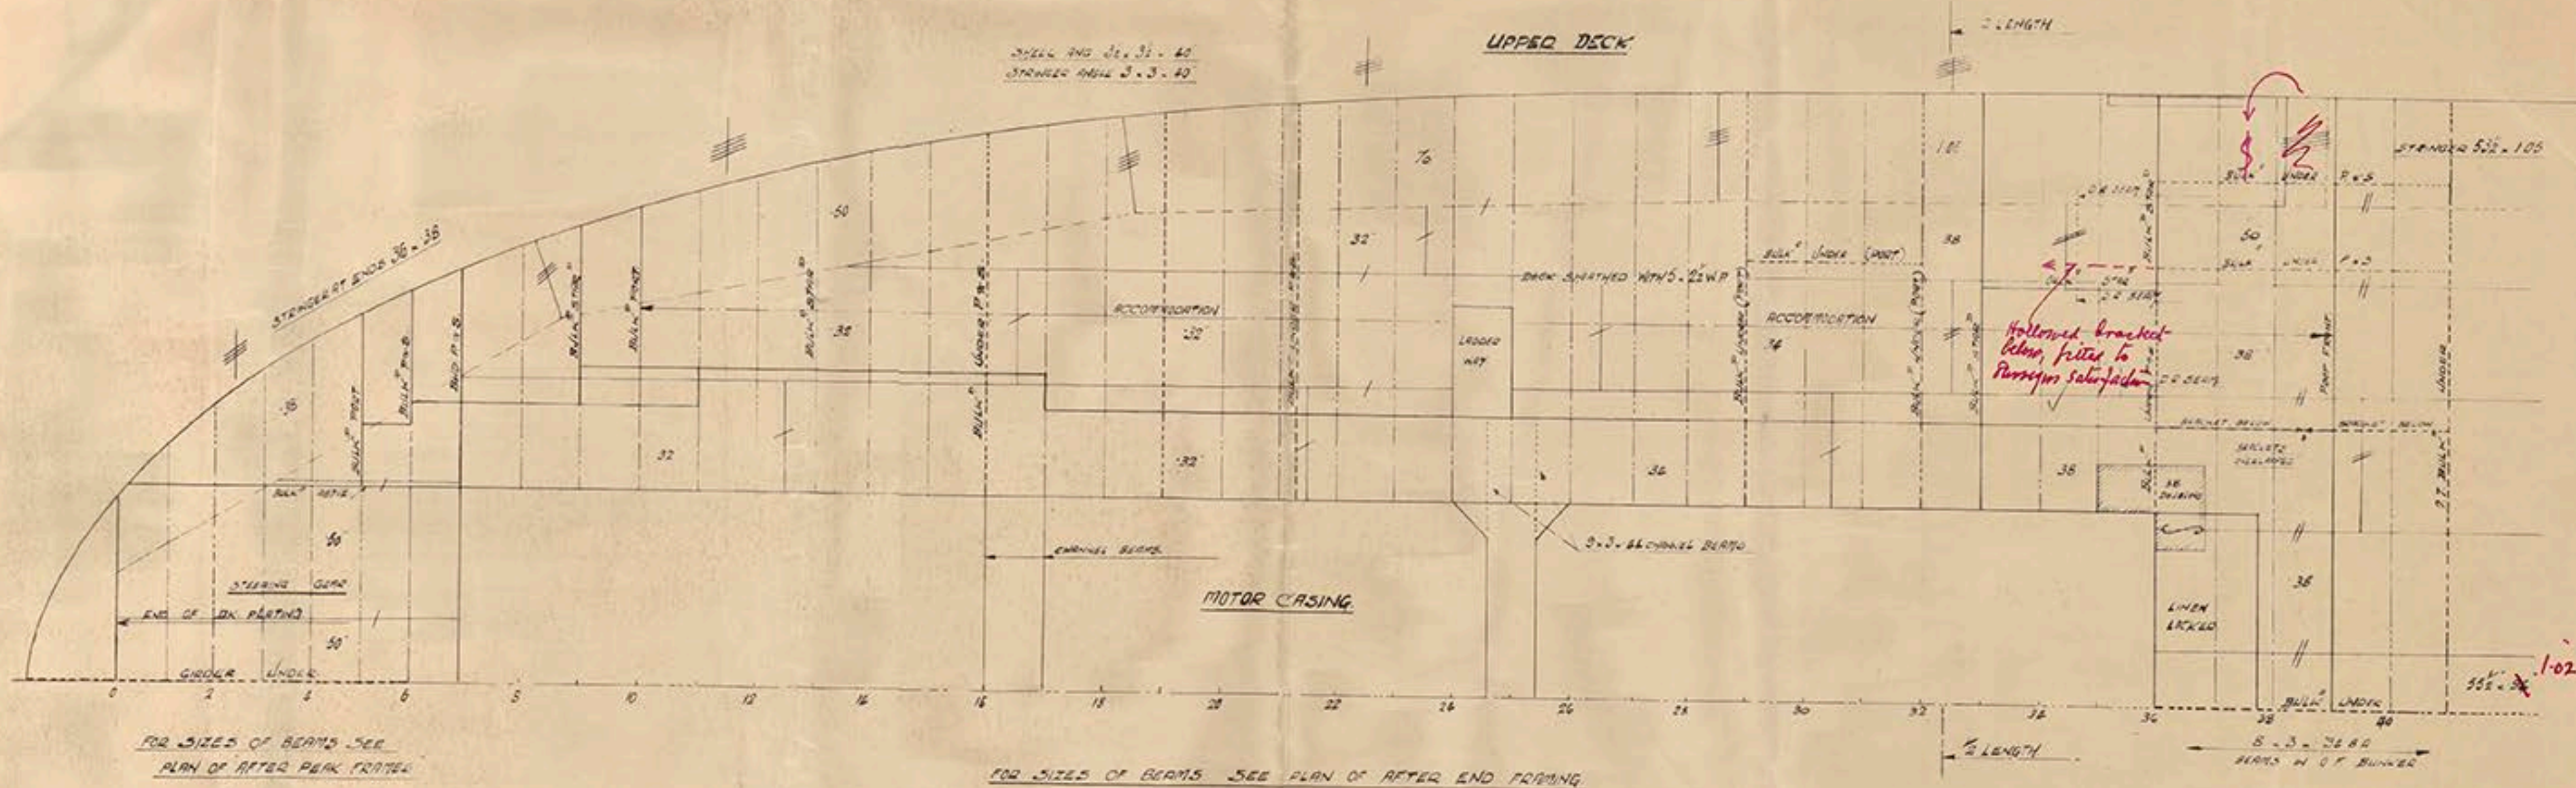


POOP DECK.

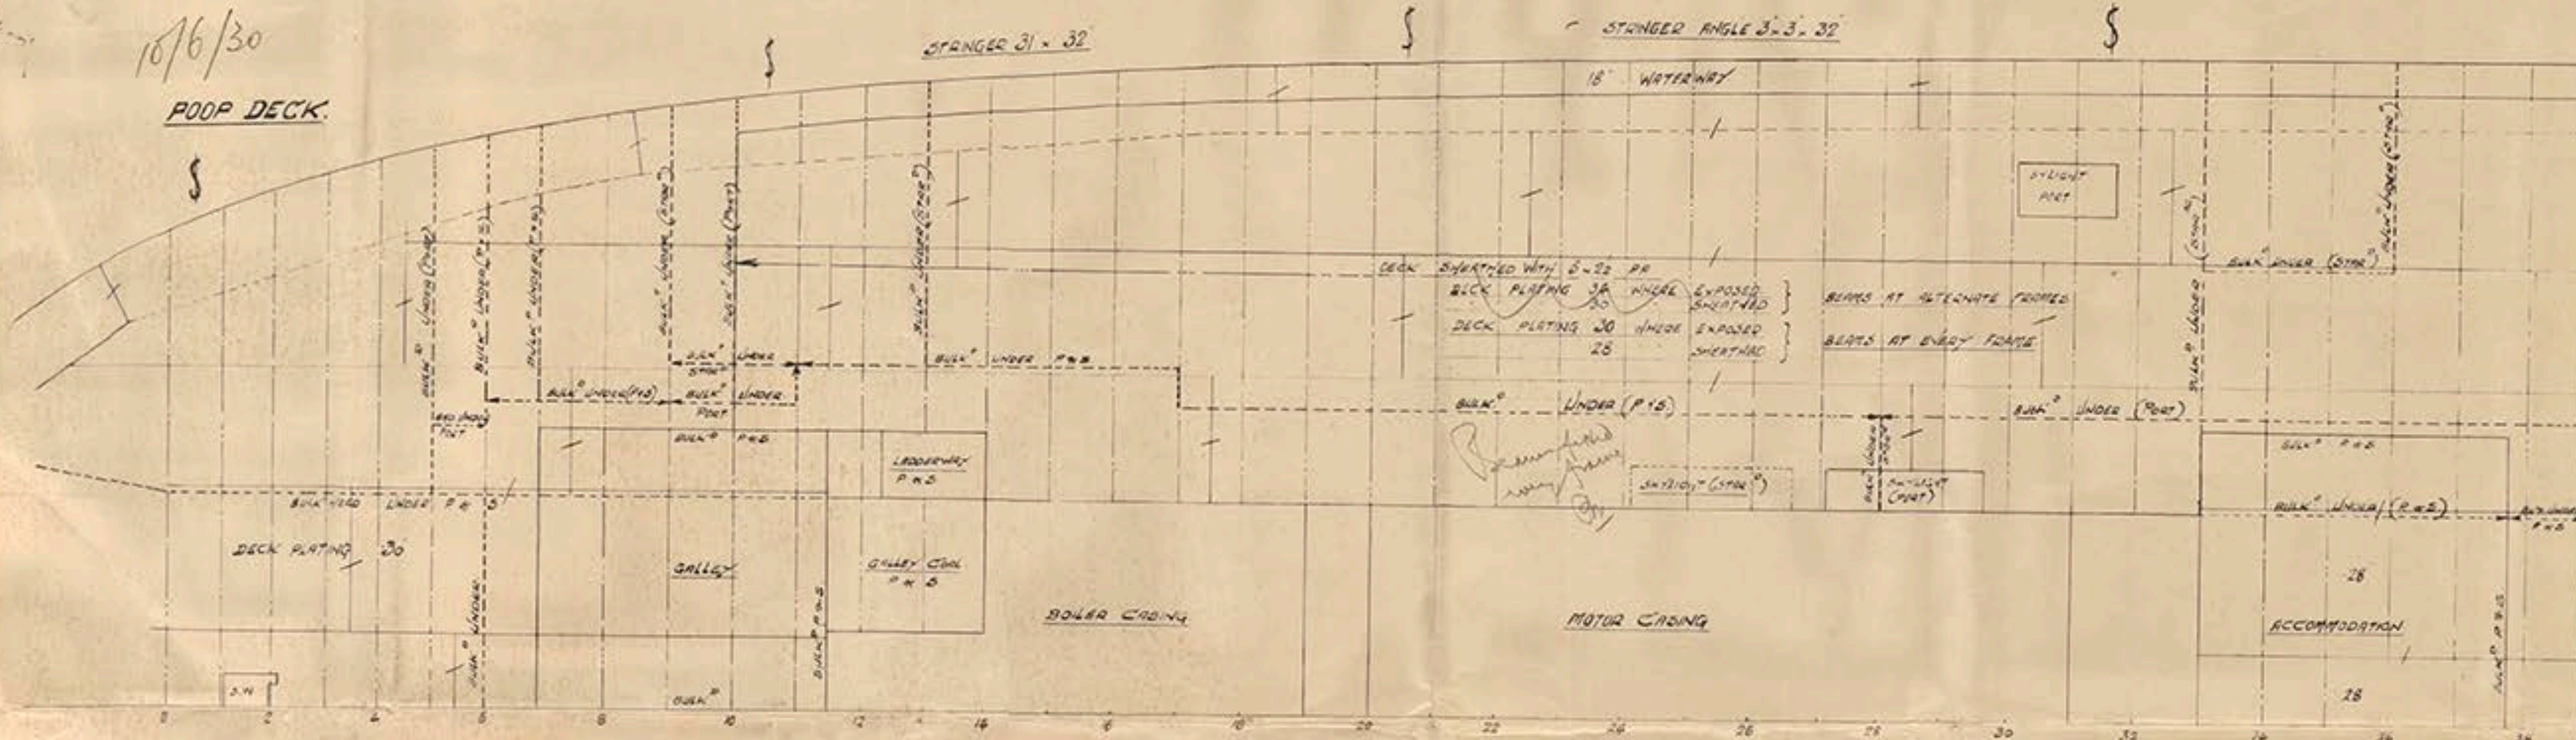

SHIP N° 578.

SCANTLINGS OF DECKS AT AFT END.

SCALE $\frac{1}{4}'' = 1'-0''$



© 2018

Lloyd's Register
Foundation

30.

578.

DECKS. AFT (ONLY)

Hawthorn Leslie

S.S. 'AGHITA'

NEWCASTLE ON TYNE.

Report No. 86908



© 2018

Lloyd's Register
Foundation