




POOP DECK.

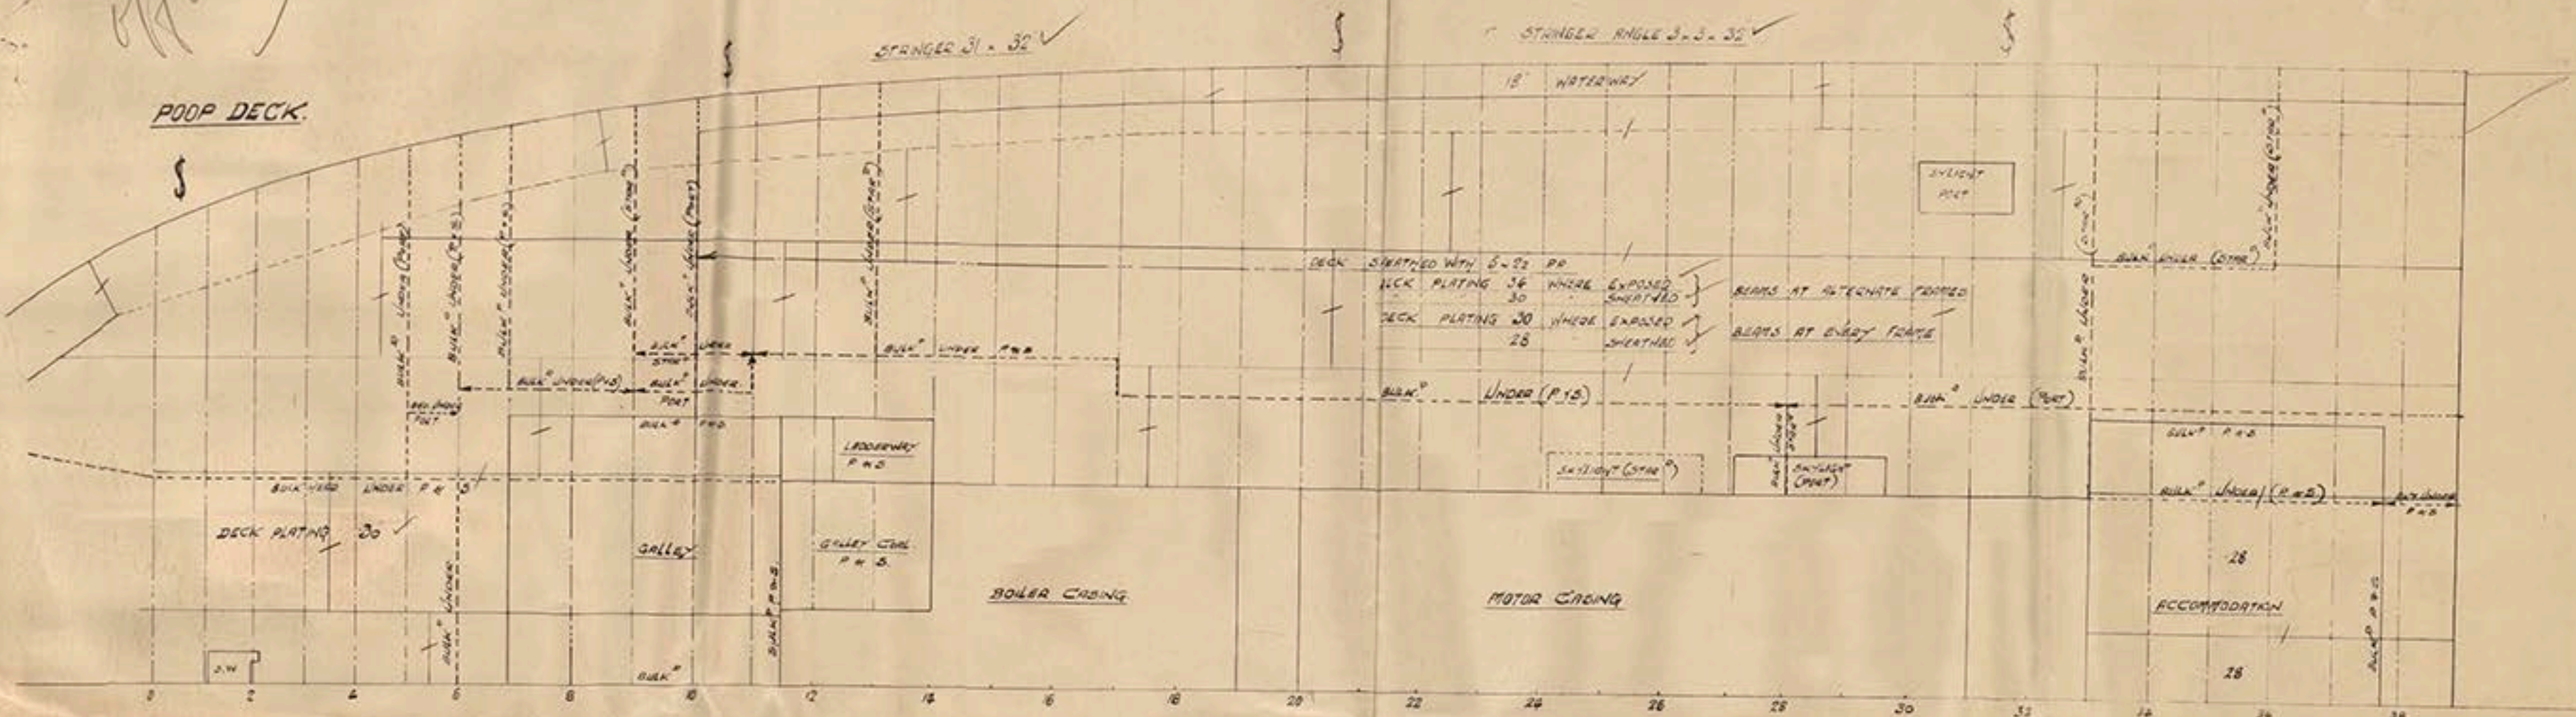

UPPER DECK

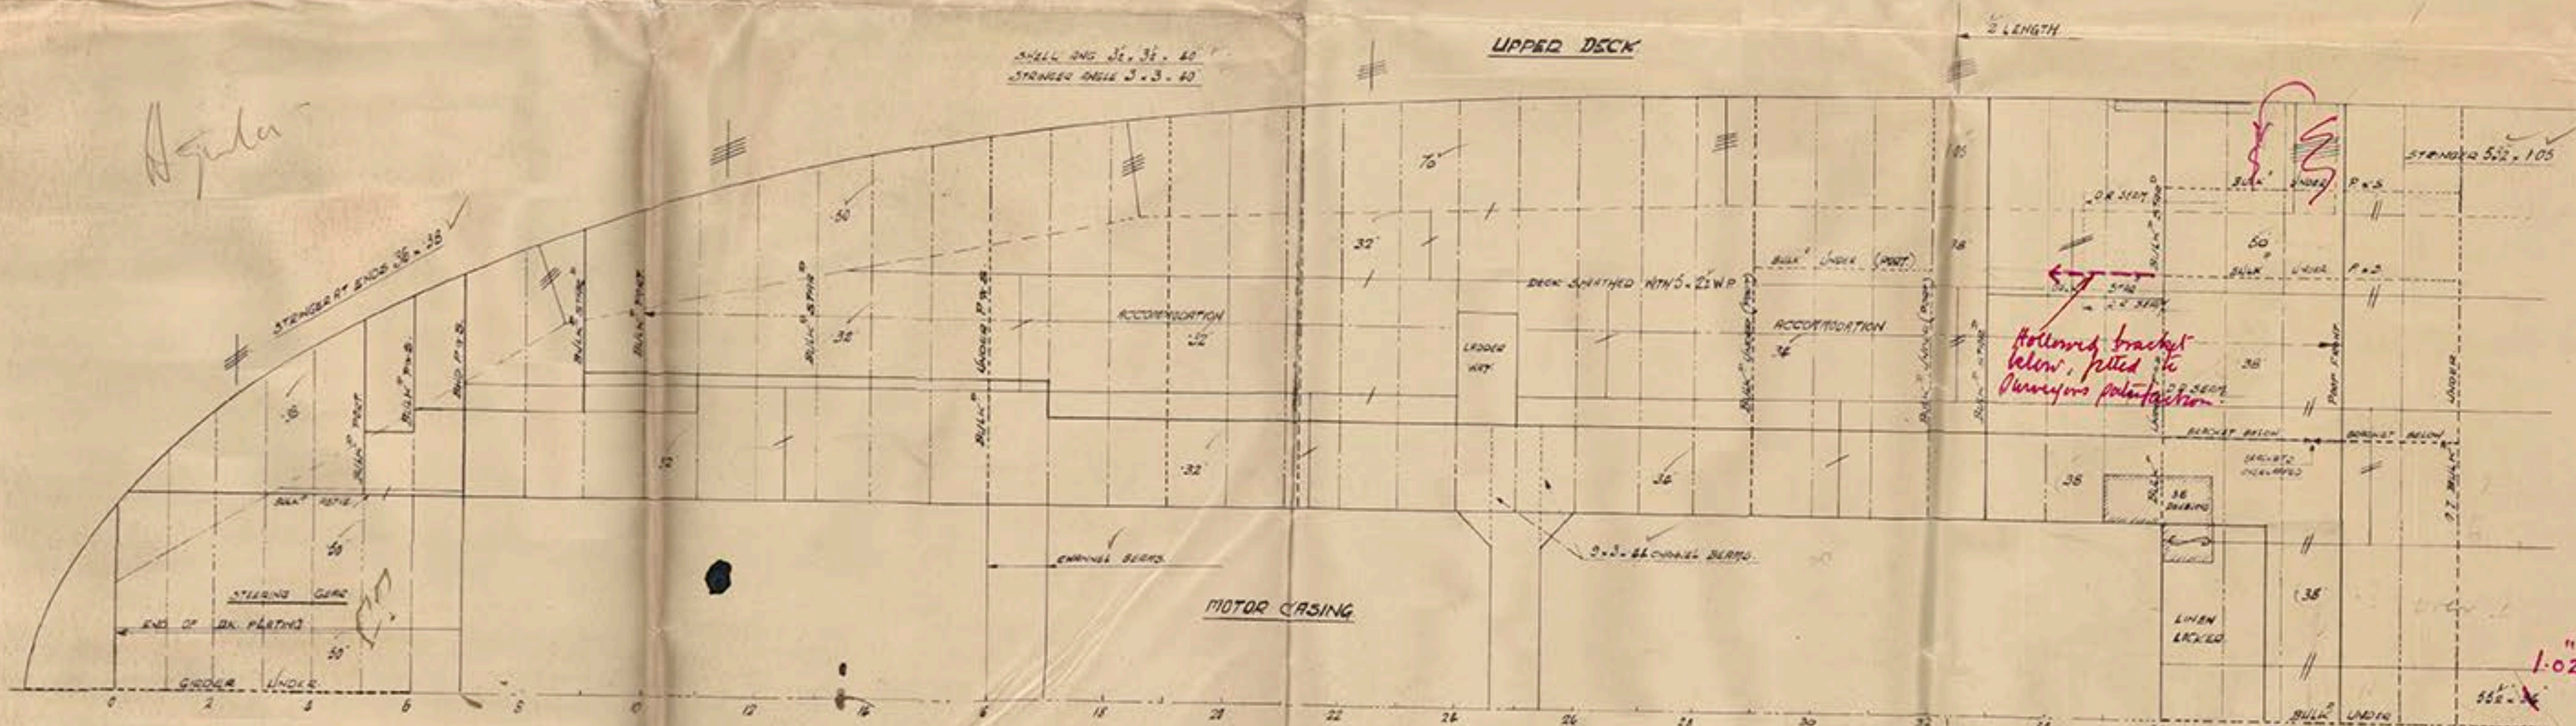

LOWER DECK

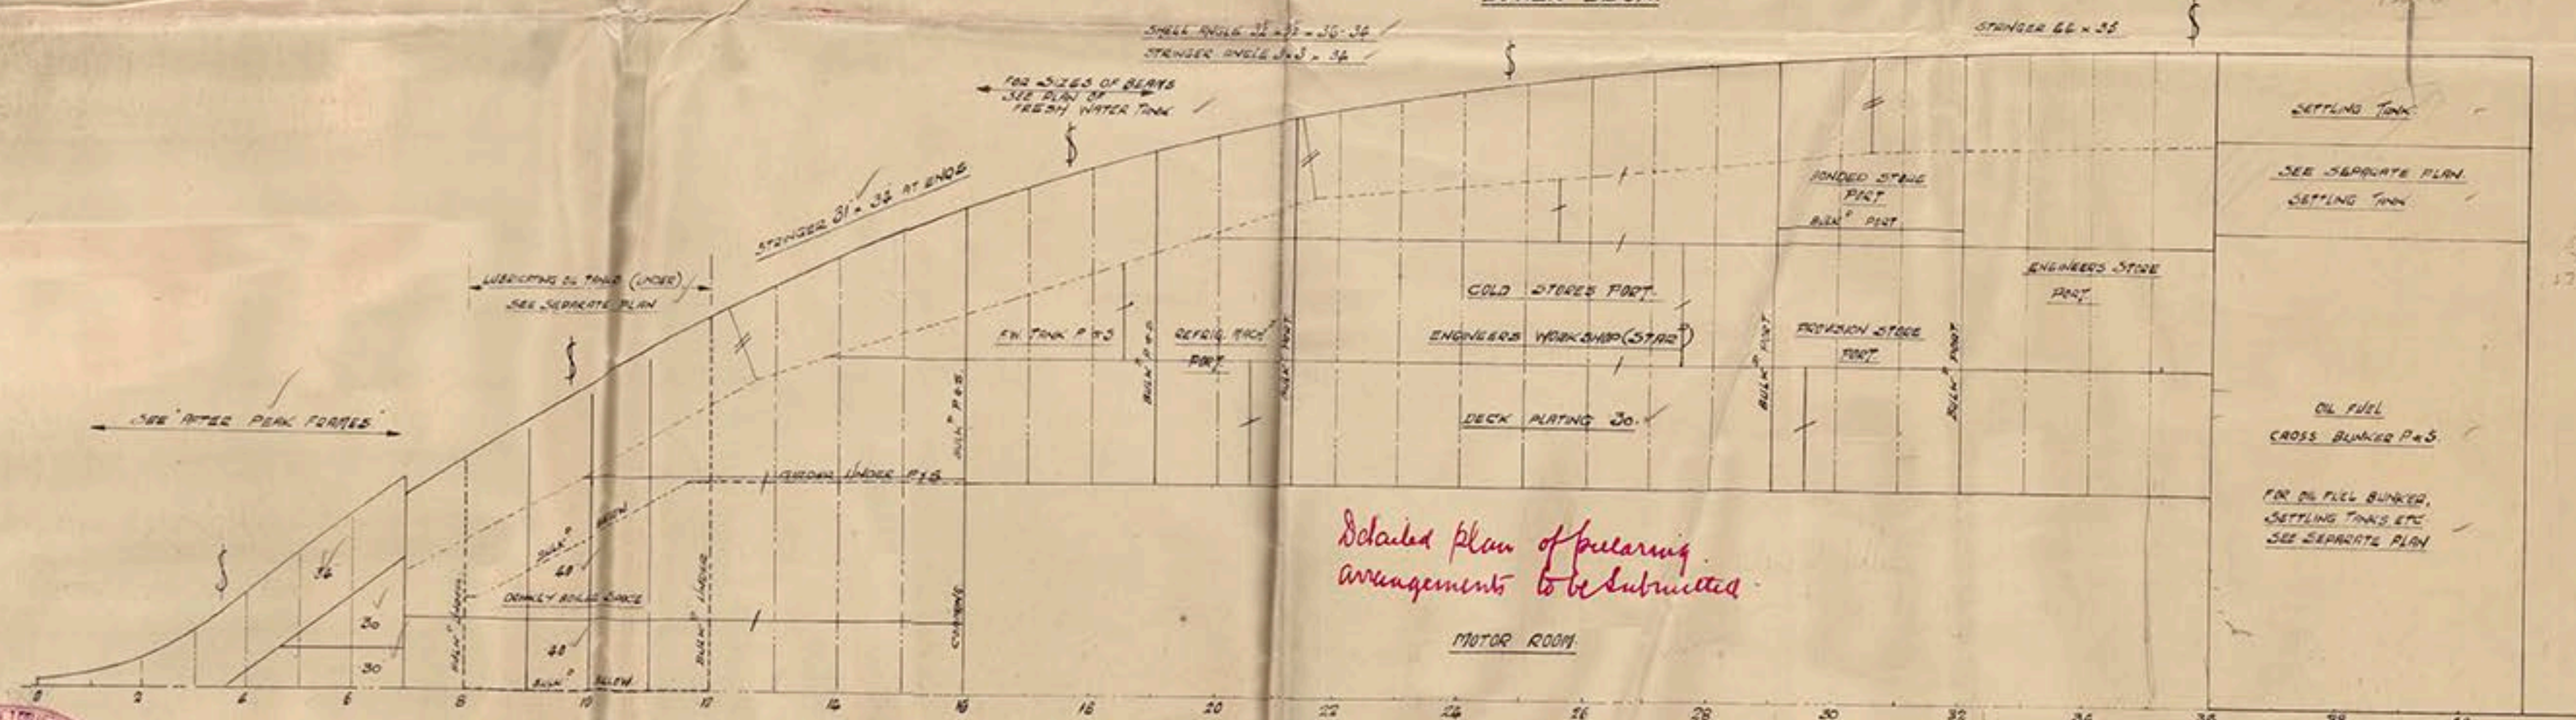

SHIP NO 578.

GEN. BOX NO 338

SCANTLINGS OF DECKS AT AFT END.

SCALE 1/4" = 1'-0"



© 2018
Lloyd's Register
Foundation

"Aquila"

Scantlings of Deck at After End.

Nwa 86948.



© 2018

Lloyd's Register
Foundation

LR-FAF-TB28-P9