

Sp Silurian

Received at *Middlesbrough Office* 17th August 1898

Lloyd's Register of British and Foreign Shipping.

(Report on Vessel No. *2414* Port *Middlesbro'*)

The words FORGINGS or CASTINGS, IRON or STEEL, should be struck out as may be required.

No. *4309* SHIP FORGINGS ~~OR CASTINGS~~.

I have to report that the undermentioned Iron or Steel Forgings ~~or Castings~~, manufactured by *The Blaydon Forge Co* of *Blaydon* for the Vessel No. *145*, being built by *Messrs R Cross sons* of *Middlesbro* have been inspected by me as set forth below, and found to be, so far as can be seen, *sound*



Mark on Forgings.

Lloyd's
No. *7678B*
JB

John B Craig
Newcastle

	STERN FRAME.	RUDDER FRAME.	STEM.
Material*	<i>Scrap</i>	<i>Scrap</i>	/
How made	<i>Forged</i>	<i>Forged</i>	
Dimensions	<i>7 1/4 - 4 3/4</i>	<i>5 1/4 - 3</i>	
Progress on Inspection	<i>Forged & Smitten</i>	<i>Forged & Smitten</i>	
Date when Inspected	<i>March 9 to April 27/98</i>	<i>May 16 to July 27/98</i>	

SKETCHES OF FRAMES SHOWING POSITION AND DESCRIPTION OF WELDS OF FORGINGS, OR PARTICULARS OF TESTS APPLIED TO CASTINGS.

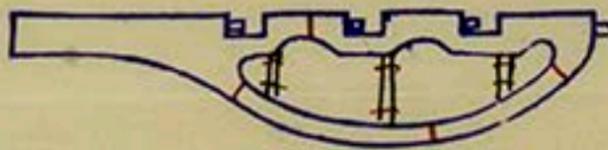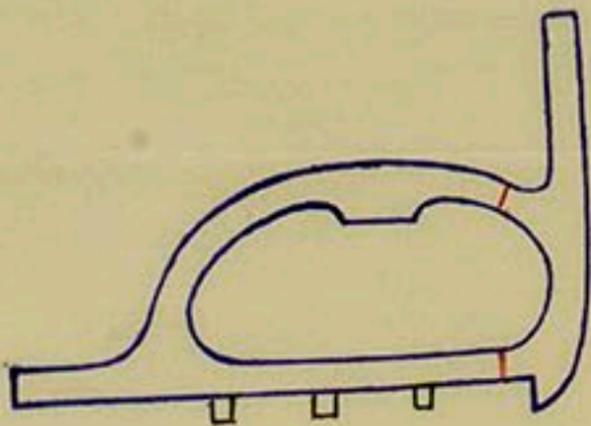

welds

Fee (if any chargeable) £ : :

To be paid at _____

* If of Iron, state whether scrap or puddled Iron.