

"AURIS" *1/4" = 1' scale*

RETAIN


RECORDS DEPT.
LONDON.

78


AURIS ENGS 1260
SCALE $\frac{1}{4}$ " = ONE FOOT

DRAWN BY 11/7-9-52
CHECKED BY 11/7-9-52

AURIS ~ ENGS 1260

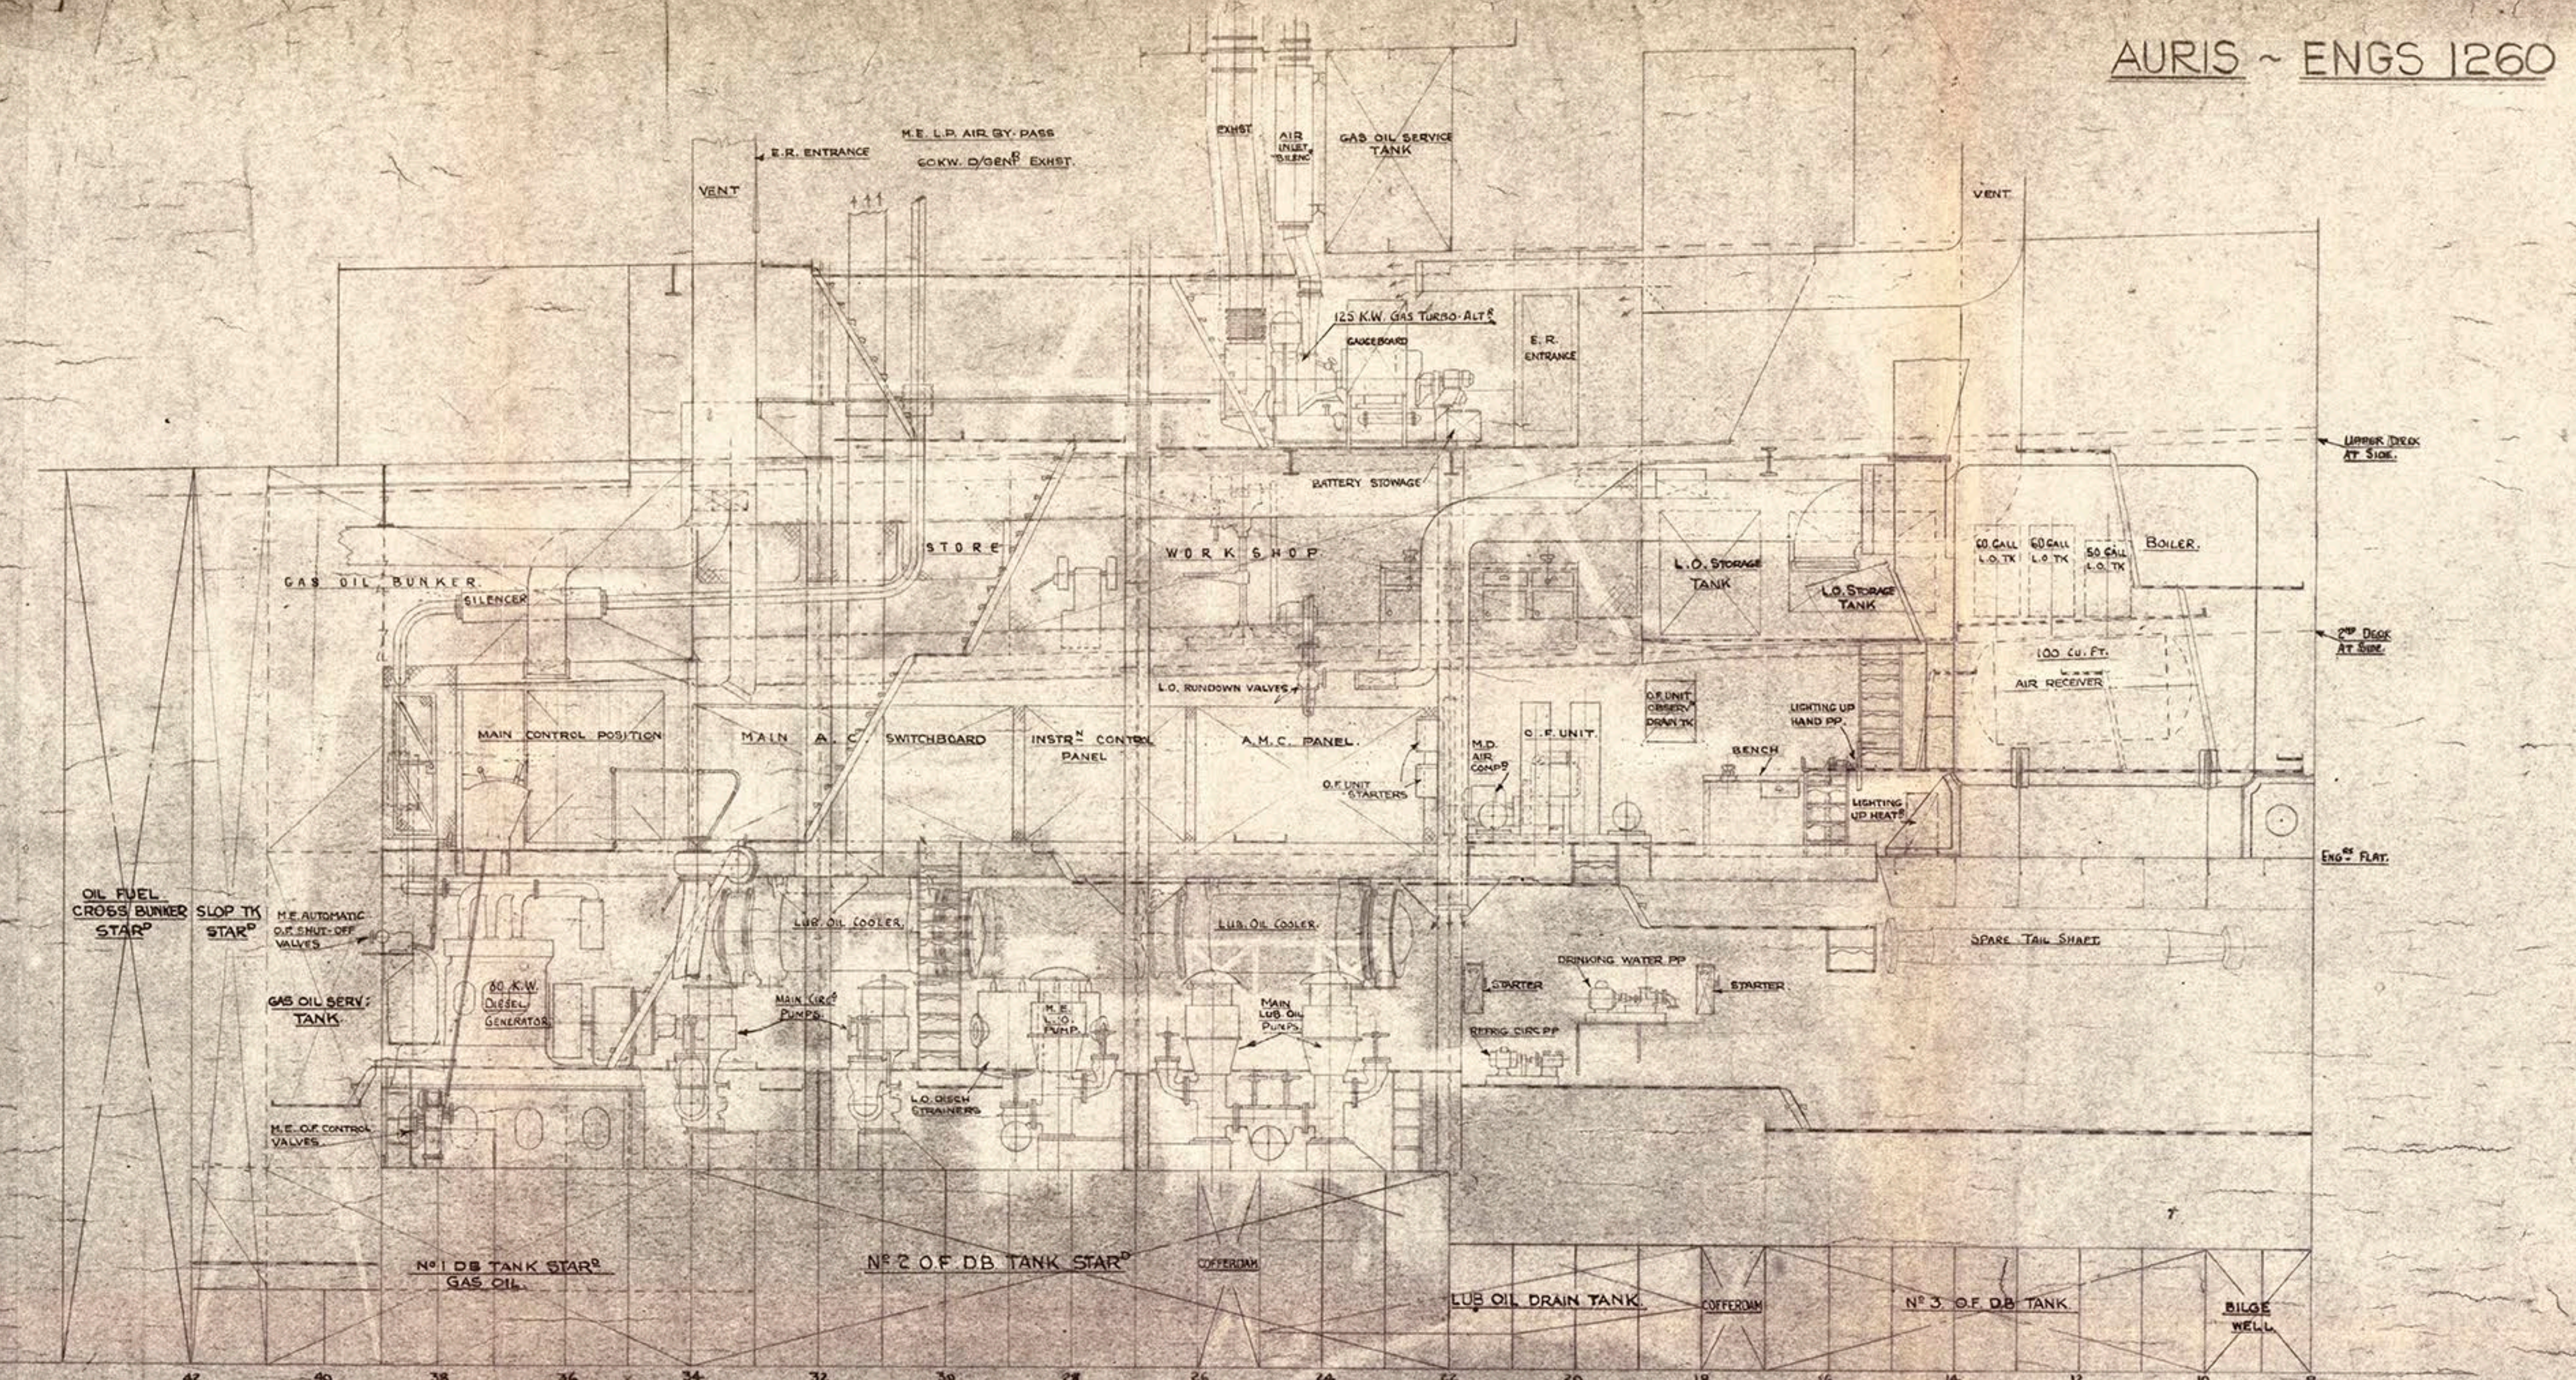

ELEVATION LOOKING TO STARBOARD

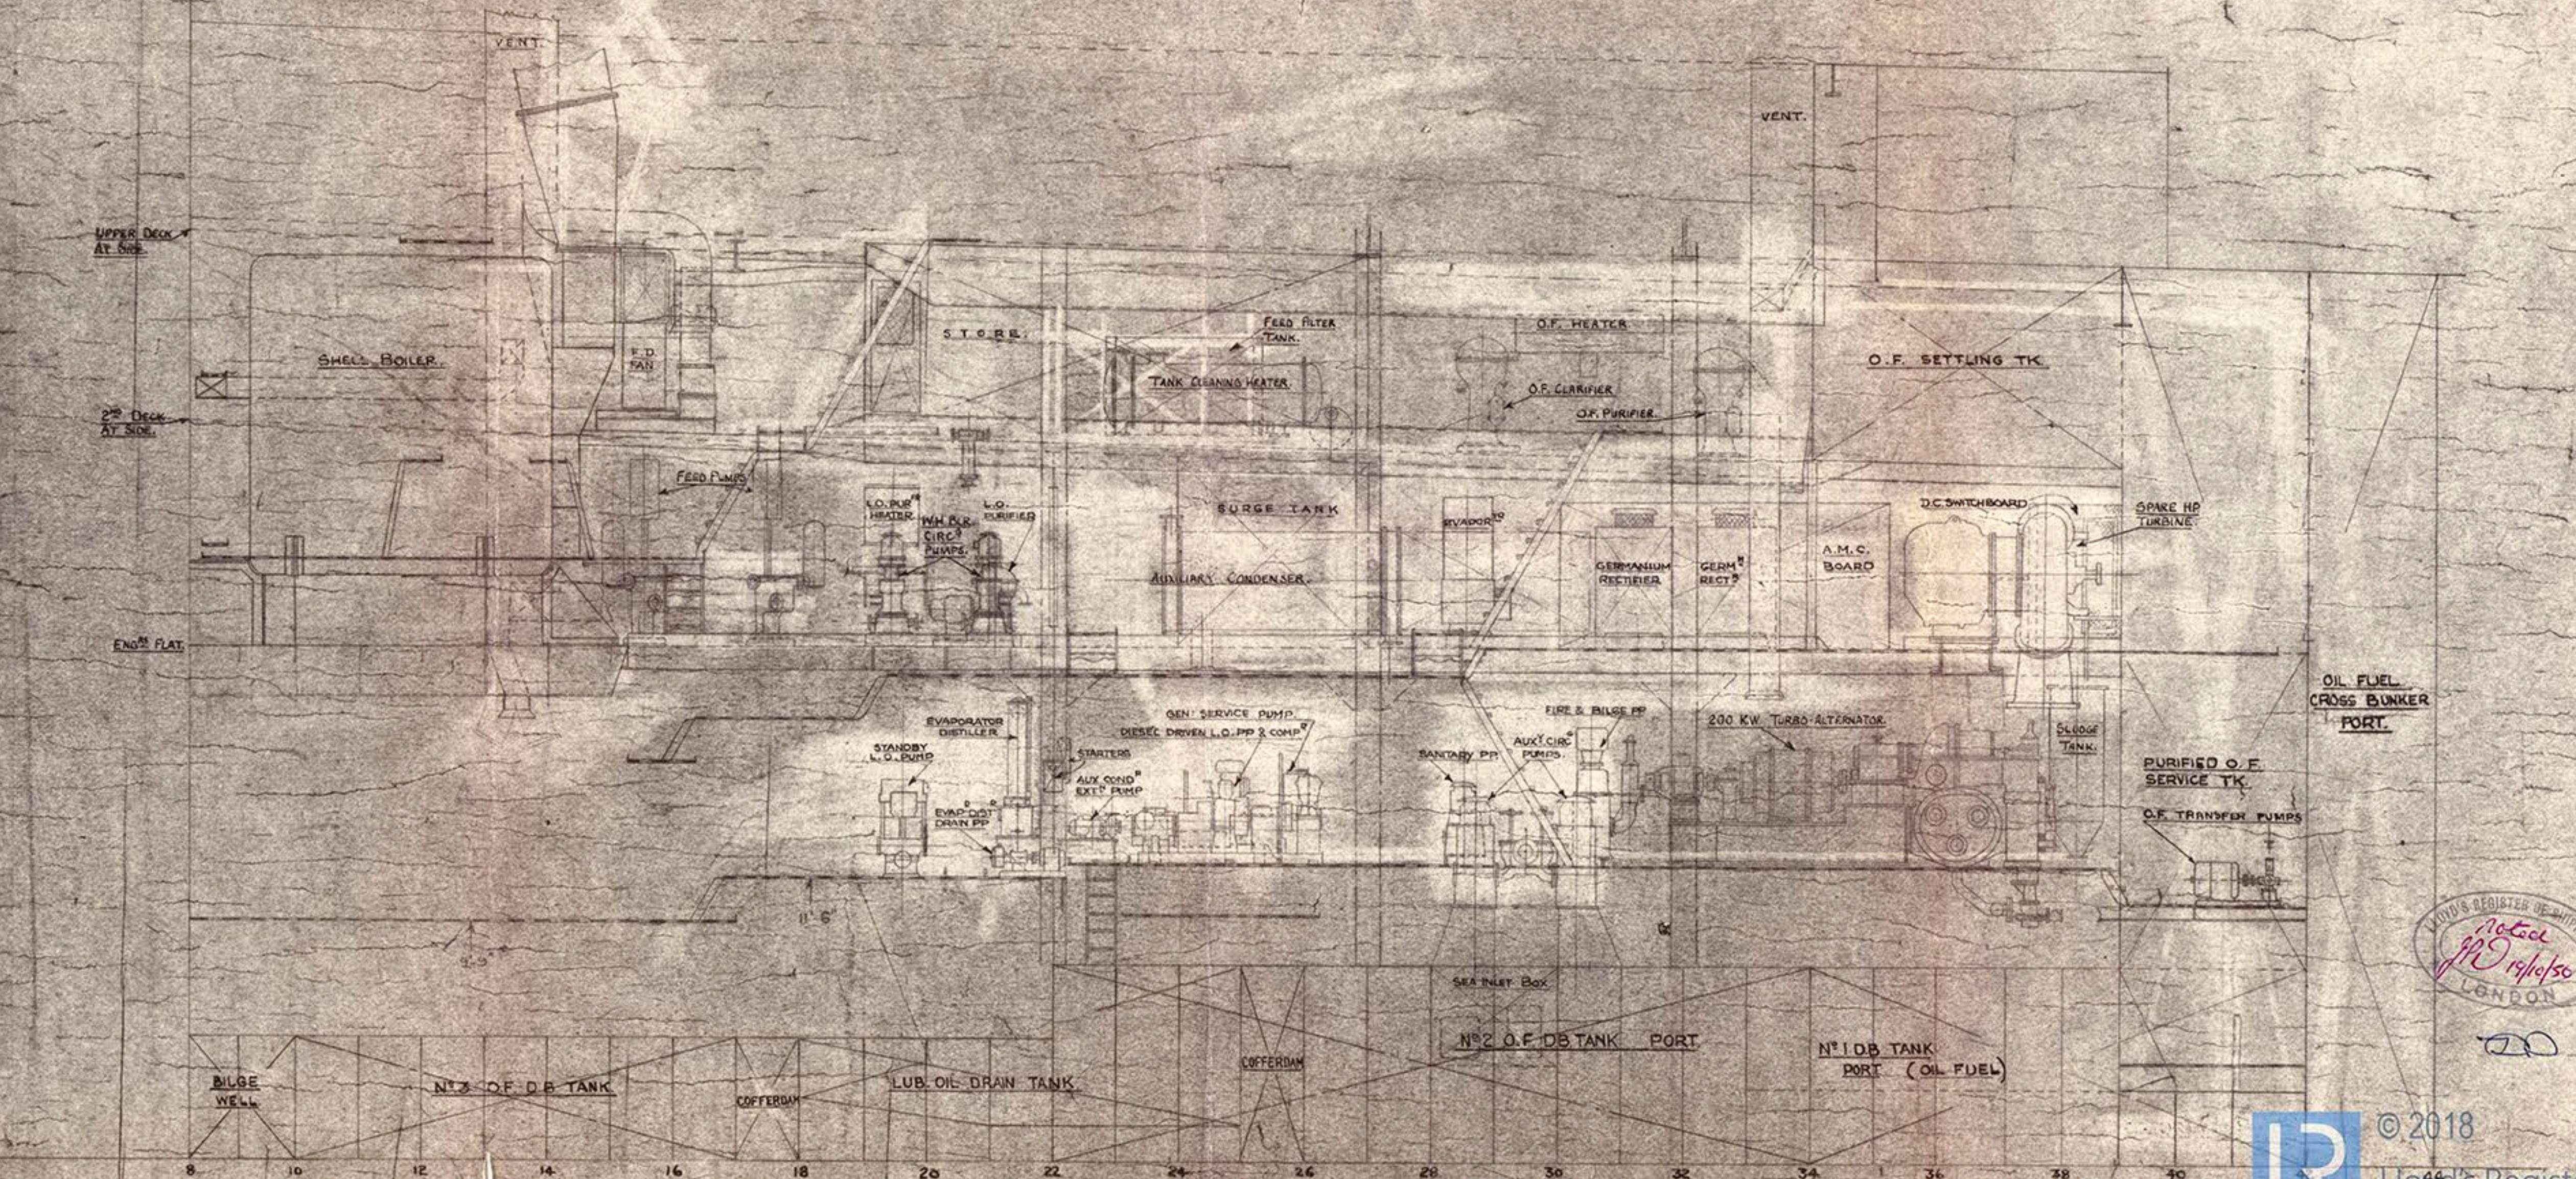

ELEVATION LOOKING TO PORT

NOTED
FOR
REVISION
LONDON