


Amended — MAIN DECK PLAN —

— SHIP N° 386 —

— SHOWING COMPENSATION FOR 1/2 IRON DECK —

— Scale 1/4" = one foot —

Jr. Thomson
12.10.98

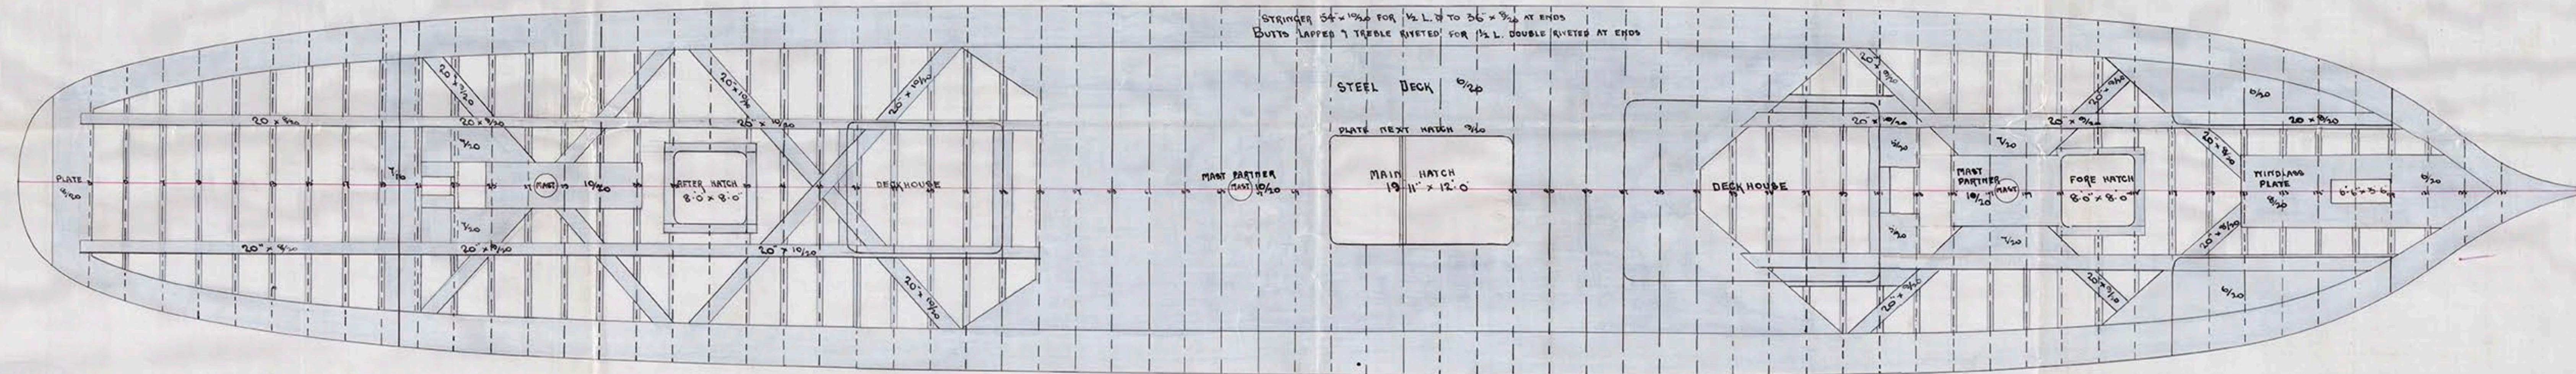

1407



© 2018
Lloyd's Register
Foundation