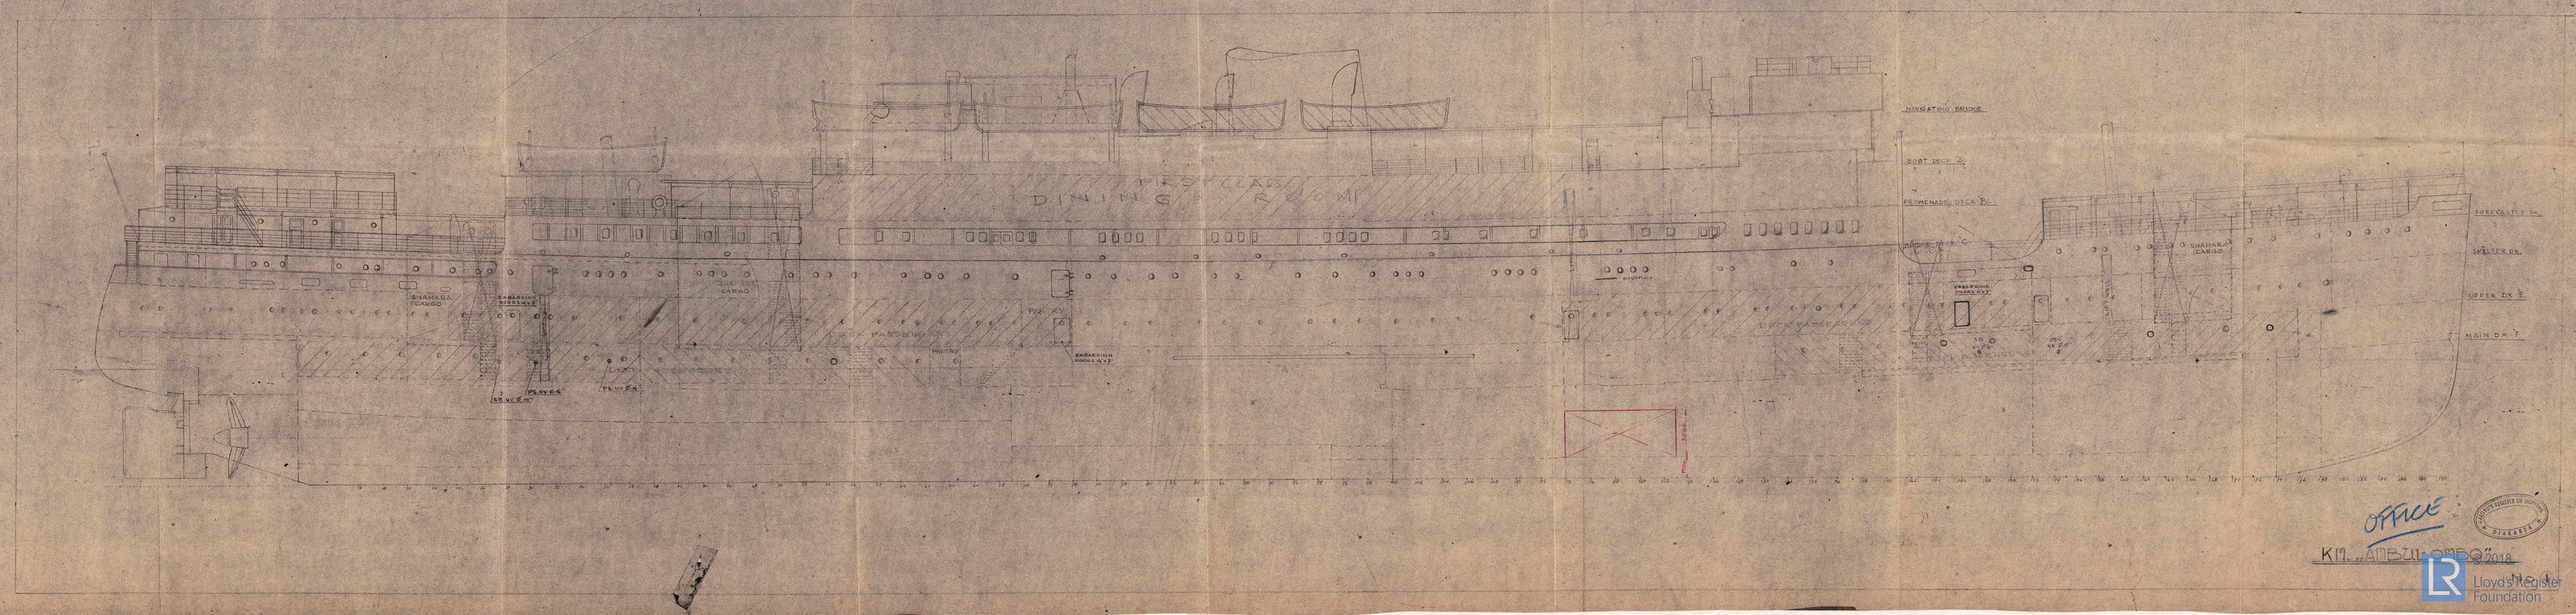
NAVIGATING BRIDGE
BOAT DECK D
PROMENADE DECK E
PROMENADE DECK C
FORECASTLE DK
SHELTER DK
UPPER DK F
MAIN DK F
DINING ROOM
SHAHARA CARGO
EMBARKING DOORWAY
INDUSTRY
EMBARKING DOORWAY
SHAHARA CARGO
EMBARKING DOORWAY
OFFICE
KM. ANBZU. OPBQ 2018