

H/s Mont Blanc Received at *Middlesbro'* office, *18th Nov^r 1898*

Lloyd's Register of British and Foreign Shipping.

(Report on Vessel No. *2620* Port *Mdb*)

No. *3865.a* SHIP FORGINGS OR CASTINGS.

The words FORGINGS or CASTINGS, IRON or STEEL, should be struck out as may be required.

I have to report that the undermentioned Iron or Steel Forgings or Castings, manufactured by *The Sunderland Forge Co.* of *Paltion* for the Vessel No. *460*, being built by *Messrs Dixon Co.* of *Middlesbro* have been inspected by me as set forth below, and found to be, so far as can be seen, *sound*


Mark on Forgings.

Lloyd's
No. _____

Messrs Cameron
Sunderland
16.11.98.

	STERN FRAME.	RUDDER FRAME.	STEM.
Material* ...	<i>Scrap</i>	<i>Scrap</i>	<i>Scrap</i>
How made ...	<i>Forged</i>	<i>Forged</i>	<i>Forged</i>
Dimensions ...	<i>10 x 6'</i>	<i>8 1/2 - 4 1/4</i>	<i>12 x 2 1/4</i>
Progress on Inspection	<i>Forged & Smithed</i>	<i>Forged & Smithed</i>	<i>Forged</i>
Date when Inspected	<i>June 14th to Aug 8/98</i>	<i>Sept 8th to Nov 5/98</i>	<i>July 8/98</i>

SKETCHES OF FRAMES SHOWING POSITION AND DESCRIPTION OF WELDS OF FORGINGS, OR PARTICULARS OF TESTS APPLIED TO CASTINGS.

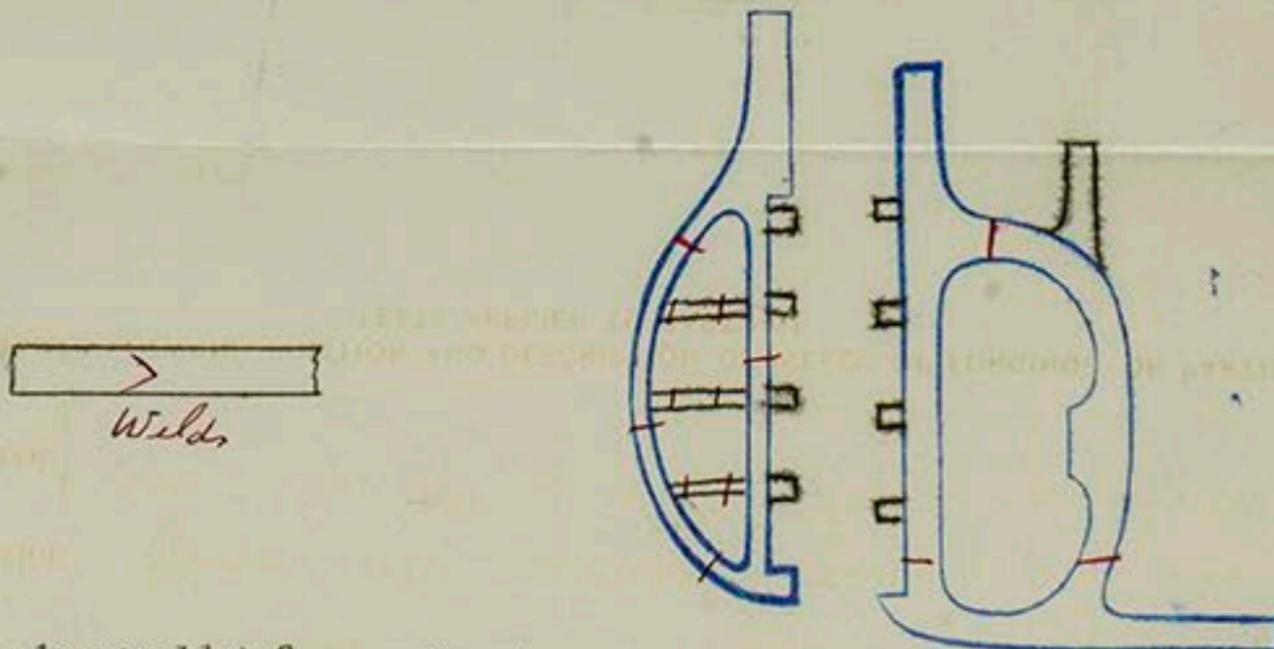

Fee (if any chargeable) £ : :

To be paid at _____

* If of Iron, state whether scrap or puddled Iron.