

Lloyd's Register of Shipping.

(Report on Vessel No. 54690

Port Glasgow

)

No.

SHIP FORGINGS OR CASTINGS.

I have to report that the undermentioned Iron or Steel Forgings or Castings, manufactured by James T. S. Forster & son Ltd. of Sunderland for the Vessel No. 325, being built by James Scott & son Ltd. of Bowling have been inspected by me as set forth below and found to be, so far as can be seen, Sound

Task on Forgings or Castings.

Lloyd's



No. 7144

JD 10-1-34

J Dale
Sunderland

	STERN FRAME.	RUDDER FRAME.	STEM.
Material* ...	Scrap iron		
How made ...	Forged & Smithed		
annealed ...			
Dimensions ...	6½ - 578 x 278		
Progress on Inspection ...	Forging & Smithing		
Date when Inspected ...	10-1-34		
CASTINGS.			
Tests on Standard Test Pieces.			
Tensile Test—			
Tons per square inch ...			
Extension per cent. ...			
Cold Bending Test—			
Angle before fracture ...			
Drop Test—			
Height from ground ...			
Hammering Test—			
If made according to Rules and found satisfactory ...			

SKETCHES OF FRAMES SHOWING POSITION AND DESCRIPTION OF WELDS OF FORGINGS.

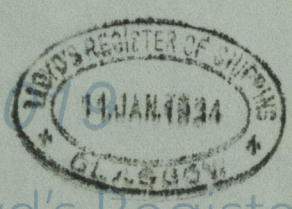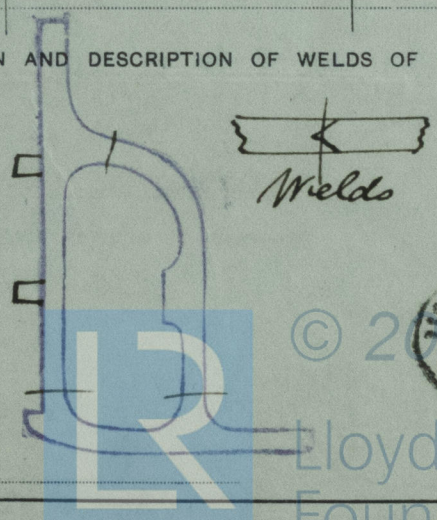

Fee (if any chargeable) £

To be paid at

* If of Iron, state whether scrap or puddled Iron. If of Steel, state whether made on the Open Hearth process.