


Scale  $\frac{1}{2}$ " = one foot

4/2/86

Class A, - "Steam Hopper Dredger."

Dredger "B. D. 1." Glasgow Report 4445.—

RETAIN

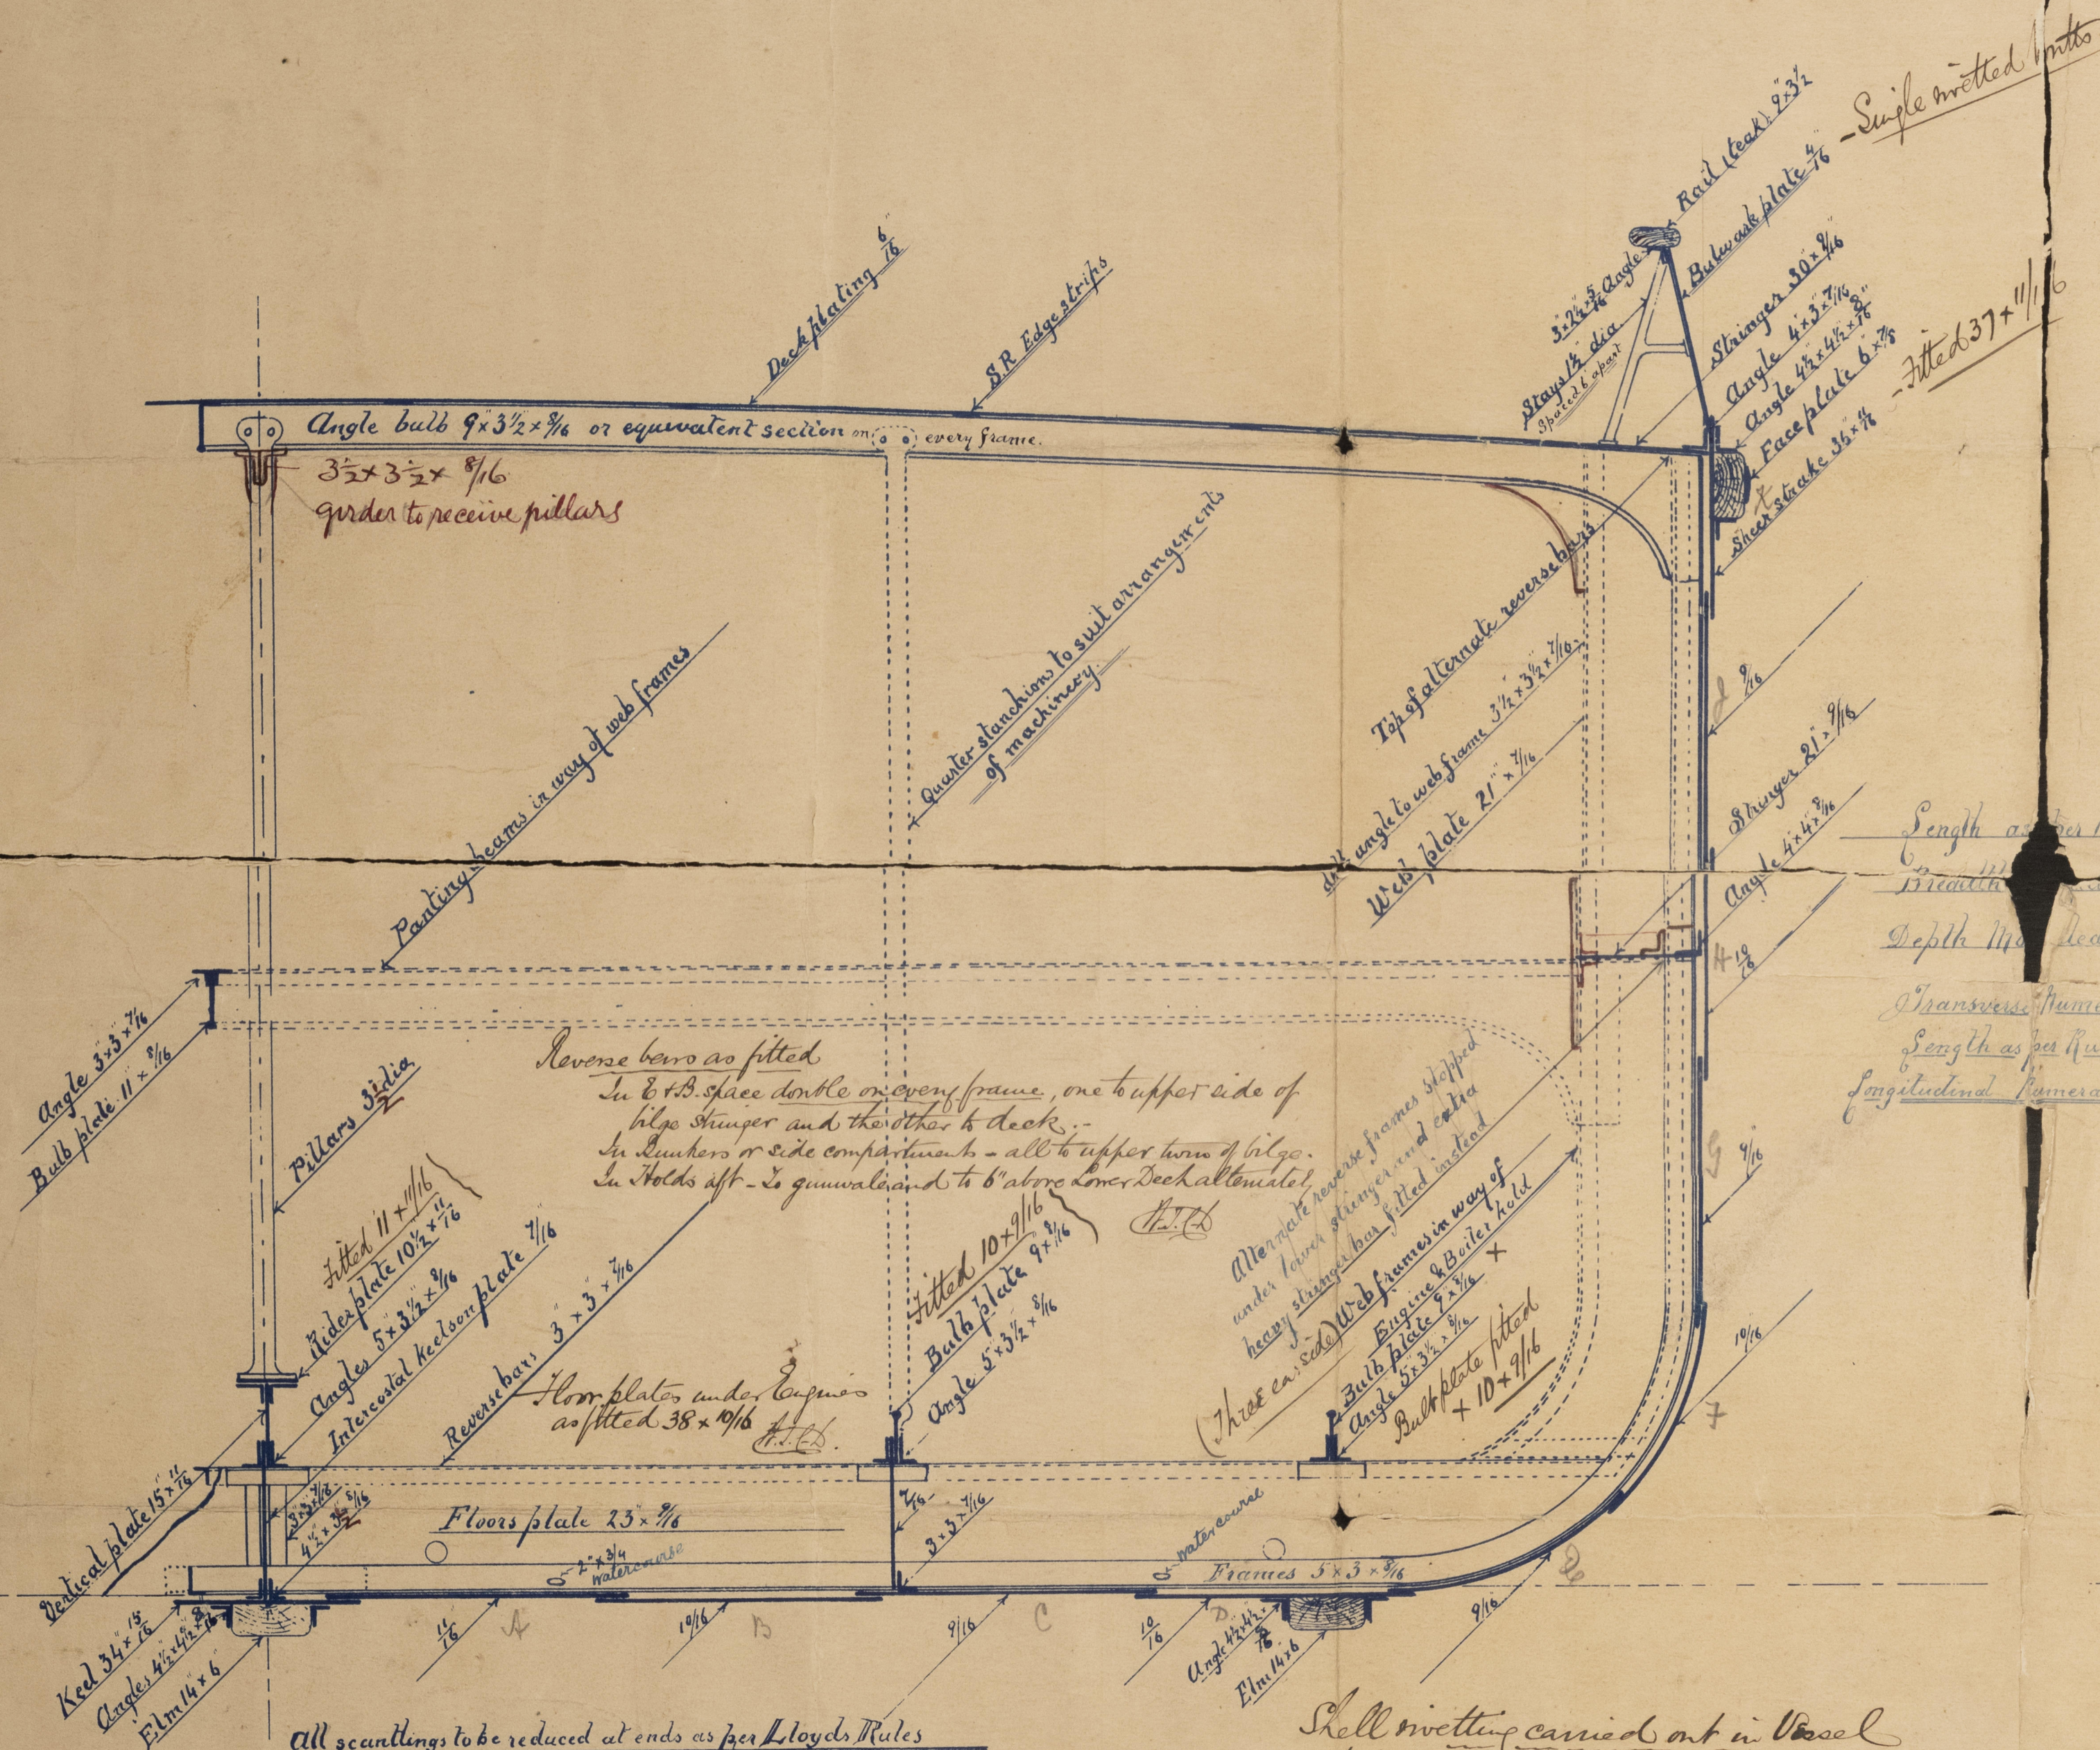


Length as per Rule 198 feet  
 Breadth as per Rule 15 feet  
 Depth as per Rule 17 feet  
 Transverse Numerical 75.07  
 Length as per Rule 198  
 Longitudinal Numerical 14,863.56

Midship Section.

Shell rivetting carried out in Basel  
Snake. A (Keel Plate) Butts rivble rivtled

B	do.
C	do.
D	do.
E	do.
F	do.
G	Butts rivble rivtled
H	do.
I	do.
J	do.
K	do.
L (Shoe Snake)	Butts rivble rivtled

Triple riveted straps  $14 \times \frac{12}{16}$ , and  $11 \frac{1}{2} \times \frac{10}{16}$ ; and  $14 \frac{1}{2} \times \frac{10}{16}$   
Double riveted straps  $11 \frac{1}{2} \times \frac{10}{16}$  and  $10 \times \frac{9}{16}$ . J. H. D.

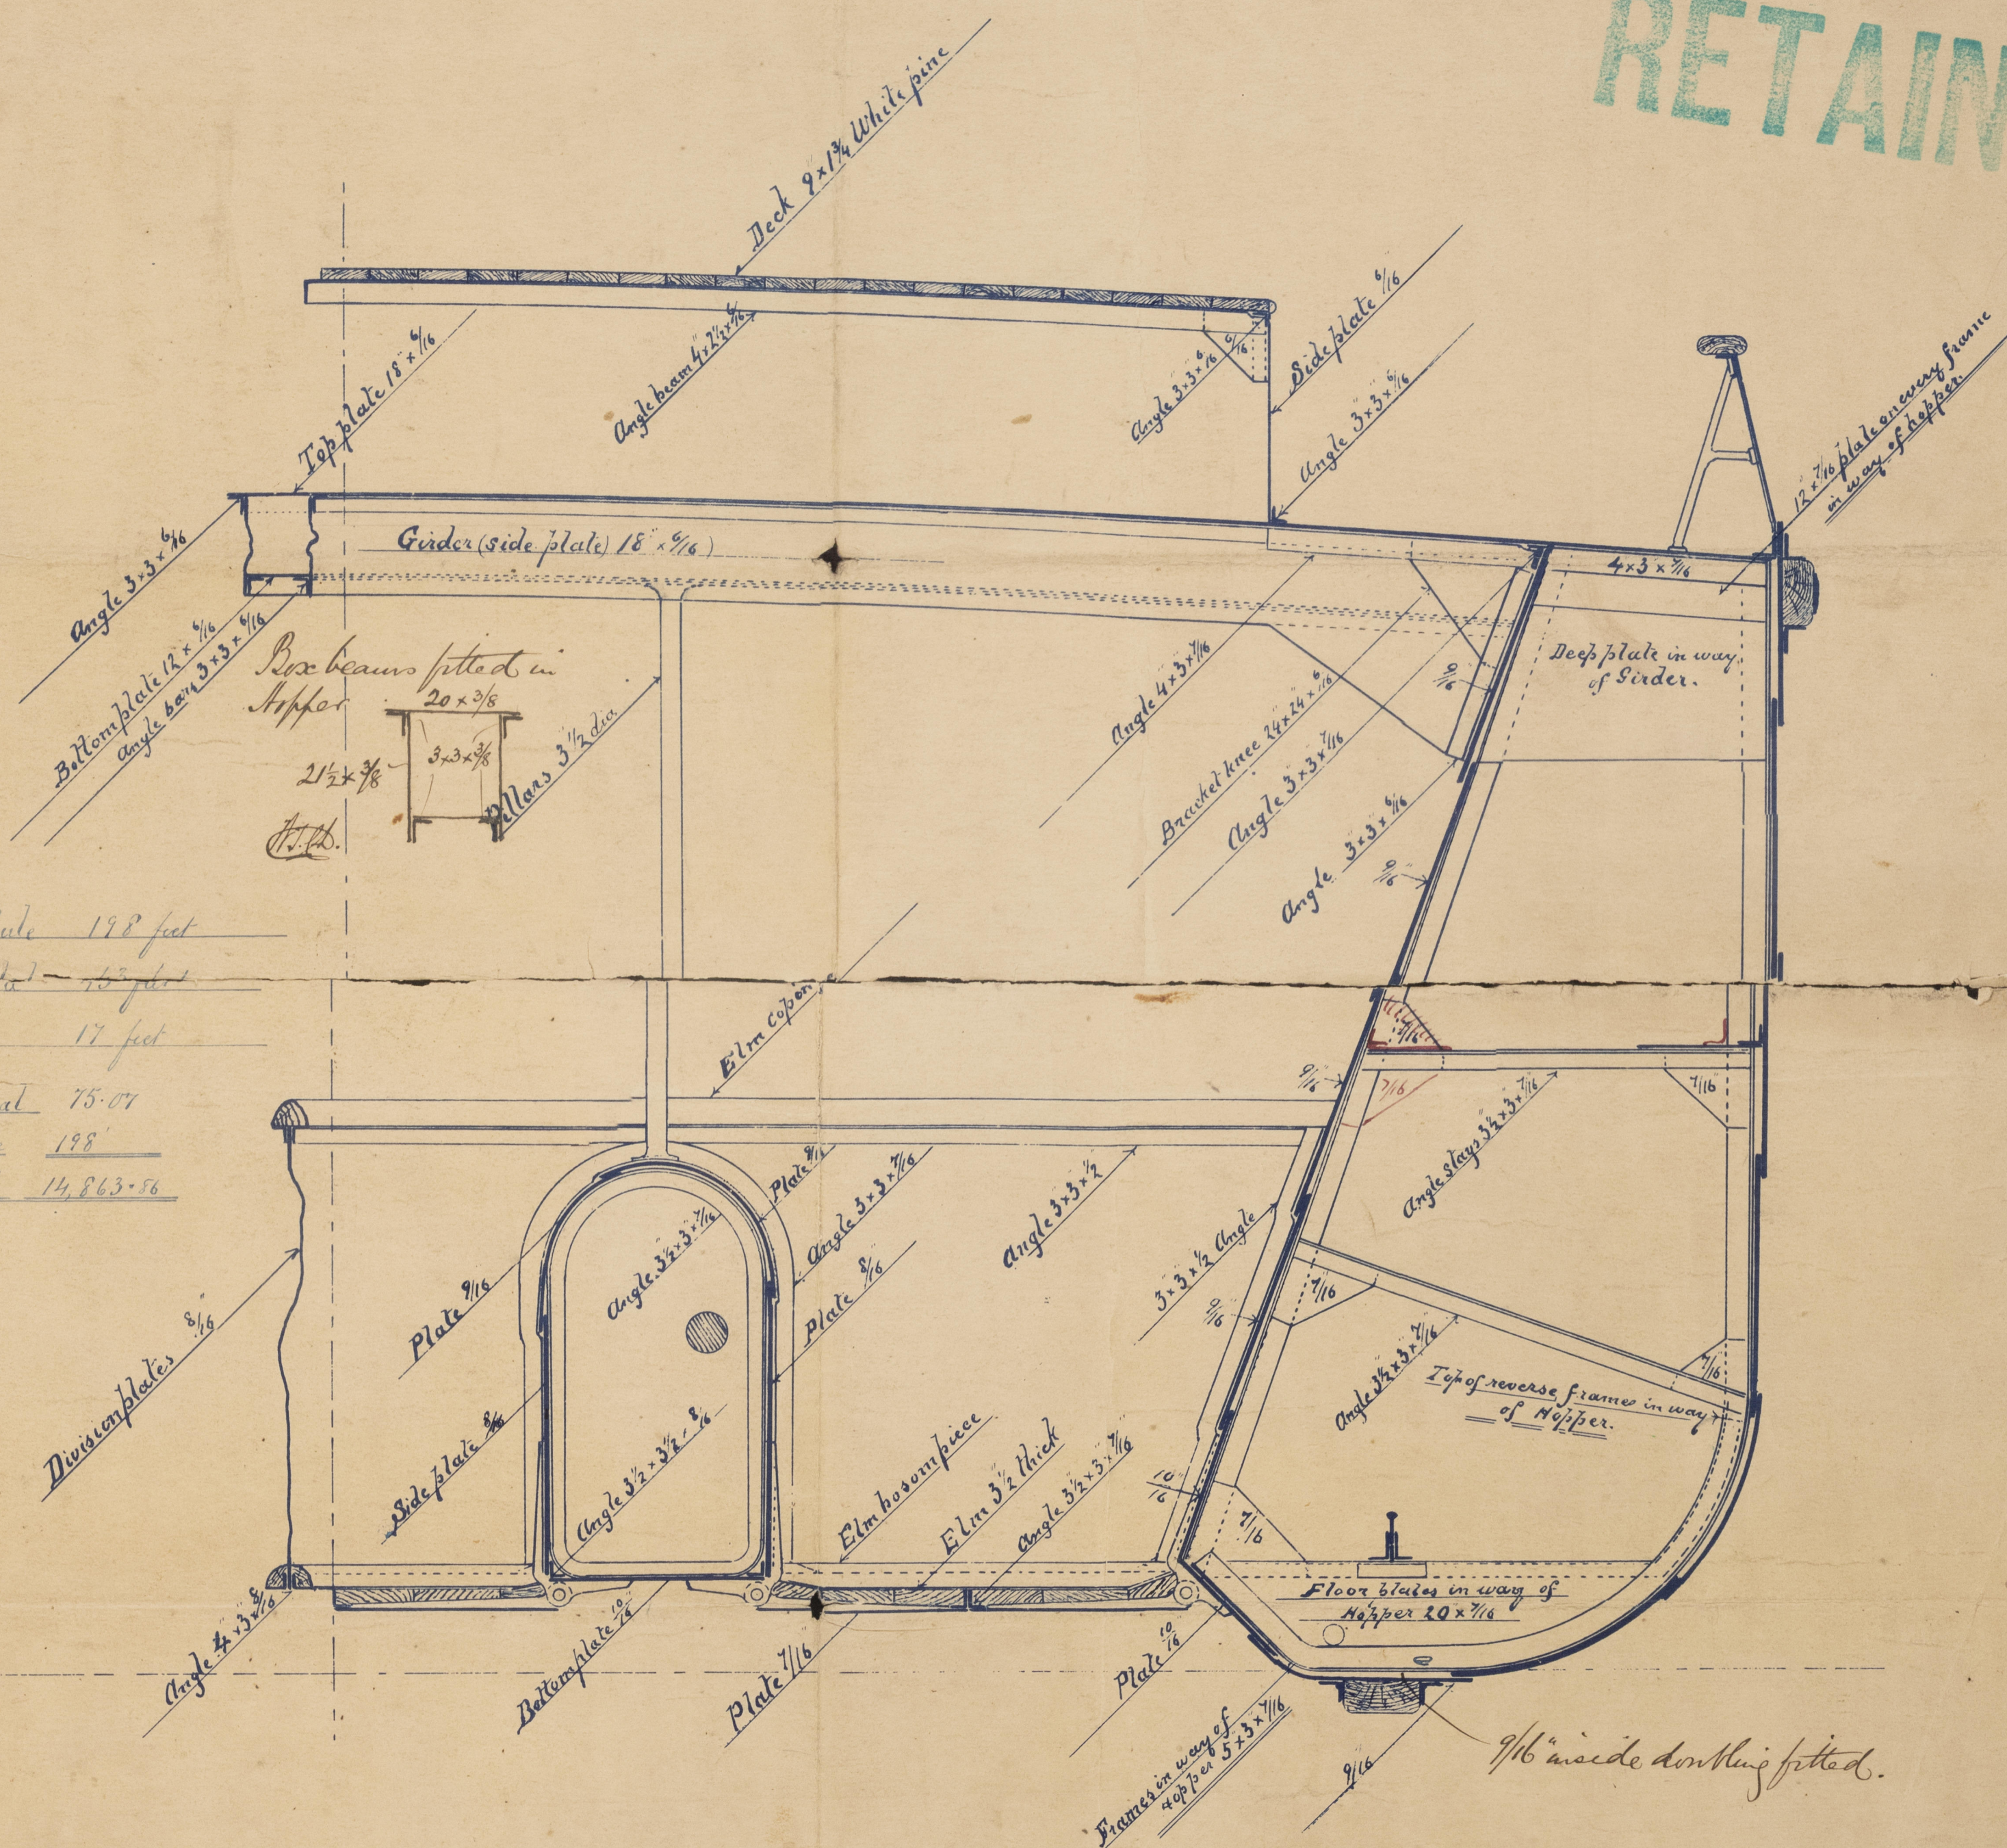

Section at Main Hopper.



002024-002037-0127



© 2020


Lloyd's Register  
Foundation



B. D. M. 10-1

86. R. 17745

002024-002037-0127 © 2020

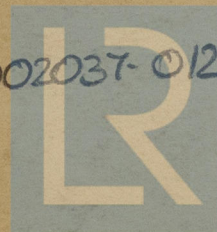

Lloyd's Register  
Foundation