


S.S. "LA MAREA". SECTION THRO' BOILER ROOM

SCALE: 1/2" = ONE FOOT

DIMENSIONS. 352'-6" MLD. x 48'-0" MLD. x 31'-9" TO UPPER DK.

TO CLASS B.S. & LLOYDS 100 A.I.

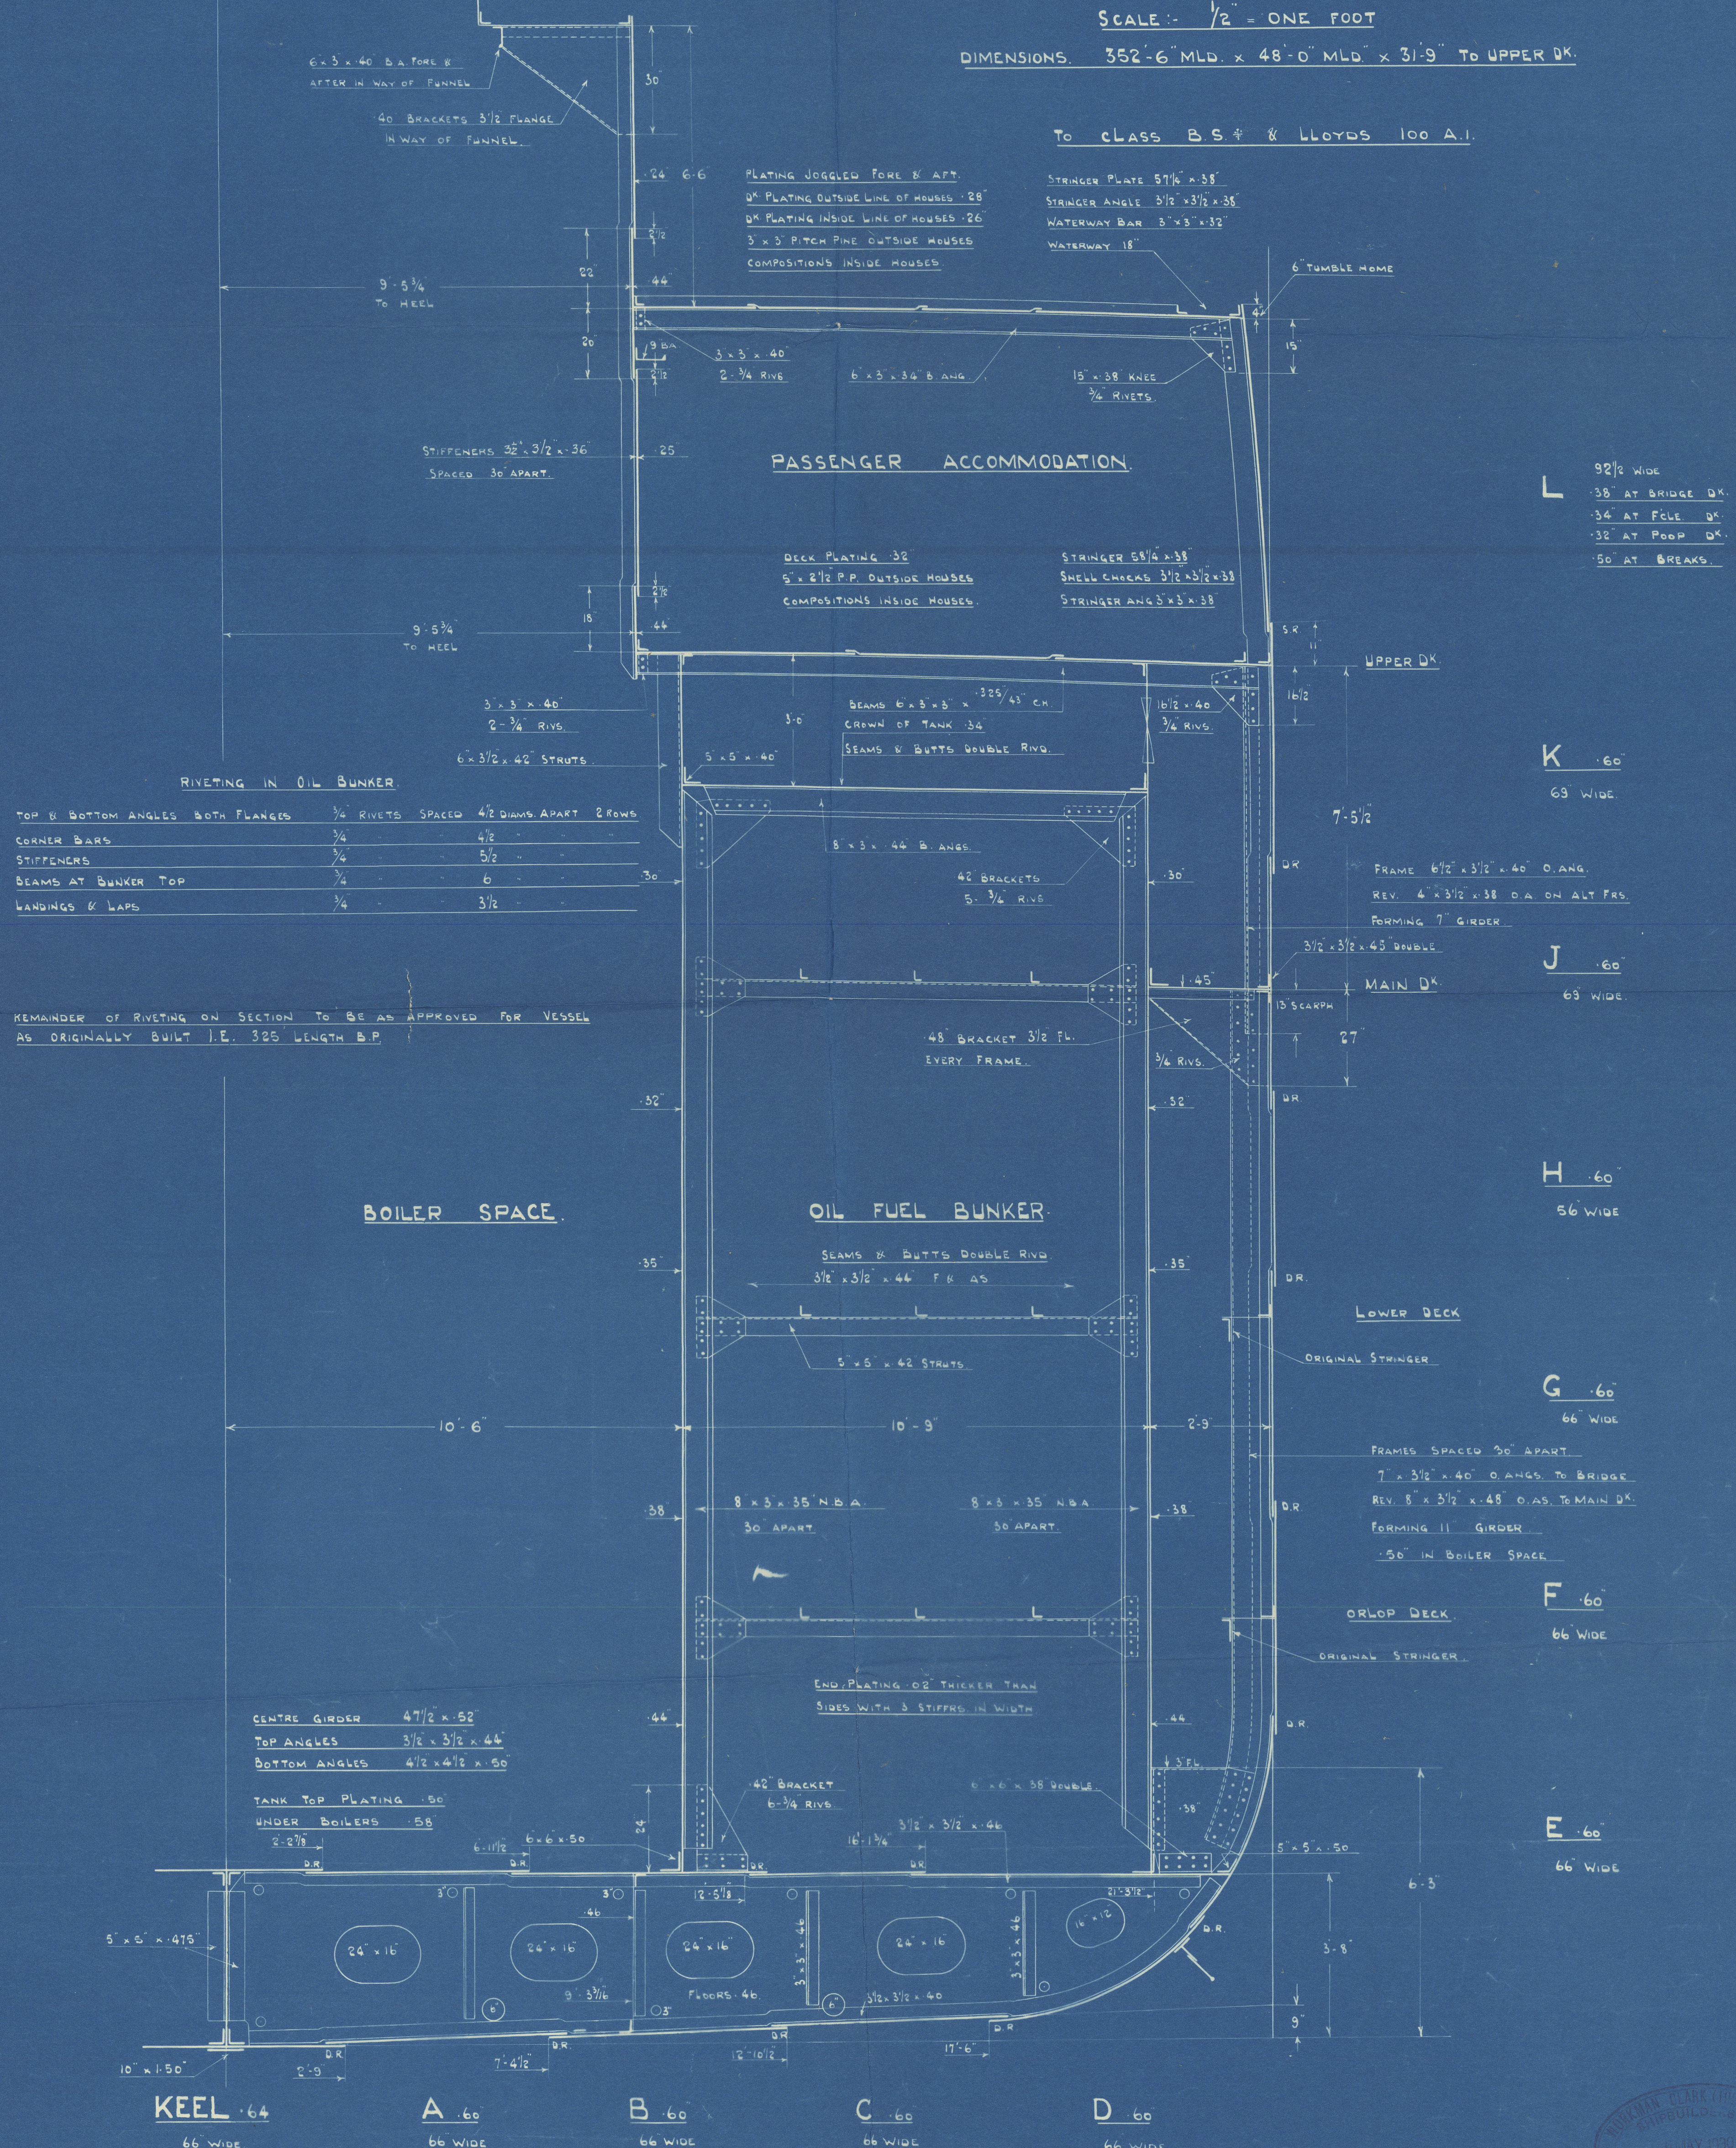


"
DARIEN"

(ex ha Maria)

Midshep Section as built.

Bel rept No. 10392.

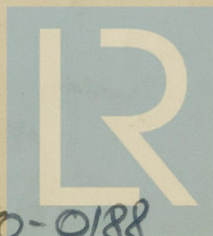

© 2020

Lloyd's Register
Foundation

002038-002050-0188