
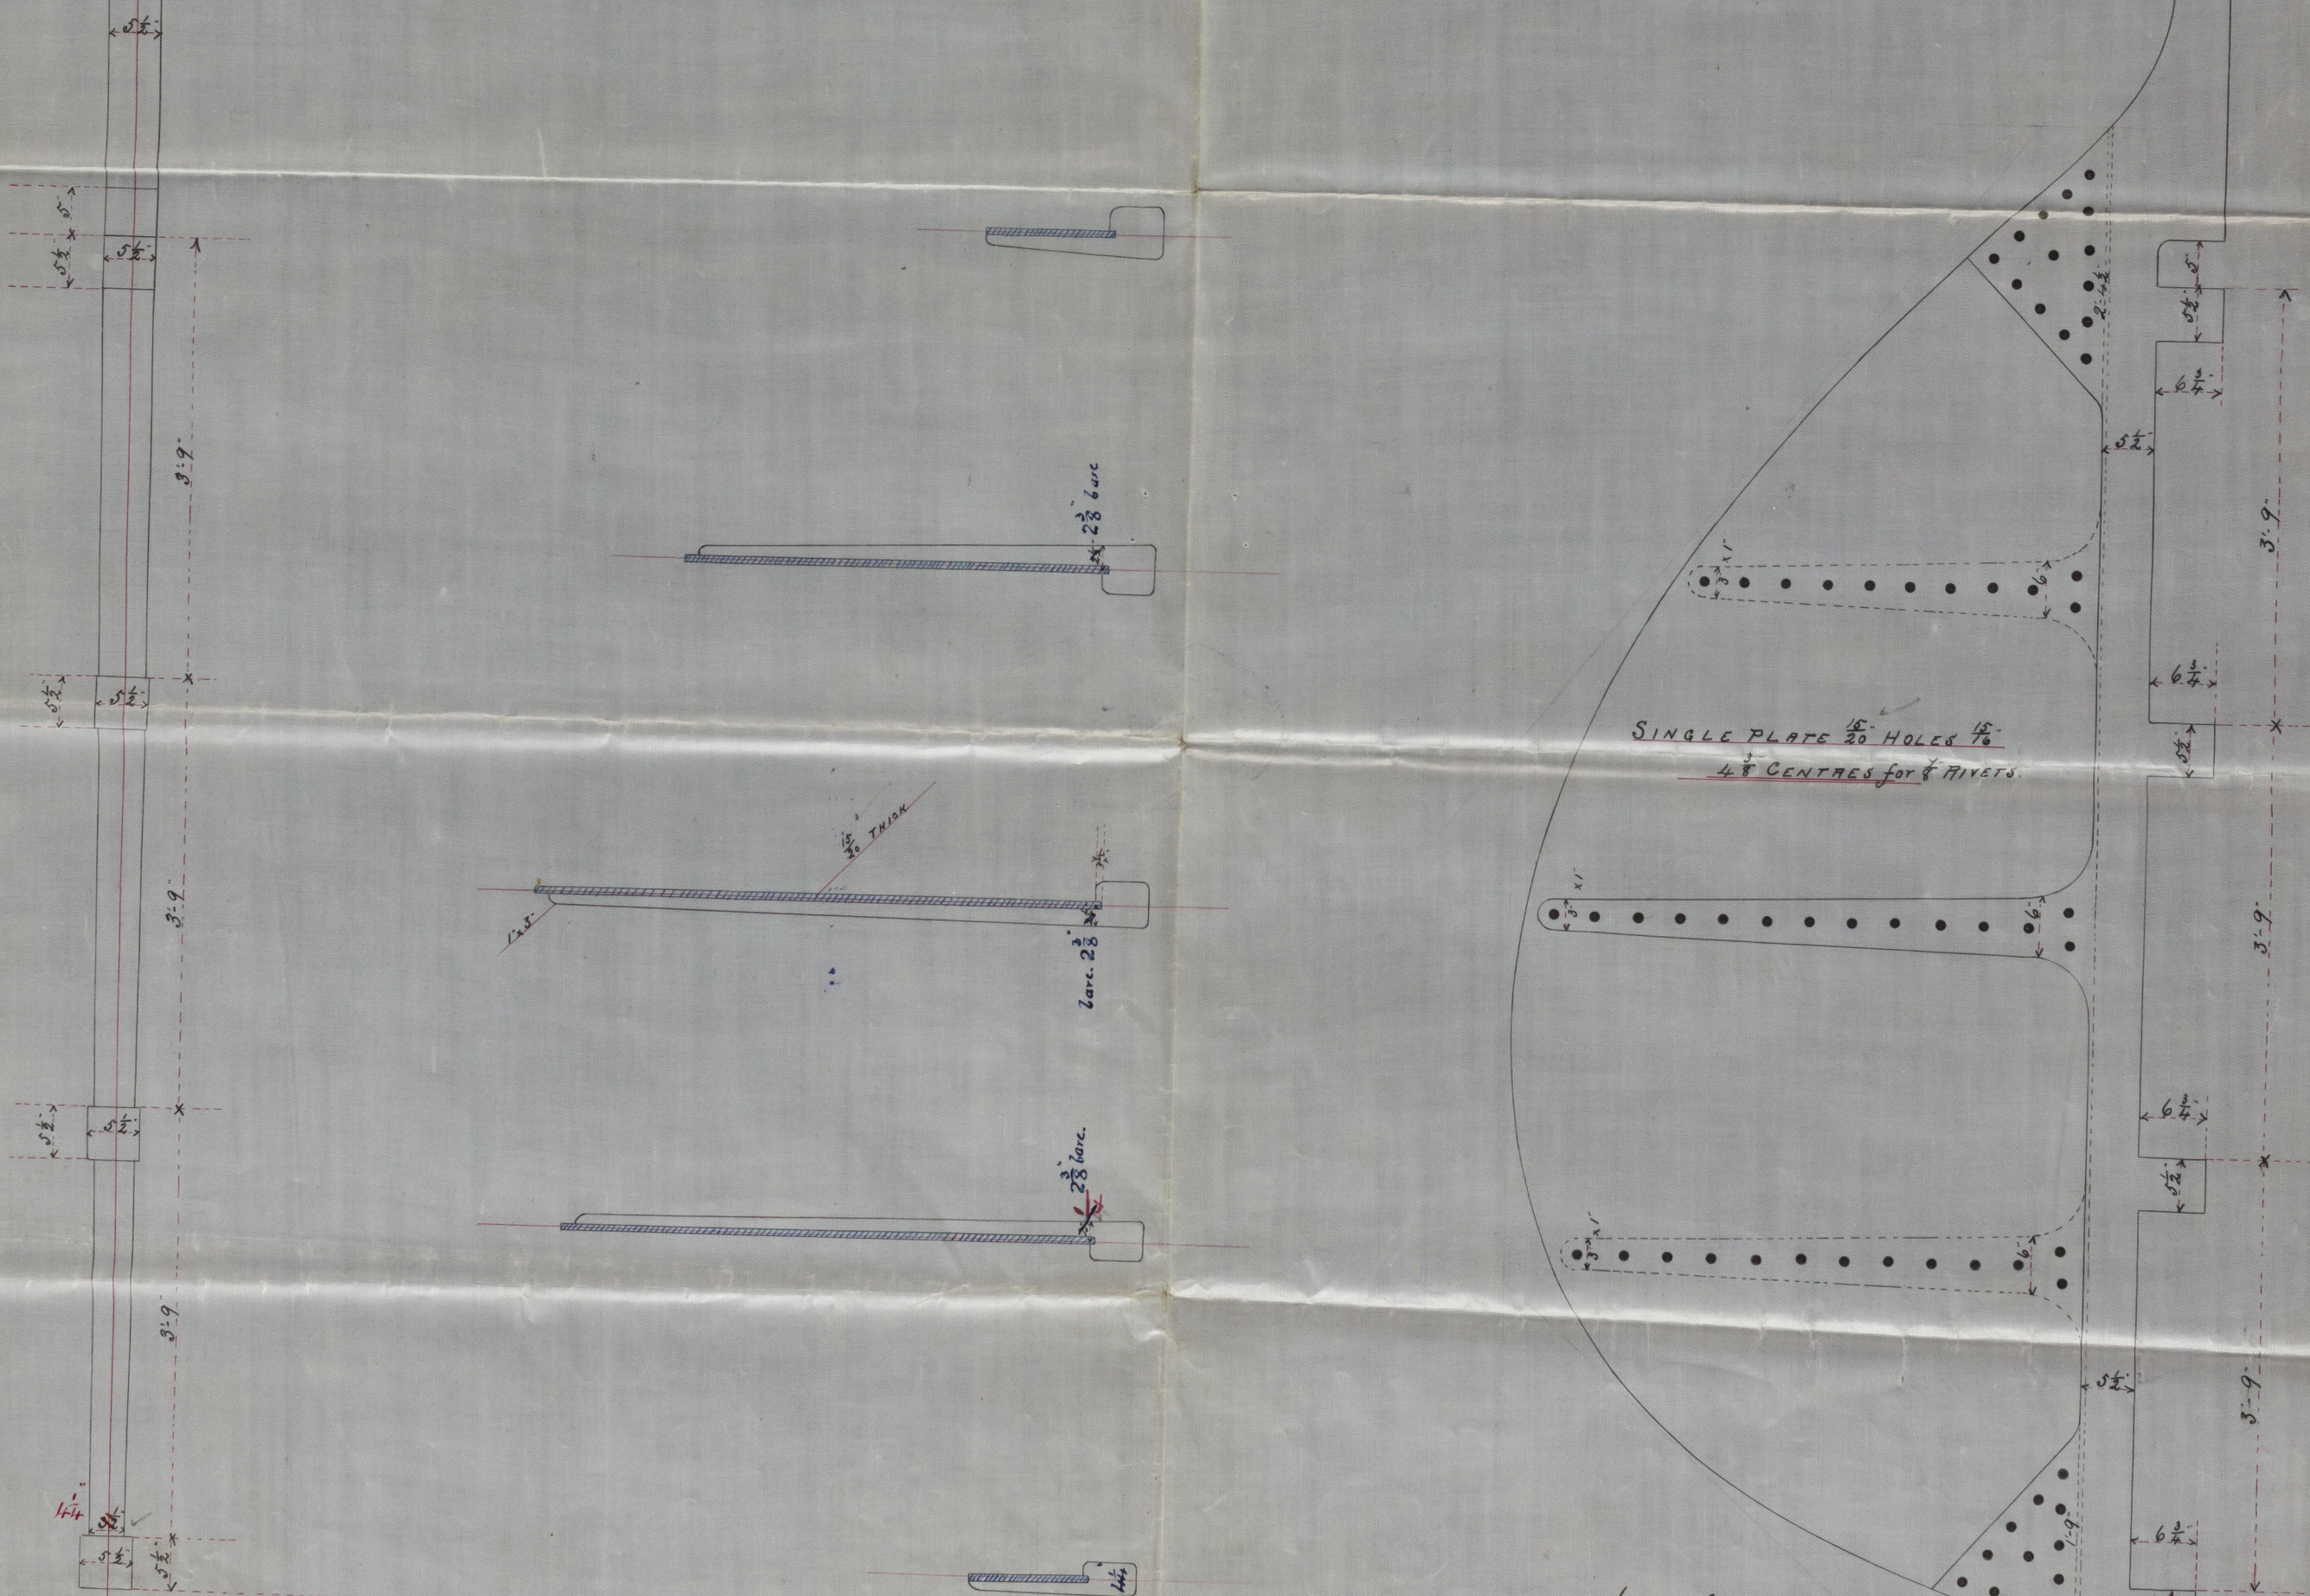


BUDDER S. S. 1/2 70.

SCALE $\frac{3}{4}$ INCH = 1 FOOT.

SCALE $\frac{3}{4}$ INCH = 1 FOOT.

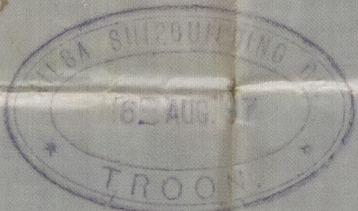


SINGLE PLATE $\frac{15}{20}$ HOLES $\frac{15}{16}$
4 $\frac{3}{8}$ CENTRES for 8 RIVETS

4³/₈ CENTRES for 8 RIVETS

220. 9/8/97

© 2020
Lloyd's Register
Foundation
002051-002061-0202

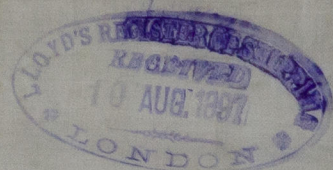

X

RUDDER

06

GLASGOW. No. 16134

S. S. McBride

When Dis
by