

5779
Albatross
R. P. Fitch
1888/89

H.M.A.S. "ALBATROSS."


RUDDER [AS FITTED]

SCALE $1\frac{1}{2}$ = ONE FOOT.

Class 100A- with feedback corresponding to a summer moulded draught of 17 feet.

	TONS	CWTs.	Qrs.	Lbs.
TOTAL WEIGHT	11	3	1	2 1/2

RYETING- SIDE PLATES ARE RIVETED WHERE POSSIBLE ON STARBOARD SIDE OF RUDDER STAFFED ON PORT SIDE
1. RIVETS AT FORWARD EDGE OF RUDDER IN WAY OF COVERING PLATE - 4 1/2 INCHES APART
2. RIVETS IN OTHER EDGES IN WAY OF FASHION STRIPS - 4 1/2 INCHES APART
3. RIVETS ON 1/8 INCH TAPED BUTT JOINTS EDGES OF PLATING CLEAR OF FASHION STRIPS AND
WHERE PLATING BUTT - 4 1/2 INCHES APART
THE HEADS OF COUNTERSINK RIVETS ARE FLAT
THE SPACES BETWEEN SIDE PLATES ARE FILLED WITH GREEN PINE WELL WEDGED IN PLACE

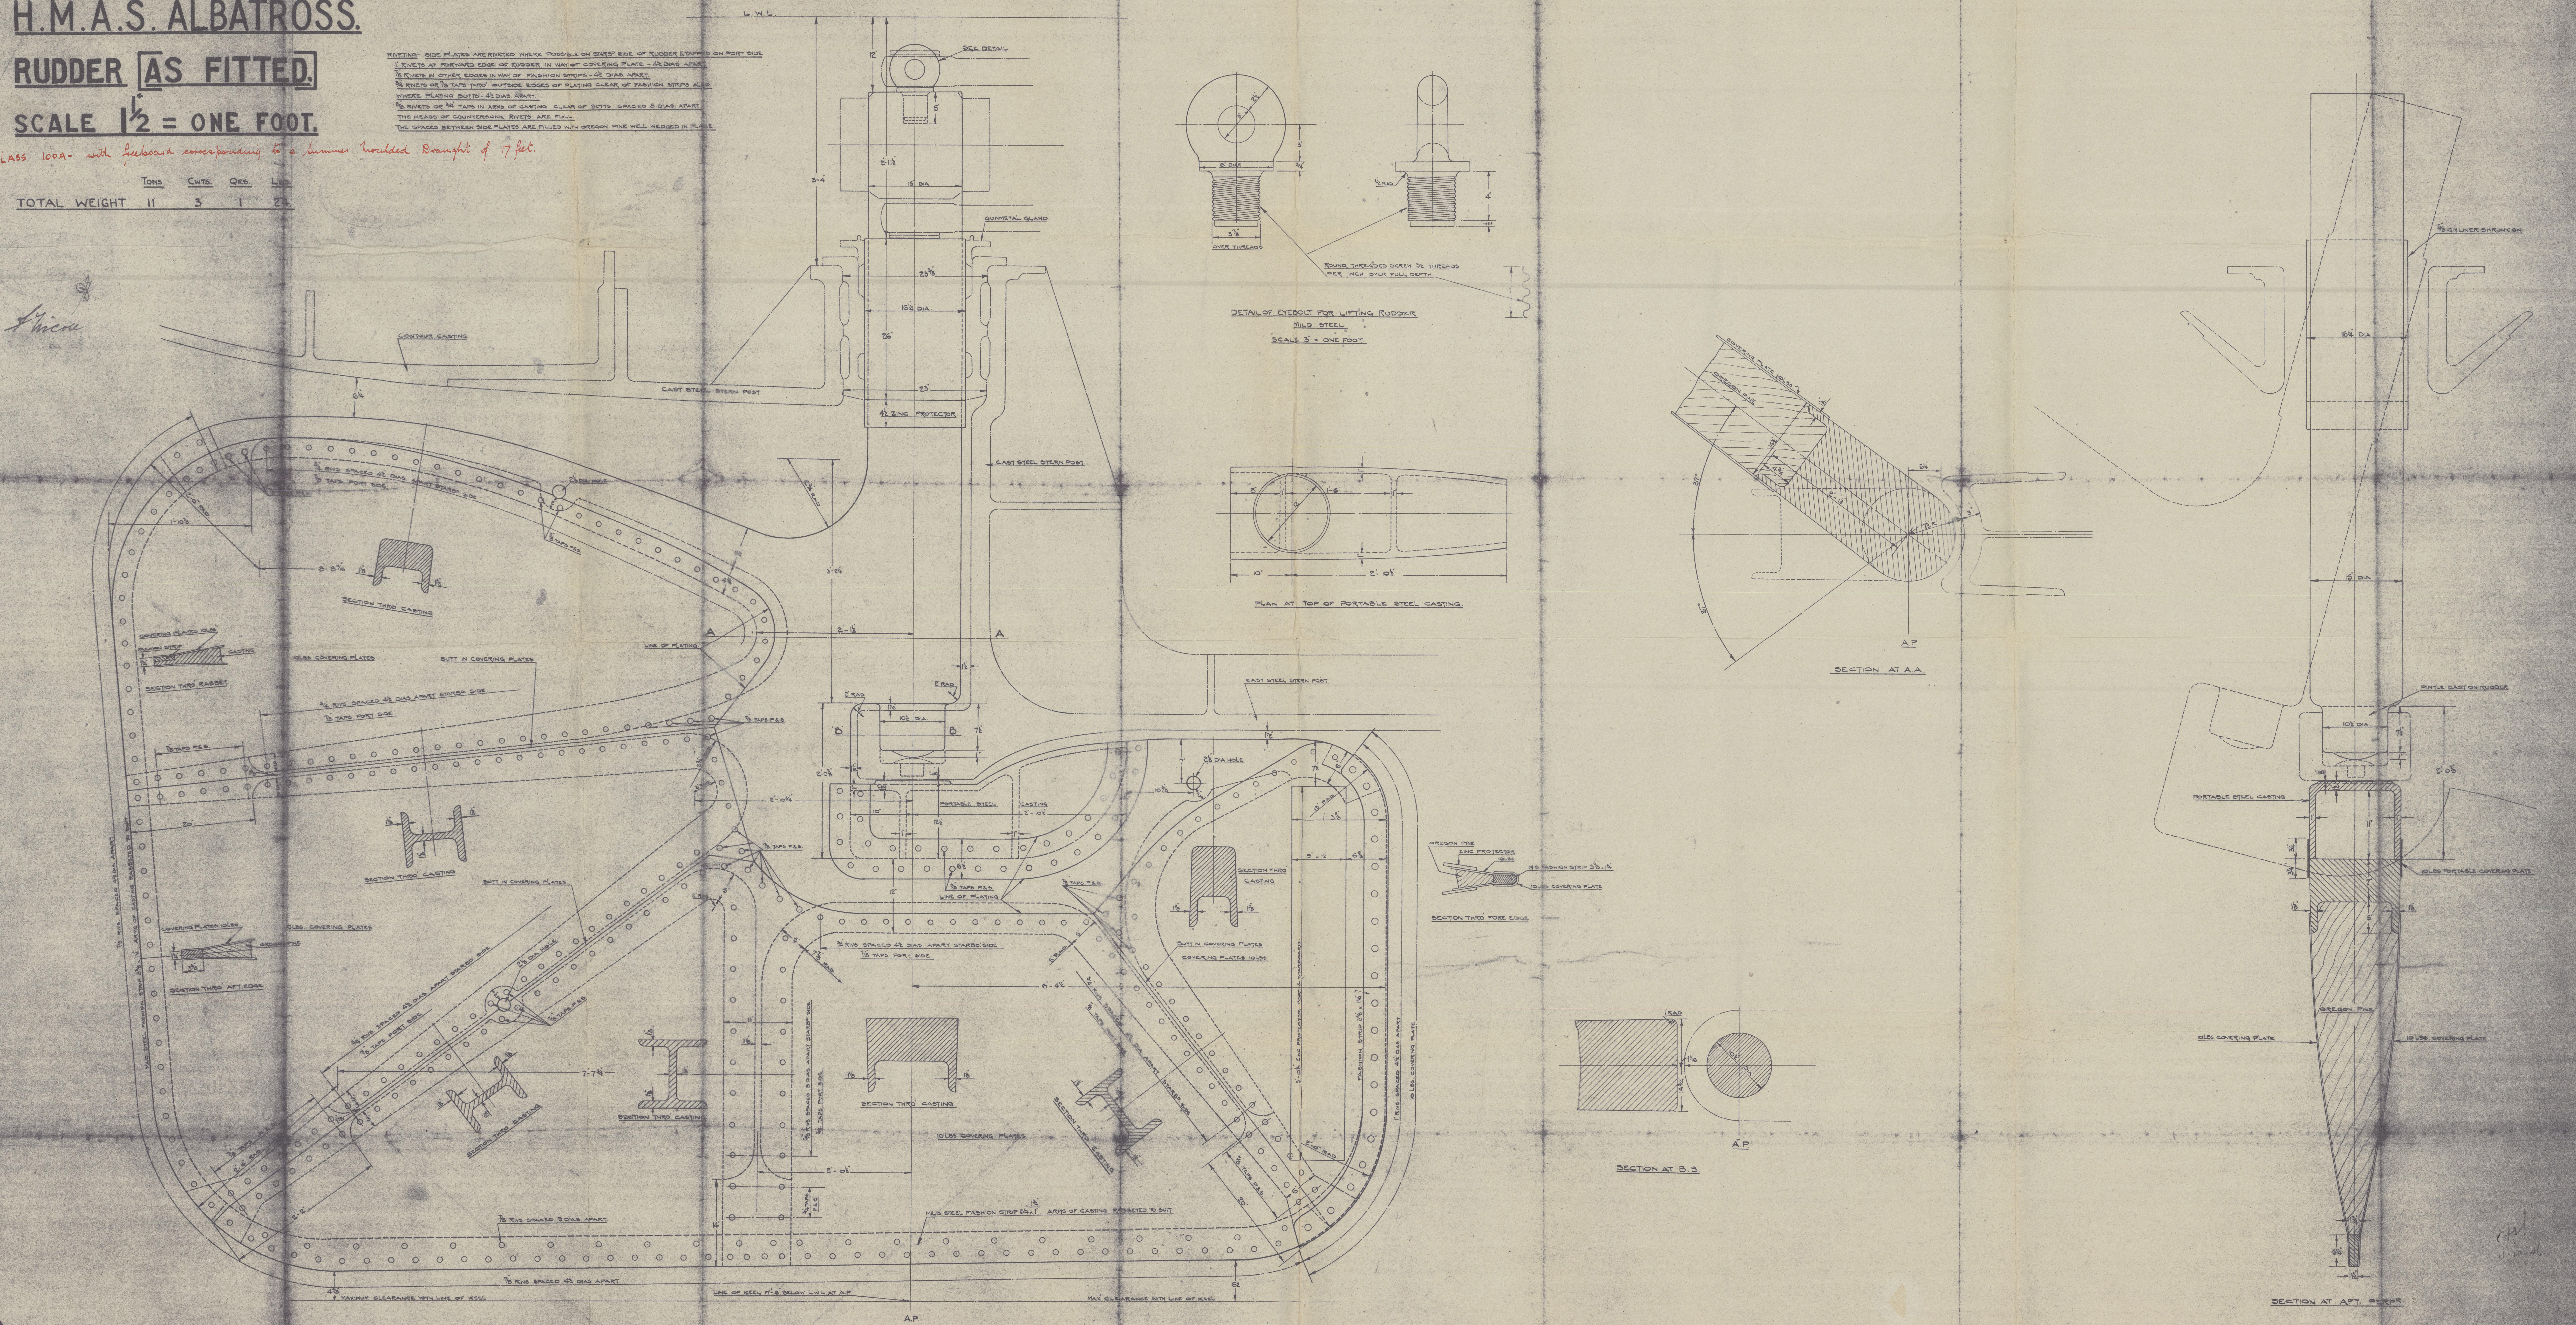

"Pride of Torquay" ★

^{ex}
"Albatross"

N.N. "HELLENIC PRINCE"


Rudder as fitted.

Lon rept No. 114788

1203-

A

RECORDS DEPT..
LONDON

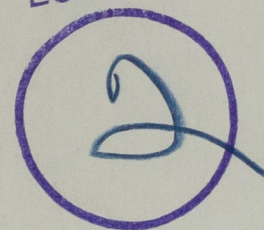

© 2020

Lloyd's Register
Foundation

0000-00200-290200