




Do all the Frames extend to the top height in the Poop? *yes*  
 To what height do the Reverse Frames extend? *built angle framing 19717*  
 Has the ~~Poop~~ Raised Quarter Deck an efficient Iron Bulkhead at the fore end? *no*  
 Give particulars of the means for closing the openings in Bulkhead *no openings*  
 Is the ~~Poop~~ Raised Quarter Deck connected with the Bridge House? *yes*  
 Give particulars of the means for closing the openings in Bulkhead *no openings*  
 What is the thickness of the Bridge Front plating? *5/20* and Coaming plate? *6/20*  
 Give scantlings and spacing of the Stiffeners *6x3x8/20 built angle spaced 30"*  
 Are bracket plates fitted at each end of the Stiffeners? *yes*  
 Has the Bridge House an efficient Iron Bulkhead at the after end? *yes*  
 How are the openings closed? *no openings across jamed tho' can't show no for*  
 Is the Forecastle at least as high as the main or top-gallant rail? *yes*  
 Are the Engine and Boiler openings covered by a ~~Bridge, Poop, Raised~~ Quarter Deck, or enclosed by a Strong Iron or Steel Deckhouse? *yes*  
 If the openings are not so protected are the exposed parts of the Casings efficiently constructed? *yes*  
 Give thickness of plating; scantlings and spacing of Stiffeners *6/20 coaming 5/20 plating 3x2 1/2 x 7/16 angle 29" apart yes*  
 What is the height of the exposed Casings? *7-6 above 20"*  
 Are the Weather Deck Hatchways efficiently constructed and at least equal to the requirements of Section 28 of the Rules for 1904? Give particulars below *yes after hatchway rule*

Position and Size.	31-2 x 16-6		33-0 x 16-6		Ship.	Rule.	Ship.	Rule.
	Ship.	Rule.	Ship.	Rule.				
COAMING								
Height above top of DECK	30	} 100			30	24		
Thickness	Sides 9/20 Ends 8/20				9/20 8/20	3/20		
SHIFTING BEAMS OR WEB PLATES	Number 2 Section and Scantlings <i>plates 7/16 angle 3x3x7/16</i> Material <i>Steel</i>	} 100			<i>plates 7/16 angle 3x3x7/16 Steel</i>	100		
FORE AND AFTERS	Number 3 Section and Scantlings <i>11x2 1/2 10" P 3x3x7/16 8x8x7/16</i> Material <i>Steel angle 2 1/2 x 2 1/2 x 1/4</i>				DO Steel	DO		
HATCHES	Thickness 3	} 100			3 Solid	100		
Remarks	<i>solid</i>							

\* When the Fore and Afters are of wood the depth should be stated from the underside of the hatches.  
 (If the sill of the lowest side scuttle will be less than 6 inches above the Indian Summer Load Line if assigned under the tables, state vertical distance from top of deck at side amidships to lower edge of lowest side scuttle.)

The following information is to be given in all Cases of vessels dealt with under Paras. 11, 12 (under 15 feet Moulded depth) and under Shelter Deck Rules.

What is the thickness of the Bridge Sheerstrake? *5/20* Strake between Main and Bridge Sheerstrakes? *8/20*  
 Delete the words { The Crew ~~are not~~, berthed in the bridge house.  
 that do not apply { The arrangements to enable them to get backwards and forwards from their quarters are, ~~not~~ satisfactory.  
 Length of Bulwarks in well = *44-0*  
 Area of Freeing Ports required by Para. 11 (e) each side of vessel = *11-0* Sq. ft.  
 Ft. Tenth. Ft. Tenth. No. } Freeing Ports (each side of vessel) = *15-0* Sq. ft.  
*2.5* x *2-0* x *3*  
 Total deficiency or excess = *4-1* Sq. ft.

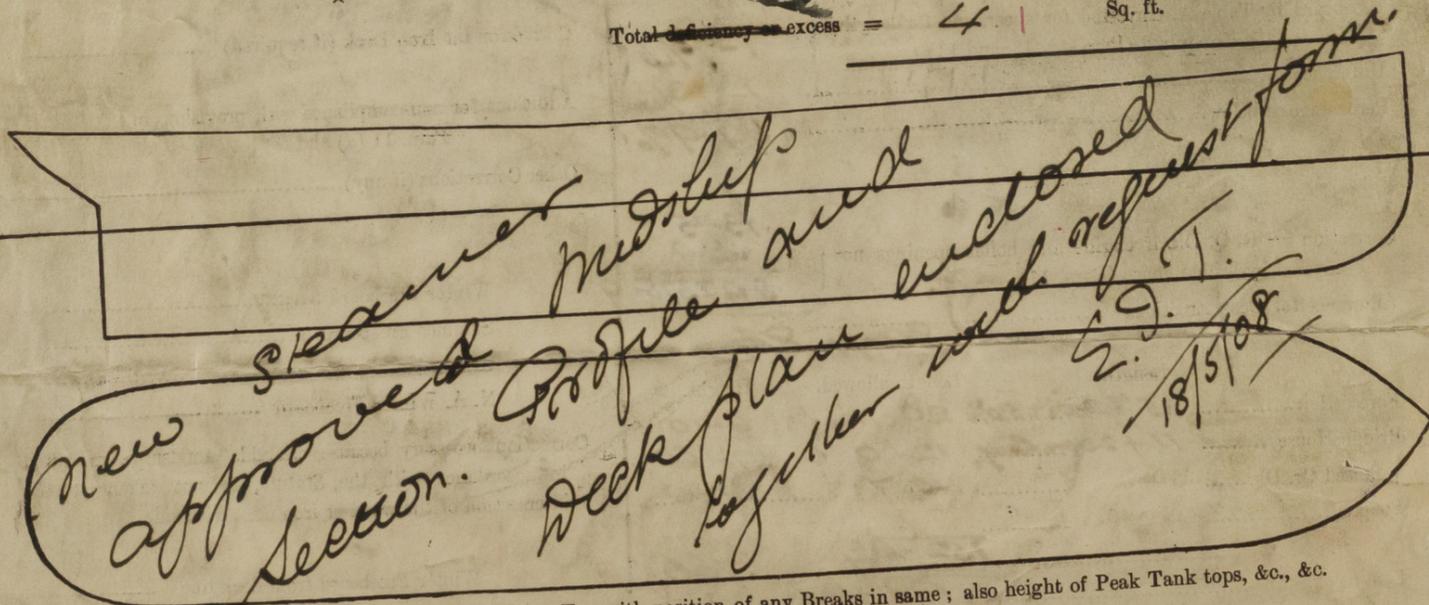

Show hereon line of Floors or Tank Top with position of any Breaks in same; also height of Peak Tank tops, &c., &c.

State any special features in the construction of the Vessel.

Owners \_\_\_\_\_  
 Address \_\_\_\_\_  
 Fee £ \_\_\_\_\_  
 Received by me \_\_\_\_\_

