



16-4-01

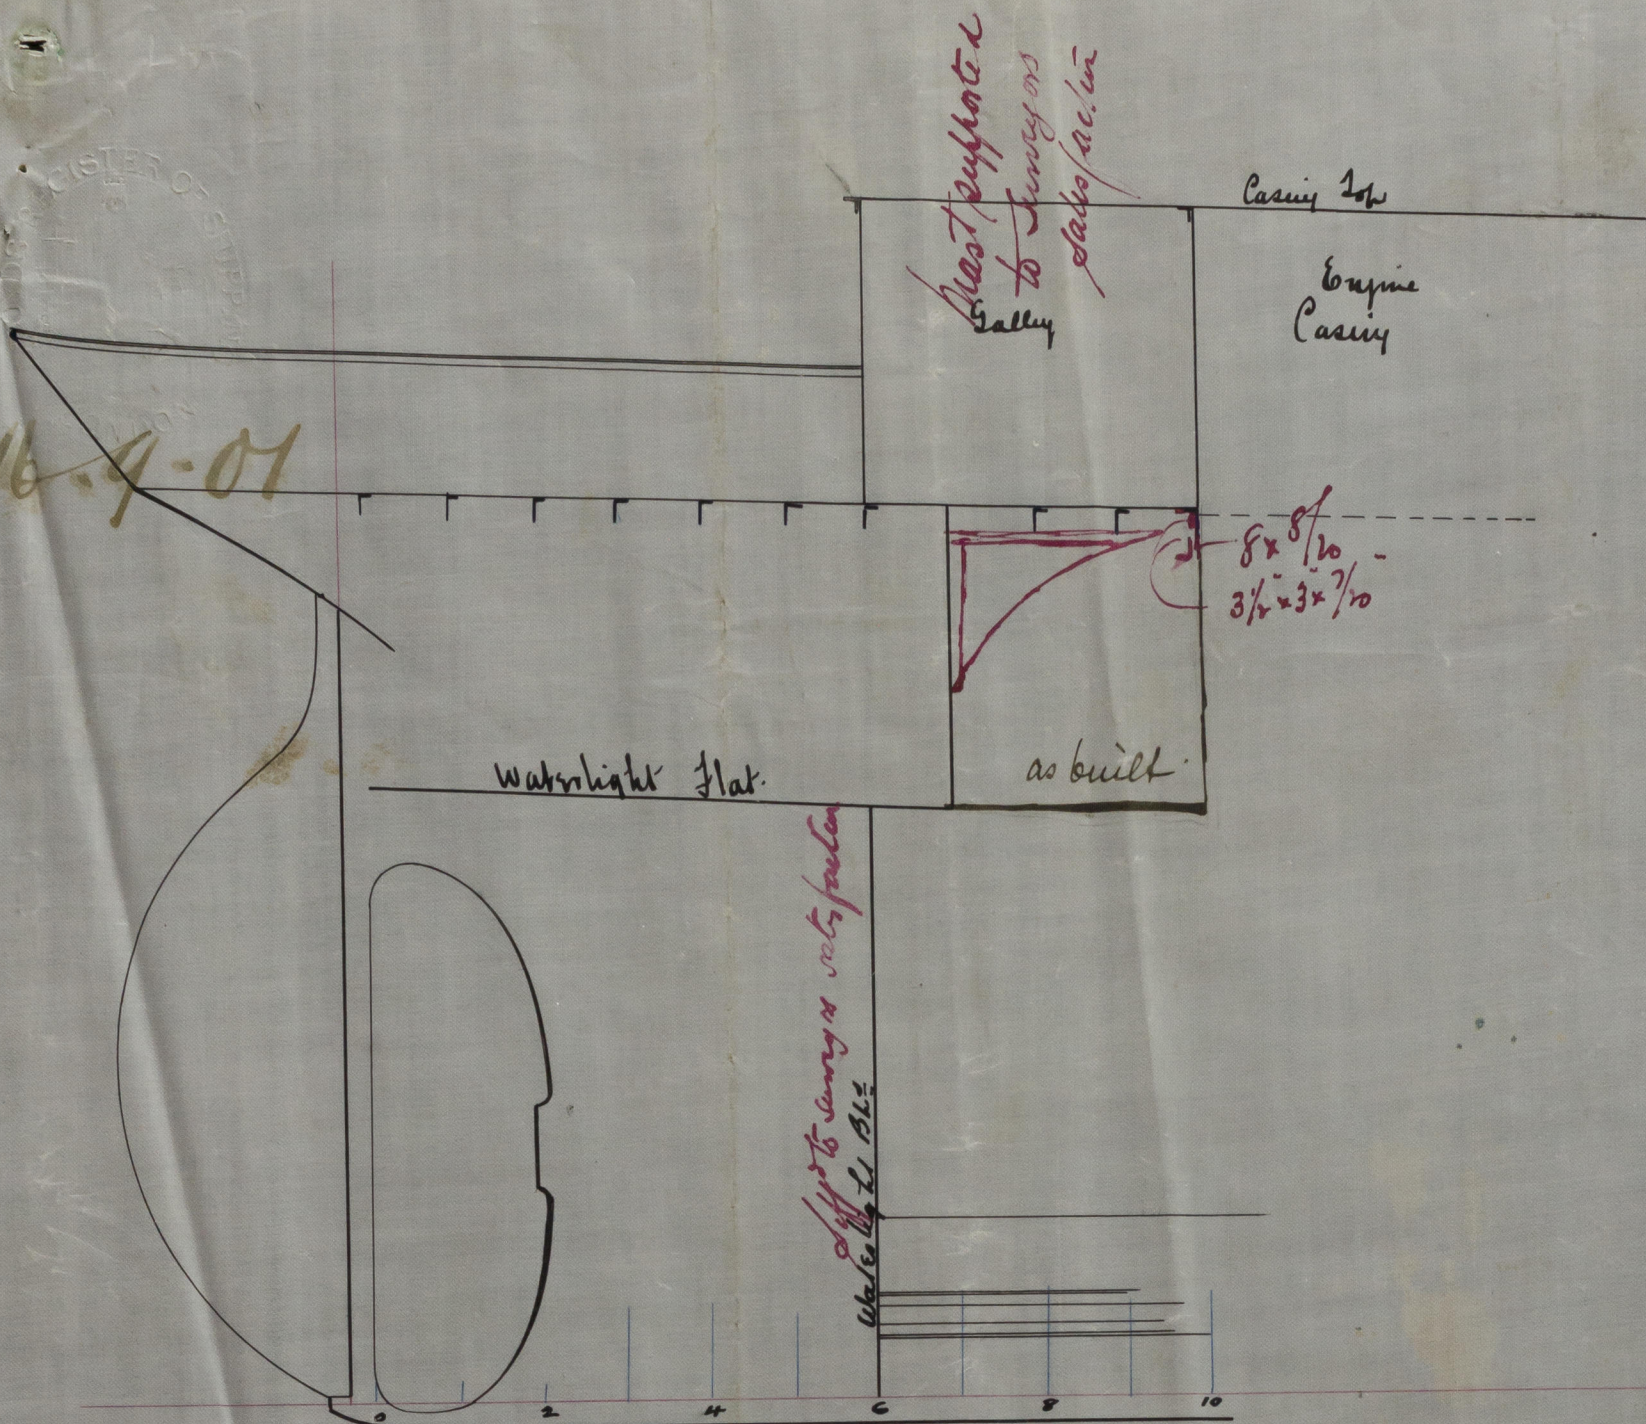

Rivets through frames
shall be drawn apart.

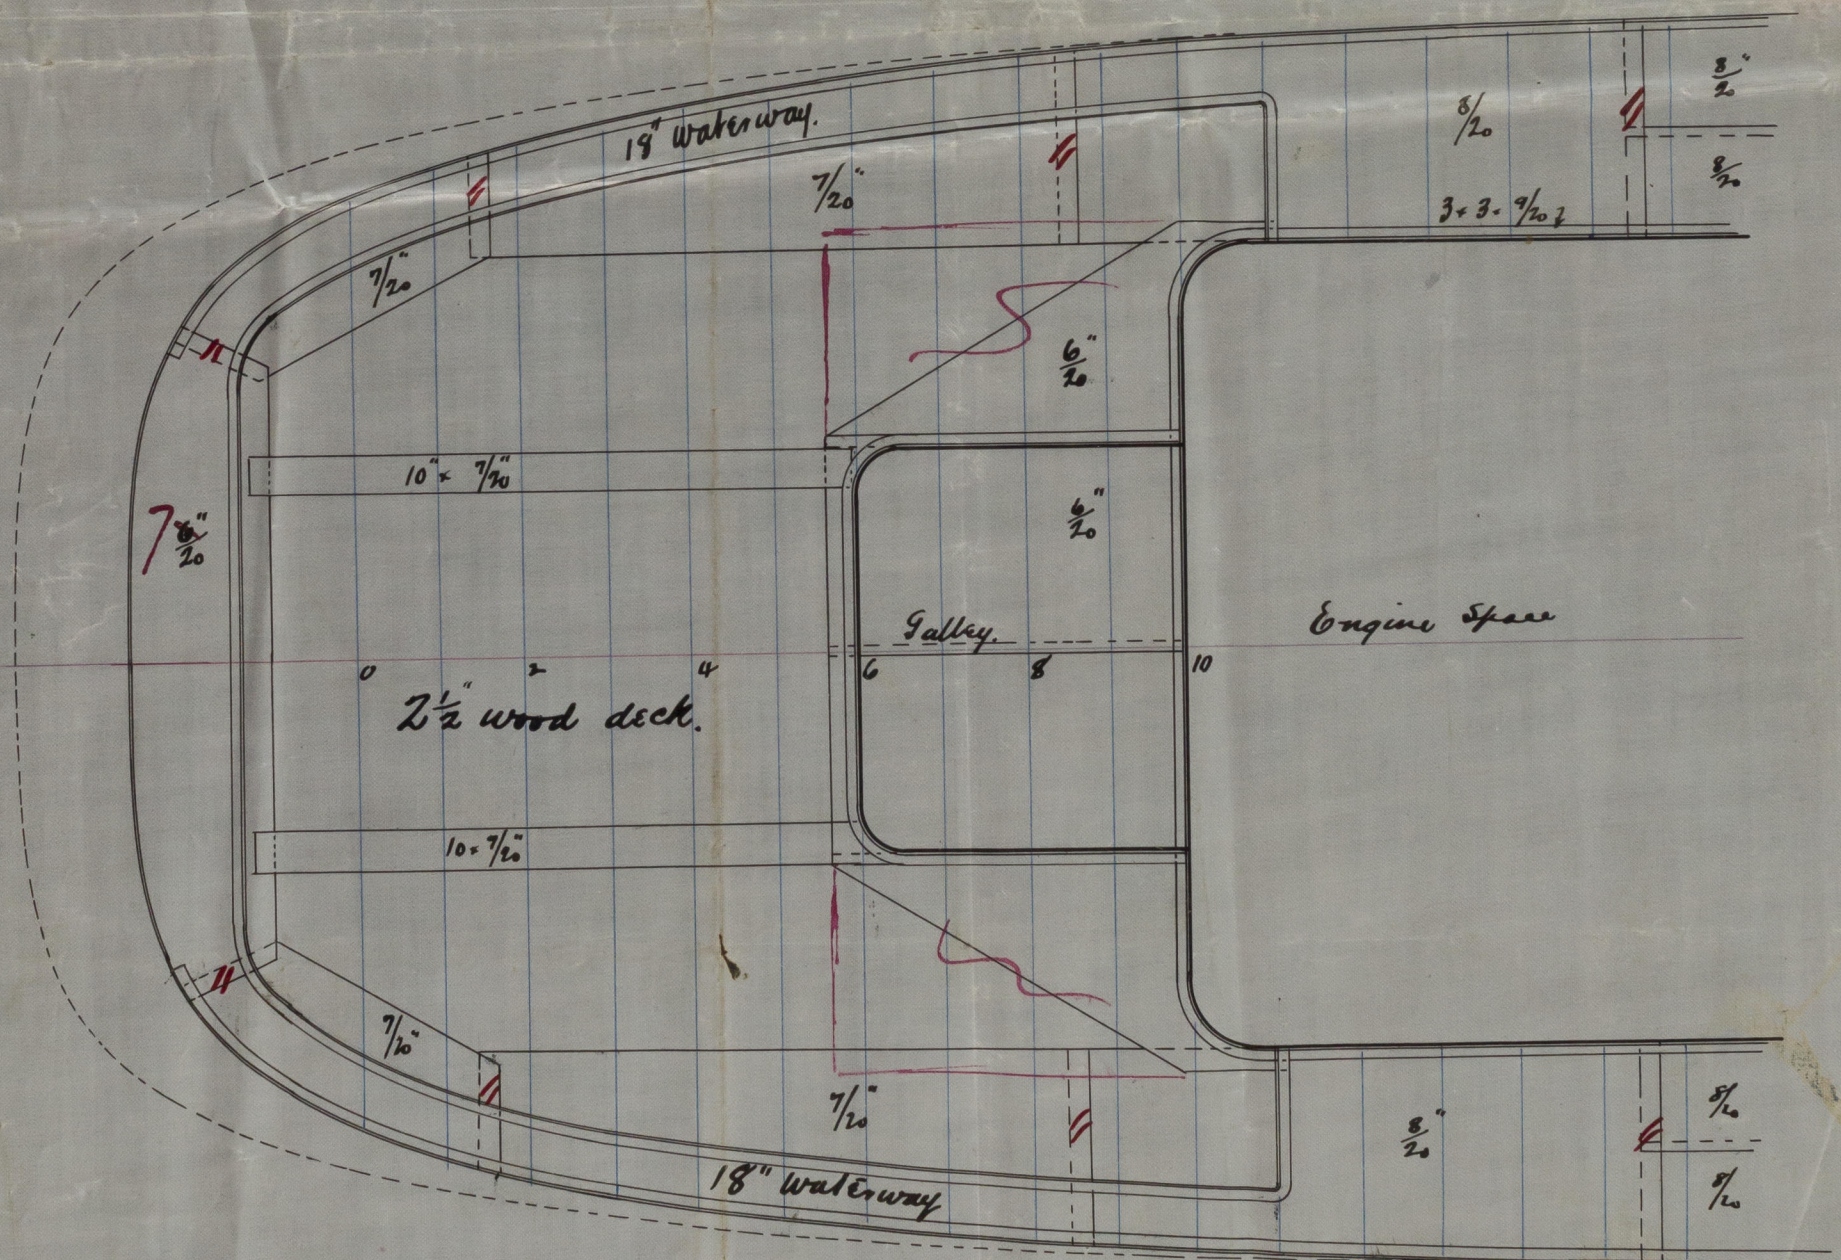

Modified arrangement of deck opening



© 2020

Lloyd's Register
Foundation

002062-002070-0185