
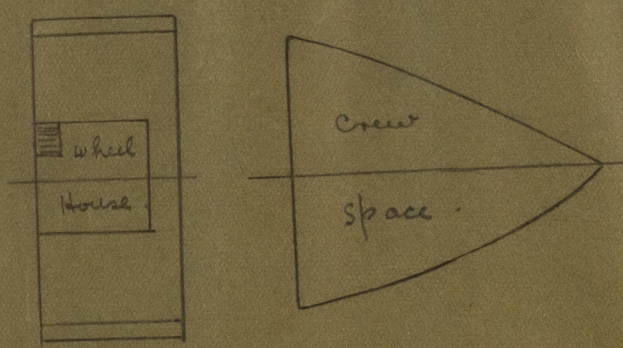
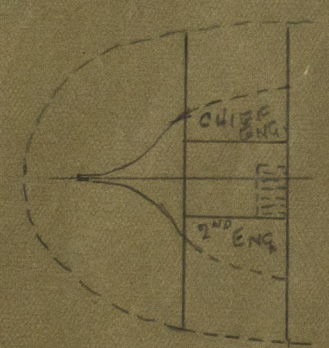
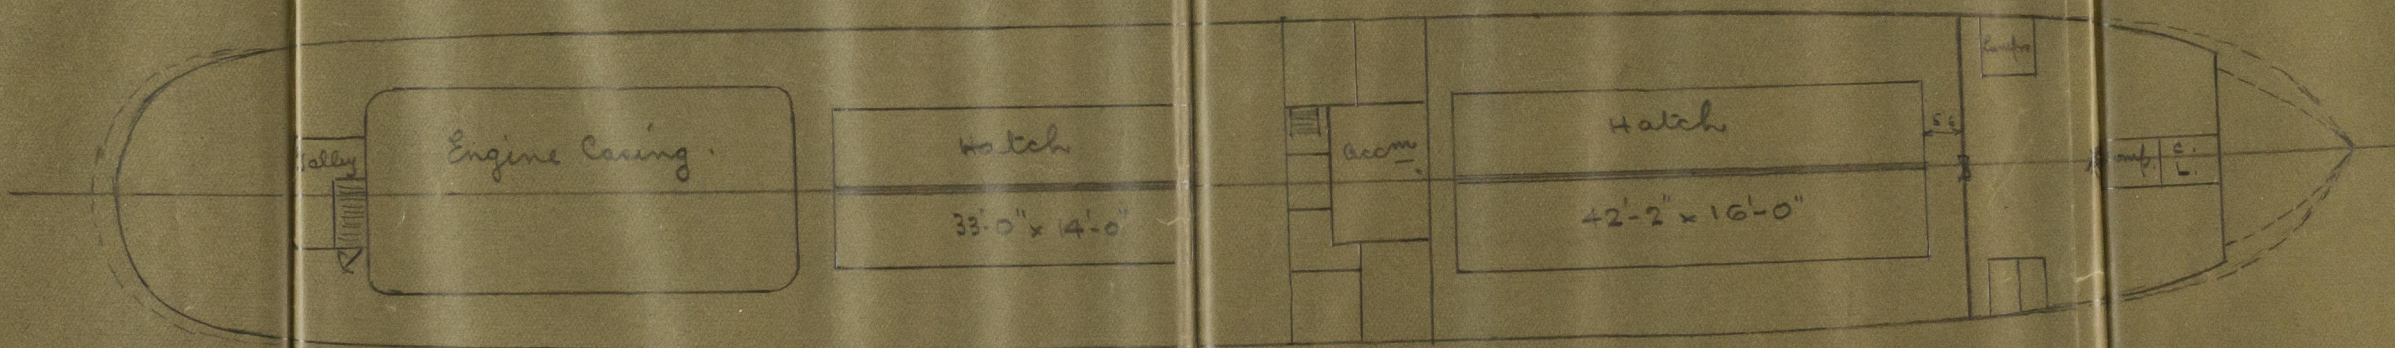


Lead from Blue print recd. from
Belfast 7/11/33

GENERAL ARRGT.
S.S. KATHLEEN

BELFAST NOV. 1933

S.S. "KATHLEEN"
Dims. 200'-0" x 13'-4" x 12'-0"
12'-3"
Scale 1/8" IN. = 1 FT.

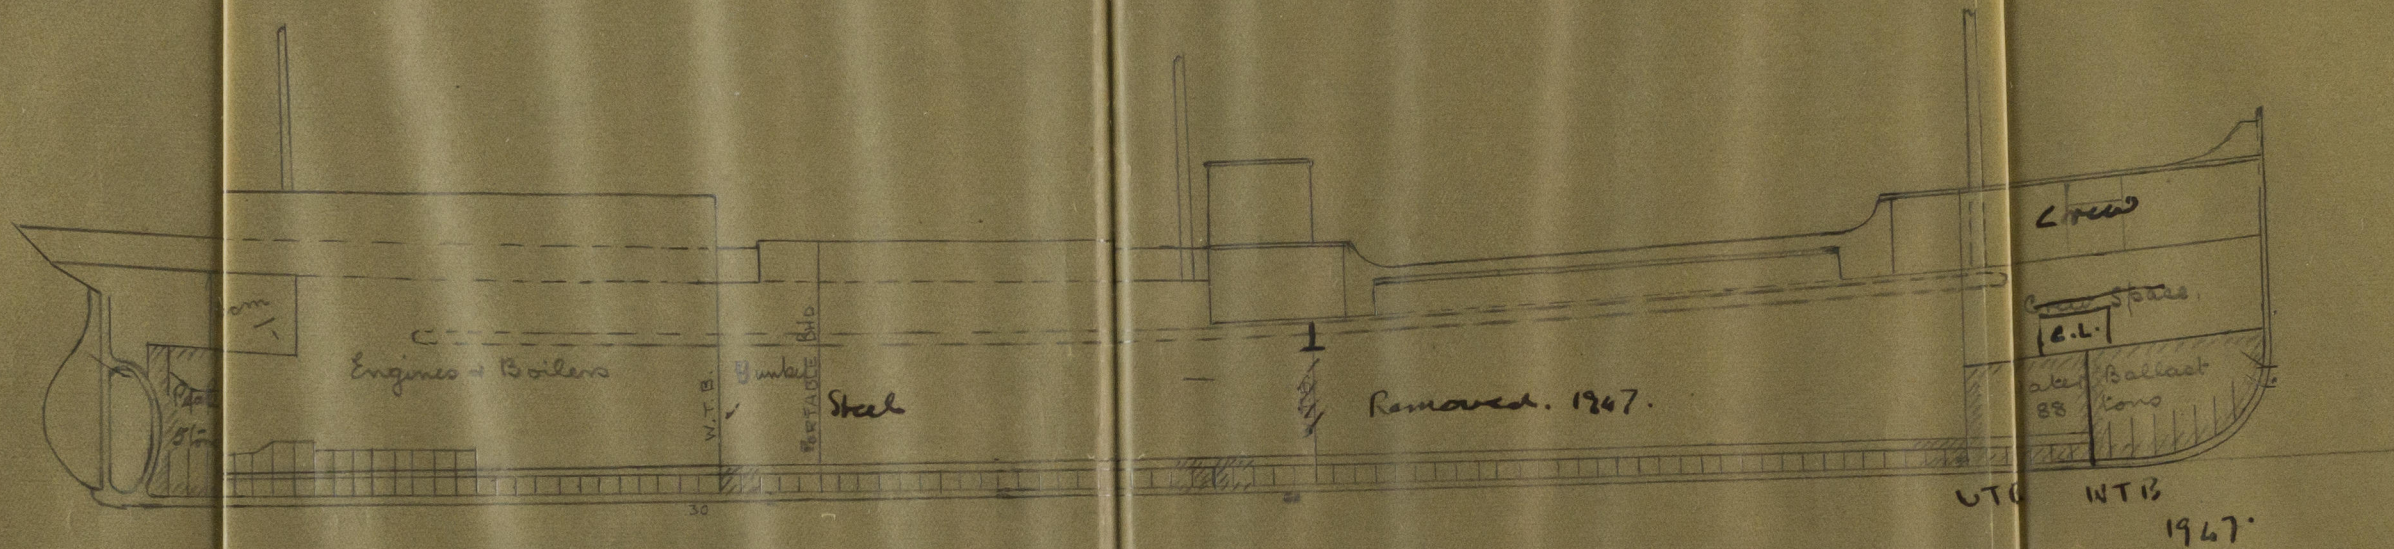


3/.

GENERAL ARRG'T.

2/3 KATHLEEN

BELFAST. NOV. 1933.

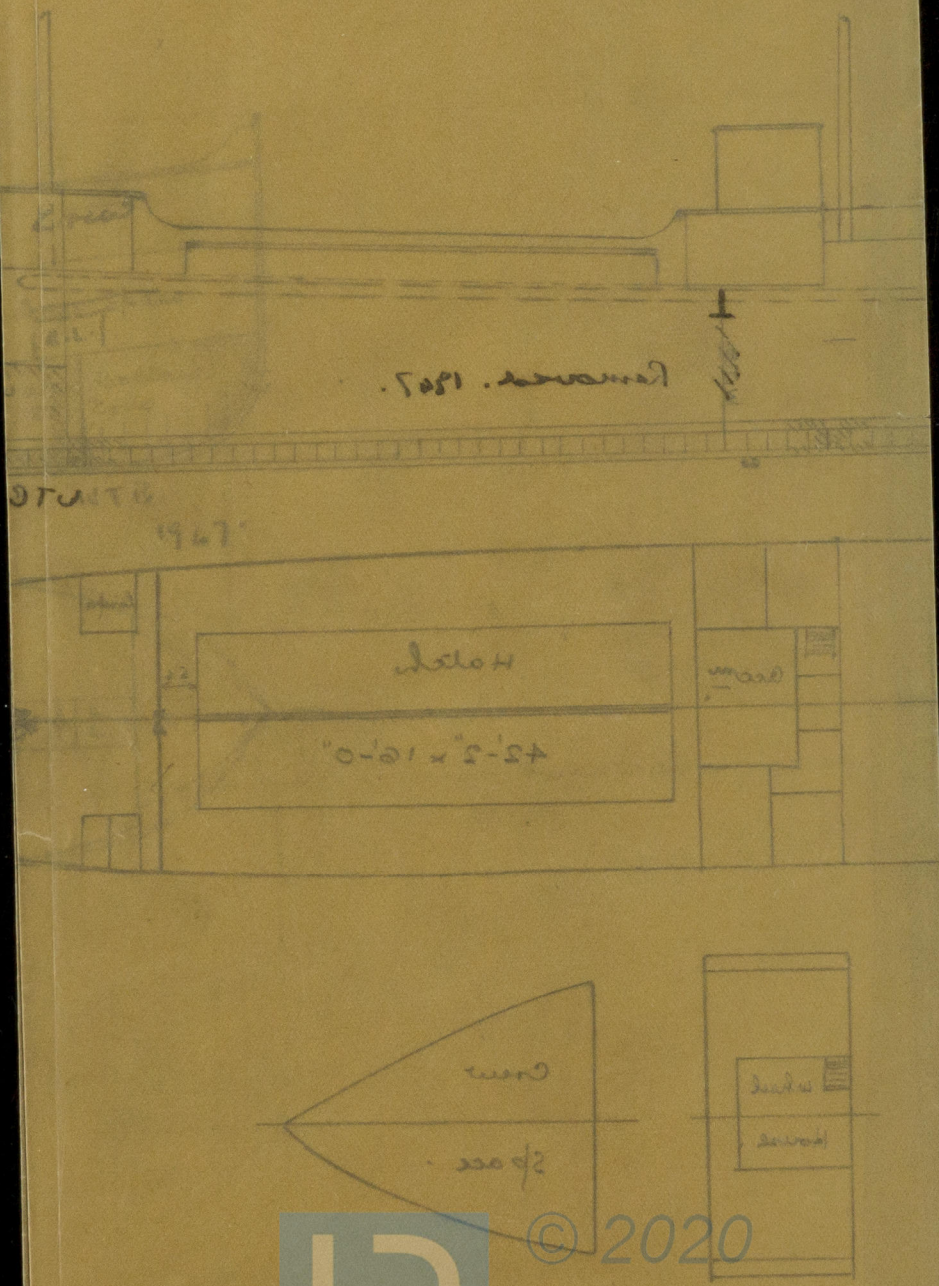

© 2020

Lloyd's Register
Foundation