



London Stamp
29/1/19

L.L. 11. 34.5
Profile and Deck Plans
Scale 1/8" = 1' 0"
10 Class 1000 H.P. 1st Light
Dimensions 112' 6" L x 36' 0" B. 2nd L x 36' 0" B. 3rd L x 36' 0" B. 4th L x 36' 0" B.

 


Deckboard Particulars		Length of Deckboards	
Length on Load Line	421' 6"	Port Side	22' 0"
Starboard	110'	Starboard Side	20' 0"
1st Light	24'	Vale Side	25' 0"
2nd Light	24'		
3rd Light	24'		
4th Light	24'		

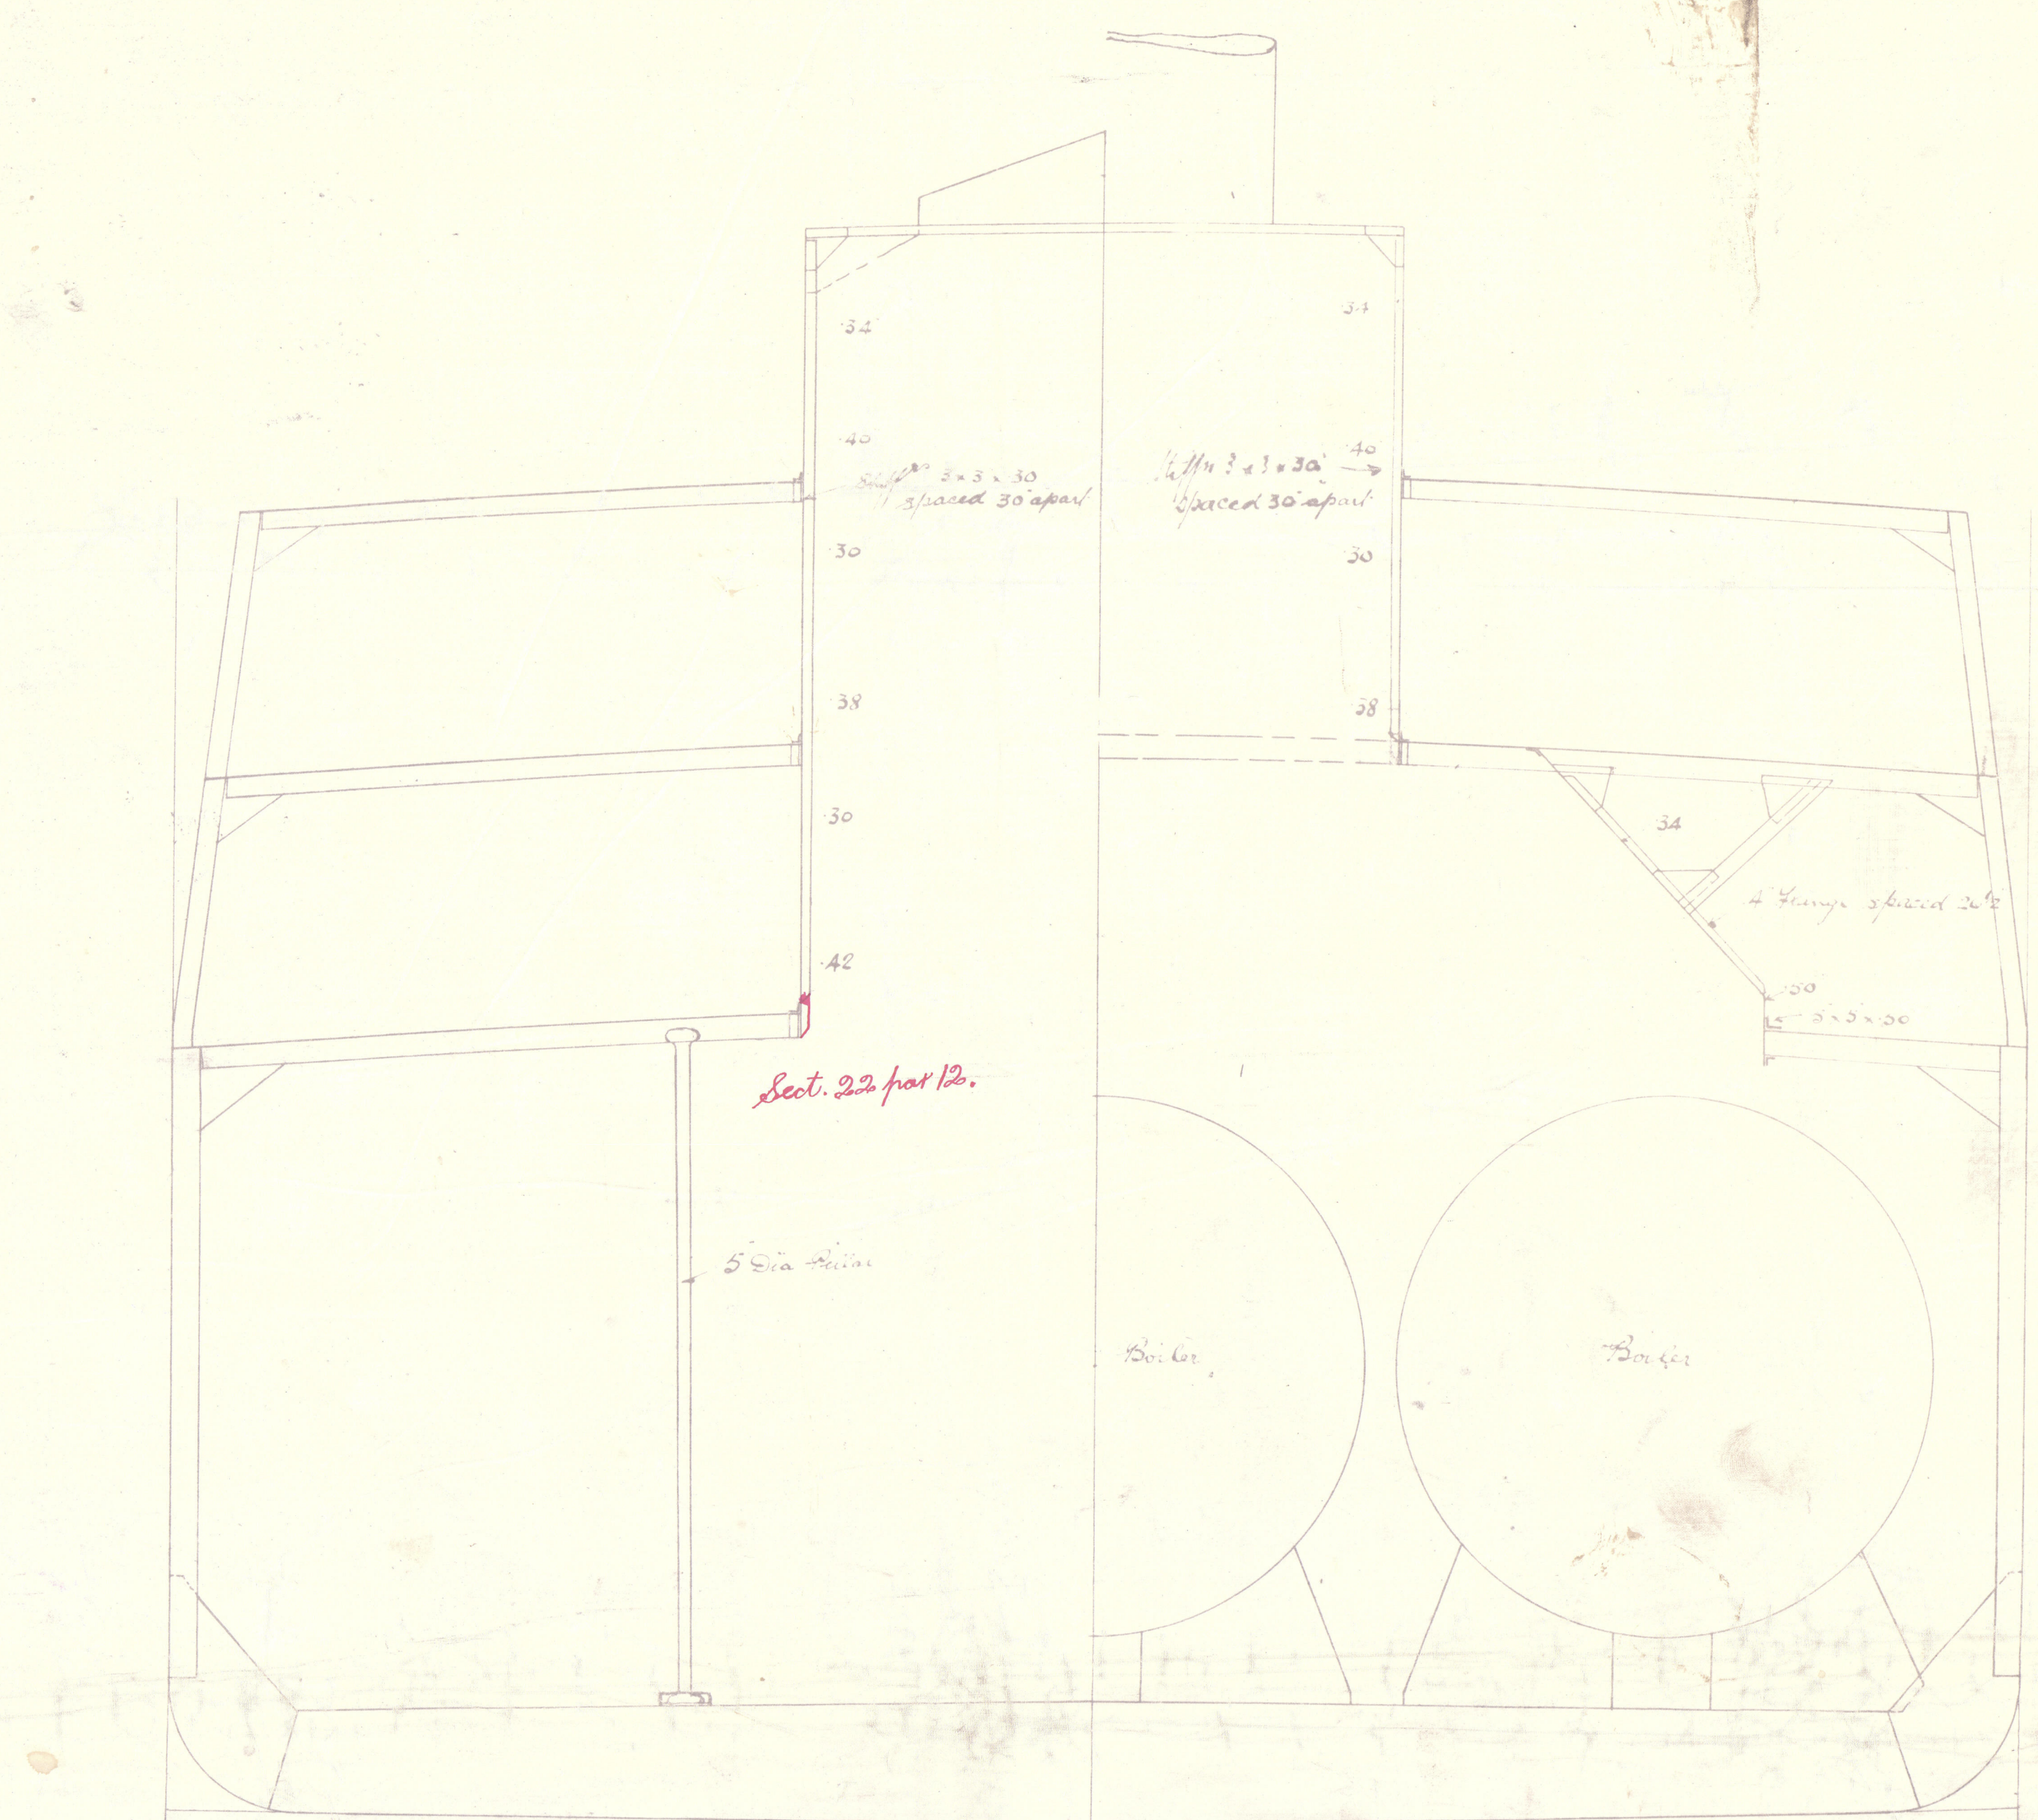

Attention in Blue as
ship is actually built.

Note:- Detailed Plans of W.T. & O.T.
Bldg, Deck Girders & 1st Line
Bld also Decking & Hatchco
to be submitted.

 

Signed
28/1/19

Profile and deck plans
Messrs Robert Duncan & Co^{rs}

No. 345. "MAFUTÄ" EX N.N. JARAMA
S.S. "Ronald" EX

Greenock Kpt. No. 17681

002071-002078-0095



© 2020

Lloyd's Register
Foundation