



Do all the Frames extend to the top height in the Poop? Yes Raised Quarter Deck? Yes Bridge House? Yes Forecastle? Yes  
 To what height do the Reverse Frames extend? B.A. frames  
 Has the Poop on Raised Quarter Deck an efficient Iron Bulkhead at the fore end? Yes  
 Give particulars of the means for closing the openings in Bulkhead Storm boards to full height in riveted channels  
 Is the Poop on Raised Quarter Deck connected with the Bridge House? No Has the Bridge House an efficient Bulkhead at the fore end? Yes  
 Give particulars of the means for closing the openings in Bulkhead Storm boards to full height in riveted channels  
 What is the thickness of the Bridge Front plating? 30 and Coaming plate? ✓  
 Give scantlings and spacing of the Stiffeners 4" flanges spaced 34" apart  
 Are bracket plates fitted at each end of the Stiffeners? No Are hor'l. brackets fitted connecting Bridge Bulk'd. with Bulwarks? No  
 Has the Bridge House an efficient Iron Bulkhead at the after end? Yes  
 How are the openings closed? Stormboards to half height in riveted channels  
 Is the Forecastle at least as high as the main or top-gallant rail? Yes Has the Forecastle an efficient Iron or Wood Bulk'd. at after end? No  
 Are the Engine and Boiler openings covered by a Bridge, Poop, Raised Quarter Deck, or enclosed by a Strong Iron or Steel Deckhouse? Bridge  
 If the openings are not so protected are the exposed parts of the Casings efficiently constructed? ✓  
 Give thickness of plating; scantlings and spac  
 What is the height of the exposed Casings? ✓  
 Are the Weather Deck Hatchways efficiently, requirements of Section 28 of the Rules for

Sizes of Hatches same and number of beams as for main deck.

Position and Size.		No. 1. 16'-11 1/2" x 11'	
Item.		Ship.	F.
COAMING.	Height above top of DECK	30	✓
	Thickness	Sides	.44
		Ends	.40
SHIFTING BEAMS OR WEB PLATES.	Number	3x3x.40 3	
	Section and Scantlings	2 T 16"x.34 1 T 16"x.44	
	Material	1 T 11"x6 1/2"x.54	
* FORE AND AFTERS.	Number		
	Section and Scantlings		
	Material		
HATCHES Thickness		3"	
Remarks			

Coaming Height	Upper Deck.	Shade Deck
	30"	6"
" & thickness sides	.44	.44
" " " ends	.40	.40
Shifting Beams	3x3x.40 20" x .34 T 11"x6 1/2	3x3x.40 14"x.34 T 11"x6
Hatches	3"	3"


\* T  
(If the sill o  
tables, state vertical dis

The following information is to be given in the following tables, state vertical dis  
002079-002084-0040 2/2

What is the thickness of the Bridge Sheerstrake? \_\_\_\_\_ Strake between Main and Bridge Sheerstrakes? \_\_\_\_\_  
 Delete the words that do not apply { The Crew are, are not, berthed in the bridge house.  
 { The arrangements to enable them to get backwards and forwards from their quarters are, are not satisfactory.  
 Length of Bulwarks in well \_\_\_\_\_  
 Area of Freeing Ports required by Para. 11 (e) each side of vessel = \_\_\_\_\_ Sq. ft.  

Ft. Tenths.	Ft. Tenths.	No.	} Freeing Ports (each side of vessel) = _____ Sq. ft.
x	x	x	
x	x	x	

 Total deficiency or excess = \_\_\_\_\_ Sq. ft.

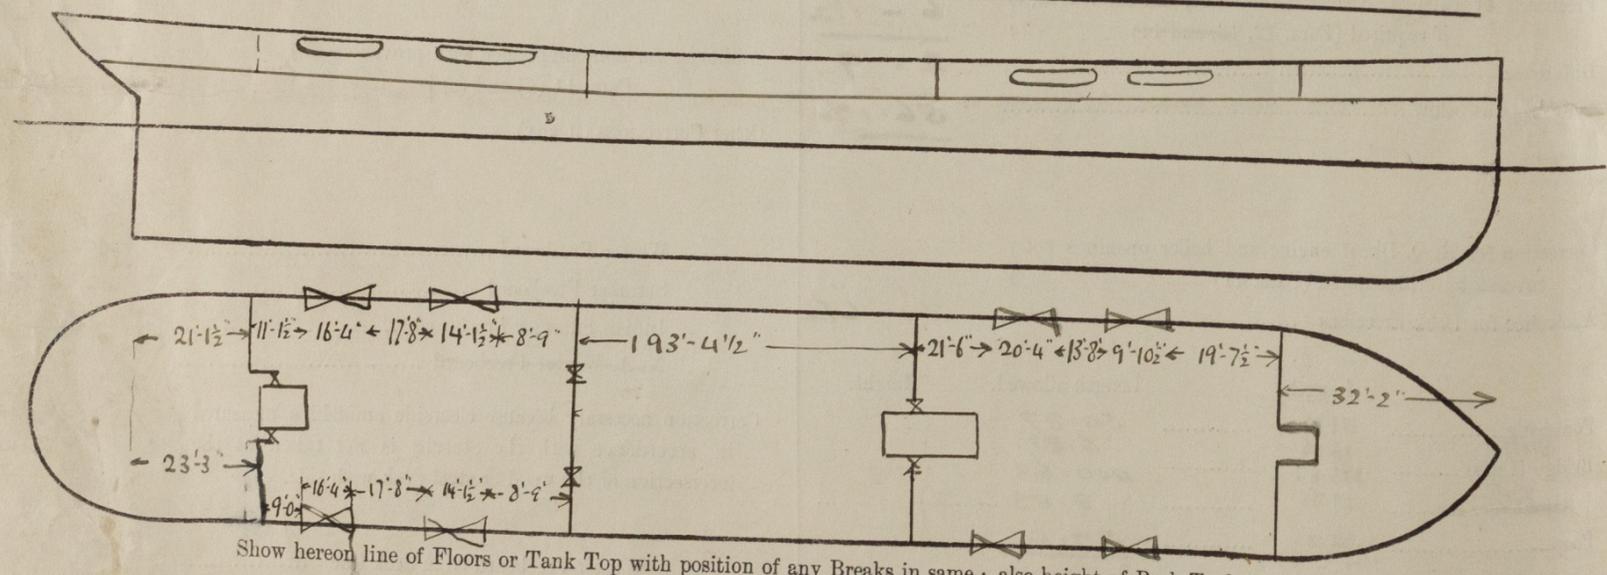

Show hereon line of Floors or Tank Top with position of any Breaks in same; also height of Peak Tank tops, &c., &c.  
 State any special features in the construction of the Vessel \_\_\_\_\_  
 Builder's name and yard number \_\_\_\_\_  
 Names of sister vessels \_\_\_\_\_  
 Owners \_\_\_\_\_

Address \_\_\_\_\_  
 Fee Rupees 150/-

Received by me \_\_\_\_\_

