

24 MAY 1945

Index No.

Lloyd's Register of Shipping.

Ship's Name

ASCANIA

Official No.


147307

Memorandum of alterations reported since ship was surveyed for assignment of Load Lines in February 1943

① One 12" x 6" Ventilator B.D. found at Fore End No. 1 Hatchway, Starboard, Coaming 36" high x. 38", to B/c Tween Decks, Unishroom Top, Canvas Cover.

② 7" diam. Vact. 36" Coaming x. 38" from Galley in B/c Tween Decks, thus

Wood Plug + Canvas Cover

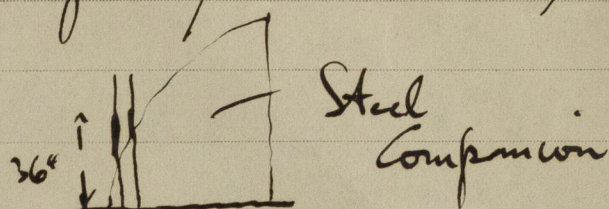

③ 24" x 14" Vact. on C Deck aft- PORT abreast Hatchway - 24" Coaming x. 34" (stiffened). Weather-tight Steel Closing, Mechanical Closing

James S. Ominston
12 MAY 1945
BARROW

Noted
J.S.O.



© 2020

Lloyd's Register
Foundation