



Scale $\frac{1}{4}$ Inch = 1 Foot.

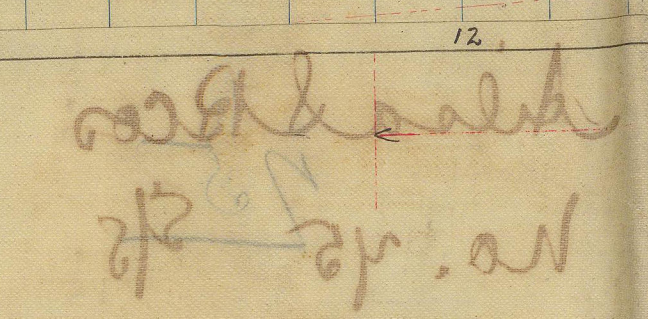

ALL REVERSE FRAMES TO QUARTER DECK. ✓

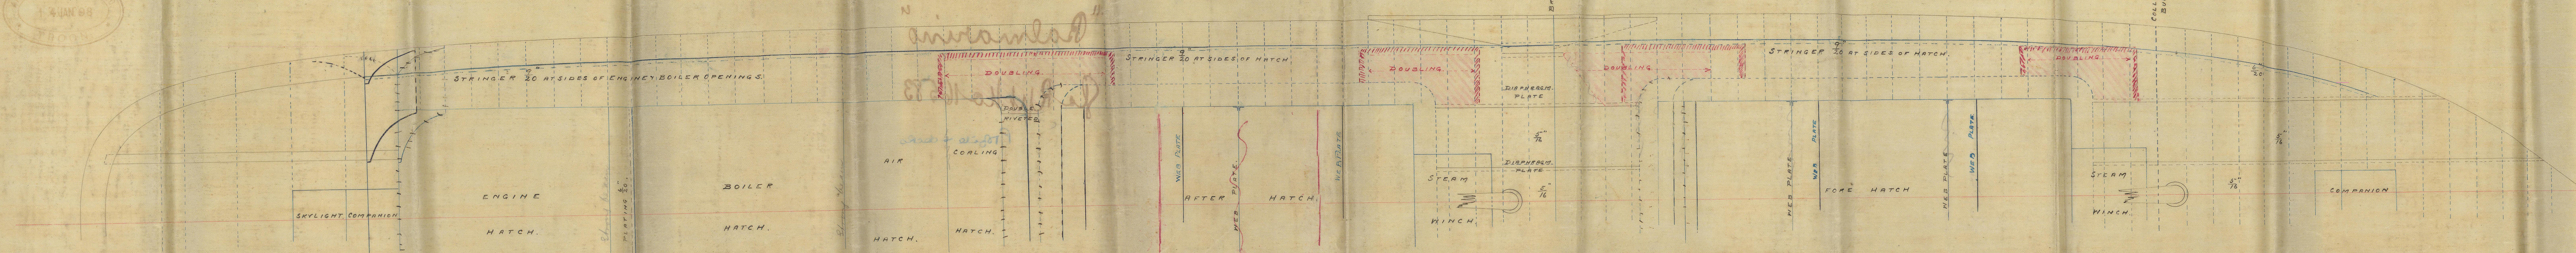

201/98

Alca & Pcos

no. 45 ⁷⁵ 5/8

" " Palmarino

Se Rpt. No 16583

Pt file - deck

PHI 3003

HATCH

HATCH



© 2020

Lloyd's Register
Foundation

002079-002084-0230