


· *PROFILE & DECKS* · *SHIP N° 140* ·


· TO LLOYDS CLASSIFICATION + 100 A.I. ·

• SCALE $\frac{1}{8}" = \text{ONE FOOT.}$

1/4" SCALE SECTIONS THRO' DOUBLE BOTTOM

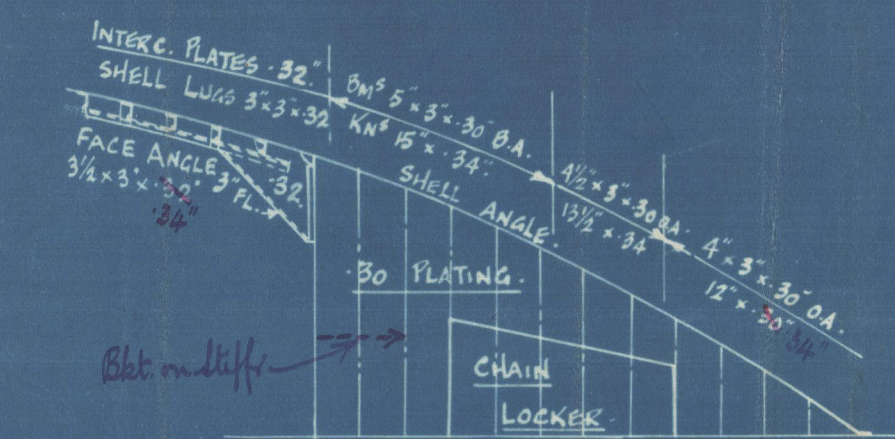

PLAN OF W.T. FLAT.

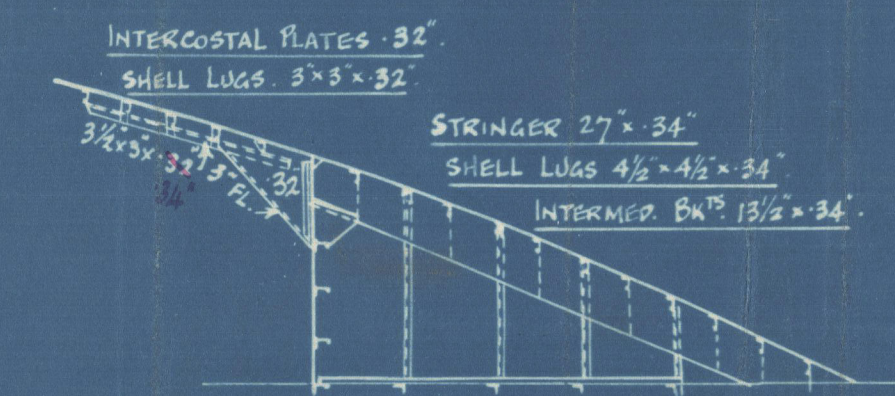

PLAN OF STRINGER

PLAN OF STRENGTHENING OF DOUBLE BOTTOM FOR^D OF $\frac{3}{5}$ LENGTH

TANK BOTTOM FRAMES 5" x 5" x 31" DOUBLE RIVETED TO SHELL 5/8" DIA. APART & TO FLOOR @ 6-11 DIA. APART.
MIDSHIP THICKNESS .40 OF A & B. STRAKES OF SHELL MAINTAINED FW^D ON FLAT OF BOTTOM TO RULE POSITION OF COLLISION BN^D.

PLAN OF FILE DK

BEAMS $5\frac{1}{4} \times 3 \times 30$ BA


See separate plan
of scarping area

S/S 140

Lloyds approved
Profile & Deck Plan

40

002085-002093-0001

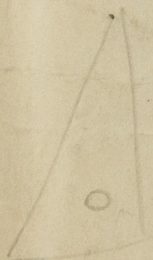

© 2021

Lloyd's Register
Foundation

MEERS BURNTISLAND S.B.
N^o 140

PROFILE & DECKS

S.S. "CALEDON"
LTH. 17191.

140

Lloyd's Register
Approved
Profile & Decks

002085-002093-0001