

23.12.29

N^o 543. MIDSHIP SECTION.

EQUIPMENT.

- ✓ 1 STOCKLESS ANCHOR 8 1/2 CWTs
- ✓ 1 RODGERS " 34" EX STOCK
- ✓ 120 FATHOMS 1 1/2" STUD LINK CHAIN
- ✓ 60 " 6" HAWSER
- ✓ 60 " 5" WARP

SCALE 1/2" = 1 FT.


DIMENSIONS:- 140'-0" BP x 24'-6" MLD. x 14'-0" MLD

TO CLASS LLOYDS:- 100 A.1. "STEAM TRAWLER".

LLOYDS NUMERALS

L&D	1960
Lx(B+D)	1390
D	14.0
B+D	38.5

PROPORTIONS	1/2" 10
	1/4" 5 1/2
	1/8" 12 1/2

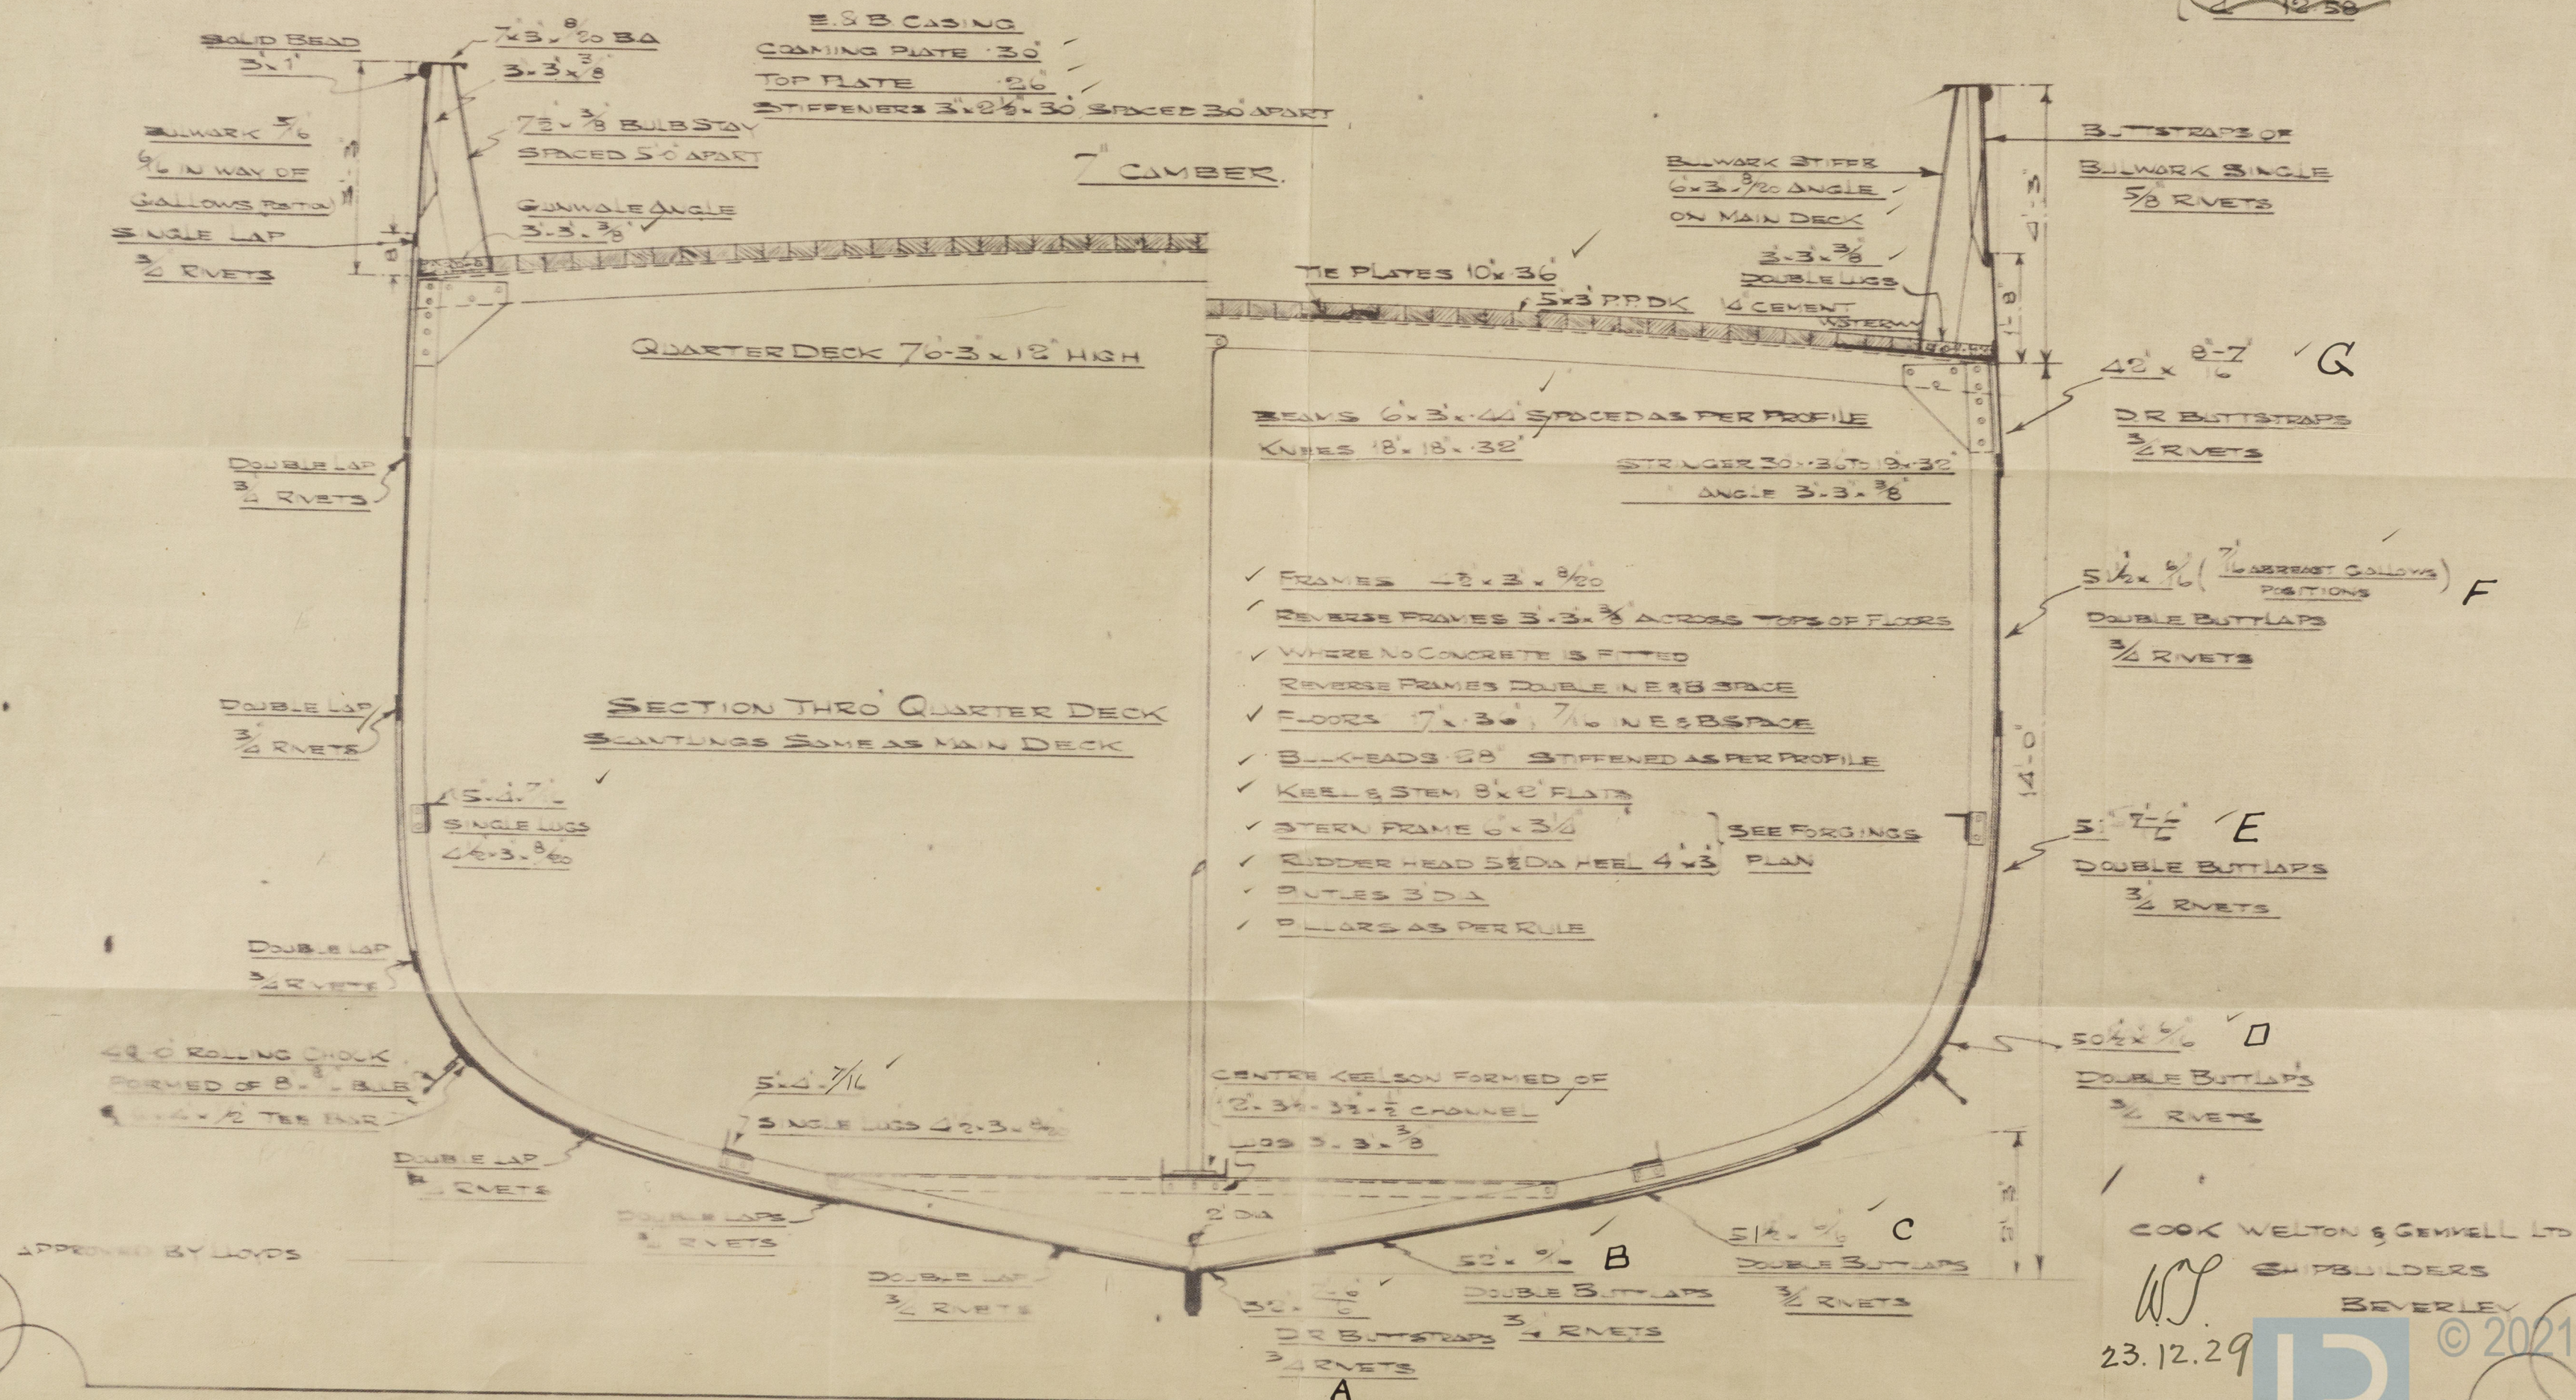

Cook, Welton & Gemmell, Ltd.,
Beverley

Huddsliip Section
No. 543

"Malmata"

S.S.

WILL REPORT NO.

210415 48d.

S.S.

"Malmata"

WILL REPORT NO.

210482

Gregory



© 2021

Lloyd's Register
Foundation

002085-002093-0255