

Lloyd's Register of Shipping.

Ship's Name



"PAULA VOGELSANG"

Official No. 145502.

of GLASGOW.

Memorandum of alterations reported since ship was surveyed for assignment of Load Lines
in Gothenburg. 14th August 1933.

Hood structure on poop was extended forward to just abaft capstan which, as shown in outline sketch below, to form new deck house for additional accommodation, found necessary on the occasion of the vessel reverting to British Registry and Ownership.

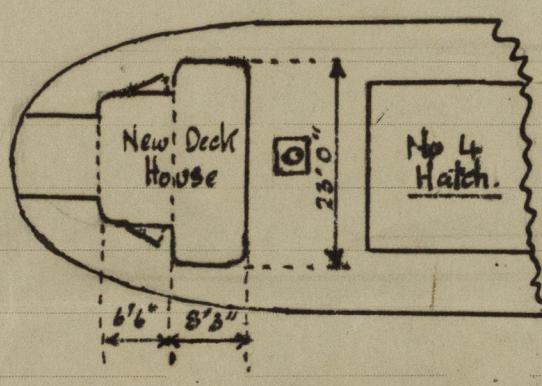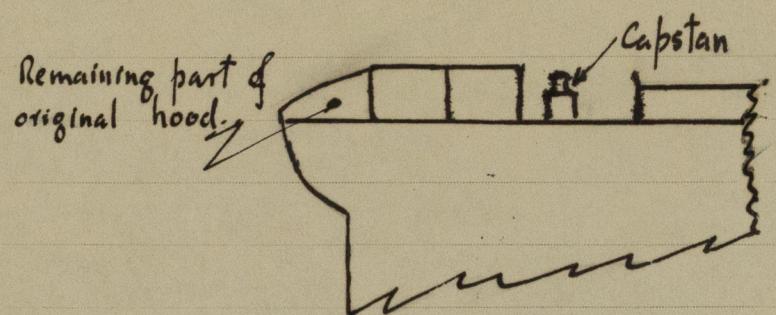

3 new sanitary discharge pipes fitted from W.C. & wash places in the new accommodation steer.

Pipes led overboard and fitted with N.R. type scupper valves at ship-side inside A.P. tank spaces.

1 - 3½" & 1-2" on s.s.

1 - 2½" on p.s.

The accommodation access doors shown, p. & s., are constructed of $\frac{1}{2}$ " thick Hardwood and fitted with spring catchers & handles, operable from both sides.

J. Manser
ANTWERP 30/9/55

N.B. Copy of above placed aboard vessel.

J.M.

Note
AR.
7-10-55