

31076.

# Lloyd's Register of Shipping.

29 APR 1952


Ship's Name "JULIET DUFF"

Official No. 147573

Memorandum of alterations reported since ship was surveyed for assignment of Load Lines in \_\_\_\_\_

ALTERATION

A hatch of substantial construction now fitted over stokehold aft of funnel as detailed in sketch below:-

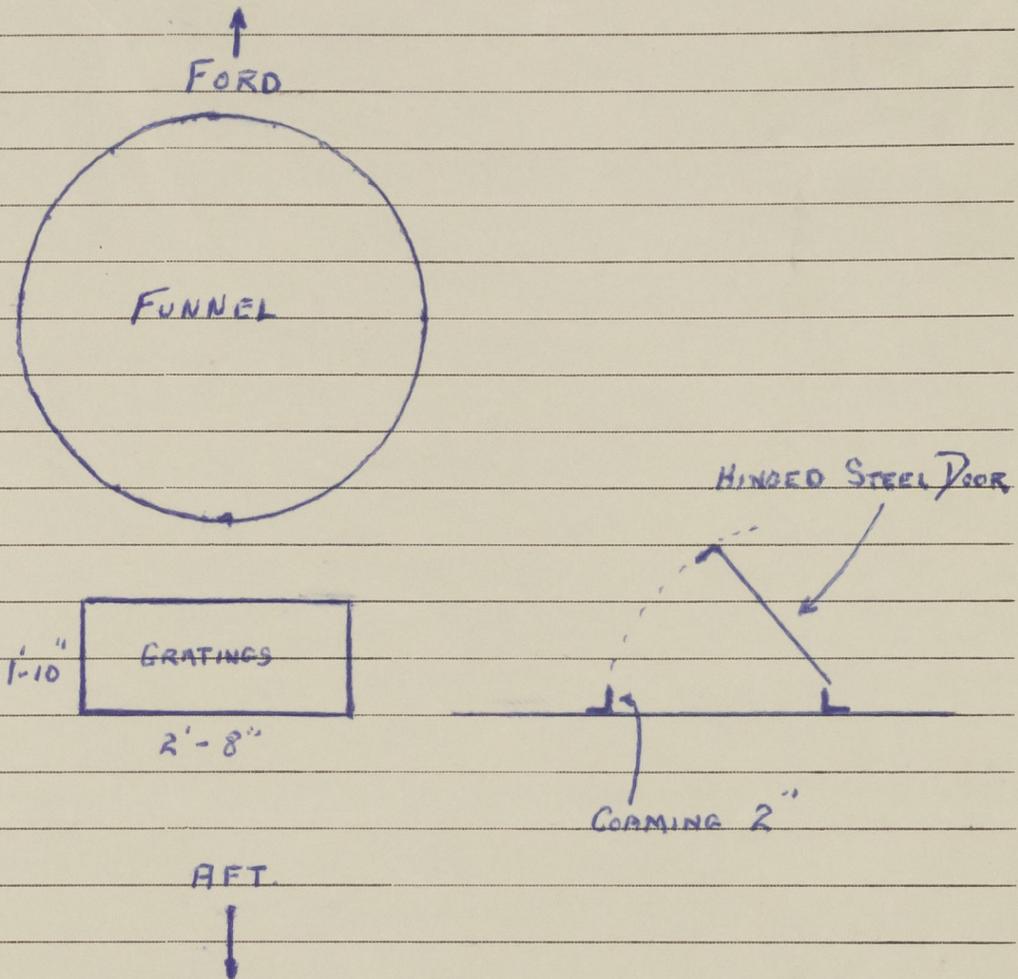

James H. Smyth

Copy of above placed on board vessel.

*[Signature]*

12/11/52

