



Lloyd's Register of Shipping

(Report on Vessel No. 39418 Port Hull)

No. F. 20122 SHIP FORGINGS OR CASTINGS.

I have to report that the undermentioned Iron or Steel Forgings or Castings, manufactured by Messrs Emerson Walker Ltd. of Dunston-on-Tyne for the Vessel No. 1028, being built by Messrs Cochran & Son of Selby have been inspected by me as set forth below and found to be, so far as can be seen, Sound

The notes entered on this page are to be struck out as may be required.


Mark on Forgings or Castings.

Lloyd's
No. 8034
JD
22-6-28


J Dale
Newcastle

	STERN FRAME.	RUDDER FRAME.	STEM.
Material* ...	<u>Scrap iron</u>		
How made † ...	<u>Forged & Smelted</u>		
Dimensions ...	<u>6 x 3 1/4</u>		
Progress on Inspection ...	<u>Forging & Smelting</u>		
Date when Inspected ...	<u>22-6-28</u>		
CASTINGS.			
Tests on Standard Test Pieces.			
Tensile Test—			
Tons per square inch ...			
Extension per cent. ...			
Cold Bending Test—			
Angle before fracture ...			
Drop Test—			
Height from ground ...			
Hammering Test—			
If made according to Rules and found satisfactory ...			

SKETCHES OF FRAMES SHOWING POSITION AND DESCRIPTION OF WELDS OF FORGINGS.

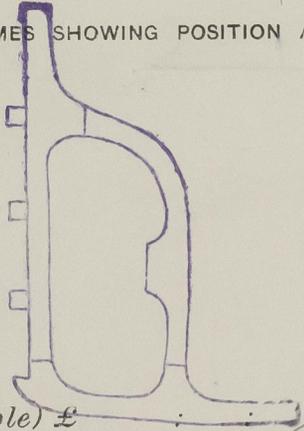

Fee (if any chargeable) £
To be paid at

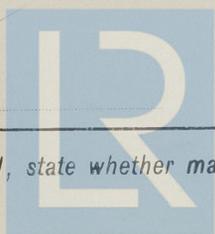

© 2020

Lloyd's Register Foundation

* If of Iron, state whether scrap or puddled Iron. If of Steel, state whether made on the Open Hearth process.

† State if annealed