

Office Copy

AFTER BULWARK

LENGTH = 159'-4"
RAILS 17', EQUIV. TO 34'-0"
REMAINDER OF BULW. 125'-4"

125.33 x 3.5' HIGH x 25% = 109.67 ϕ PORTS REQUIRED
FREEING PORTS 5 (OLD) @ 4' x 1'-9" = 5 @ 7 ϕ = 35.00 ϕ
1 (OLD) @ 1'-3" x 1'-3" = 1.56 ϕ
11 (NEW) @ 3'-10" x 1'-9" = 11 @ 67 ϕ = 73.70 ϕ


TOTAL AREA OF FREEING PORTS } 110.26 ϕ
1.56
108.70

FORWARD BULWARK

LENGTH = 82'-7 1/2"
RAILS 17', EQUIV. TO 34'-0"
REMAINDER OF BULW. 48'-7 1/2"

48.62 x 3.5' HIGH x 25% = 42.54 ϕ PORTS REQ.
FREEING PORTS 3 (OLD) @ 4' x 1'-9" = 3 @ 7 ϕ = 21.00 ϕ
1 (OLD) @ 1'-3" x 1'-3" = 1.56 ϕ
3 (NEW) @ 3'-10" x 1'-9" = 3 @ 67 ϕ = 20.10 ϕ

TOTAL AREA OF FREEING PORTS 42.66 ϕ
1.56
40.90

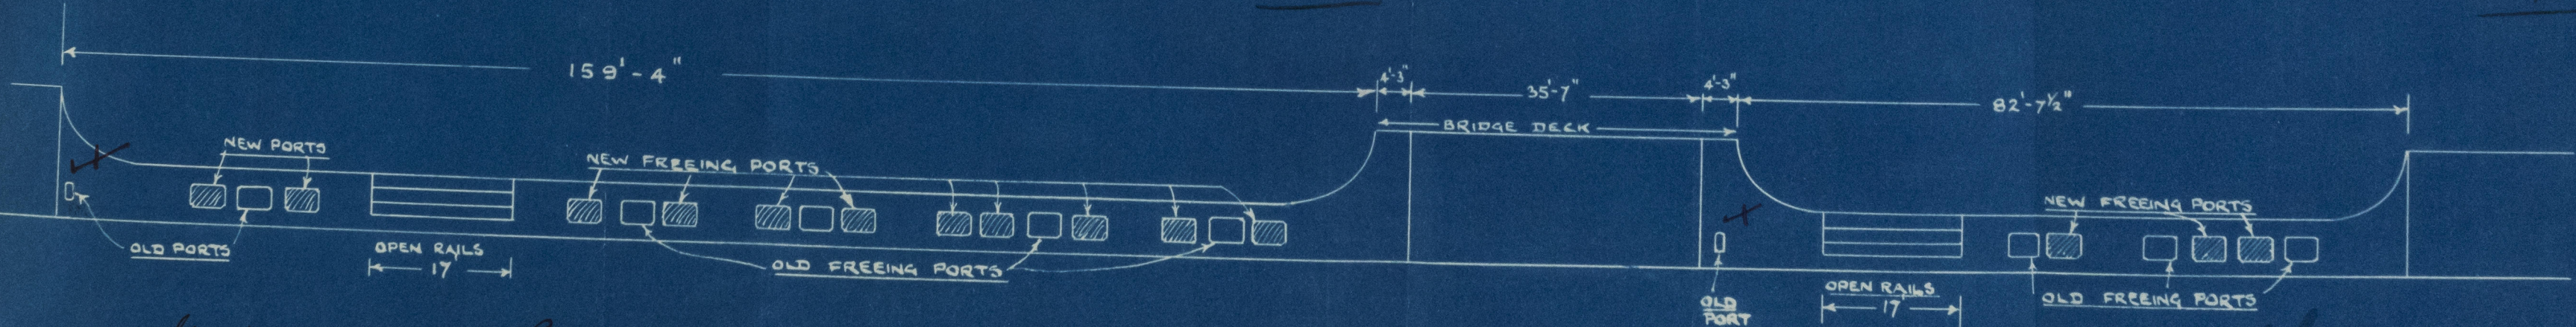

** It is assumed that these are freeing ports and not mooring pipes*

M.V. "CLYDEFIELD"

PROPOSED ADDITIONAL FREEING PORT AREA.

1-2-32



Freeboards compared and found correct by B.W.B. Date 29-6-28

Is fee paid? Form for Certificate A

002101-002108-0144

FREEBOARD VERIFICATION FORM FOR STEAMERS.

WIN 192

835

ye
Im

top o
v, assi
sel's s

$\frac{1}{2}$

$\frac{3}{4}$

deck.

show

rveyo

9

2

0

9



© 2020

Lloyd's Register
Foundation

002101-002108-0144

Freeboards e

Form for Certificate

Date

A