


FR 109
FR 110
FR 111
FR 112
FR 113
FR 114
FR 115

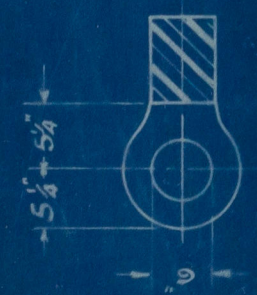

PLAN VIEW OF GUDGEON.




GUDGEON WITH STOPPER.

copy approved

HULLS No 162-163 & 165			
STERN FRAME.			
<i>St. "Warta" in "Tutul"</i>			
Great Lakes Engineering Works.			
DETROIT, MICH.		HULL DEPT.	
Drawn by	O.B.	Checked by	<i>A.B.</i>
Transd by		Scale	$\frac{3}{4}" = 1' \text{ Foot}$
		Date	<i>April-12</i>

BASE LINE 1 1/2" ABOVE BOTTOM OF POST.

00227-002167-0022

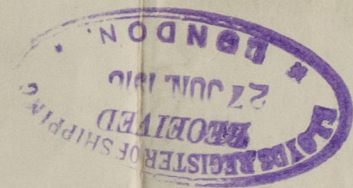

ss. *Junel*



002127-002137-0088



© 2020
Lloyd's Register
Foundation